

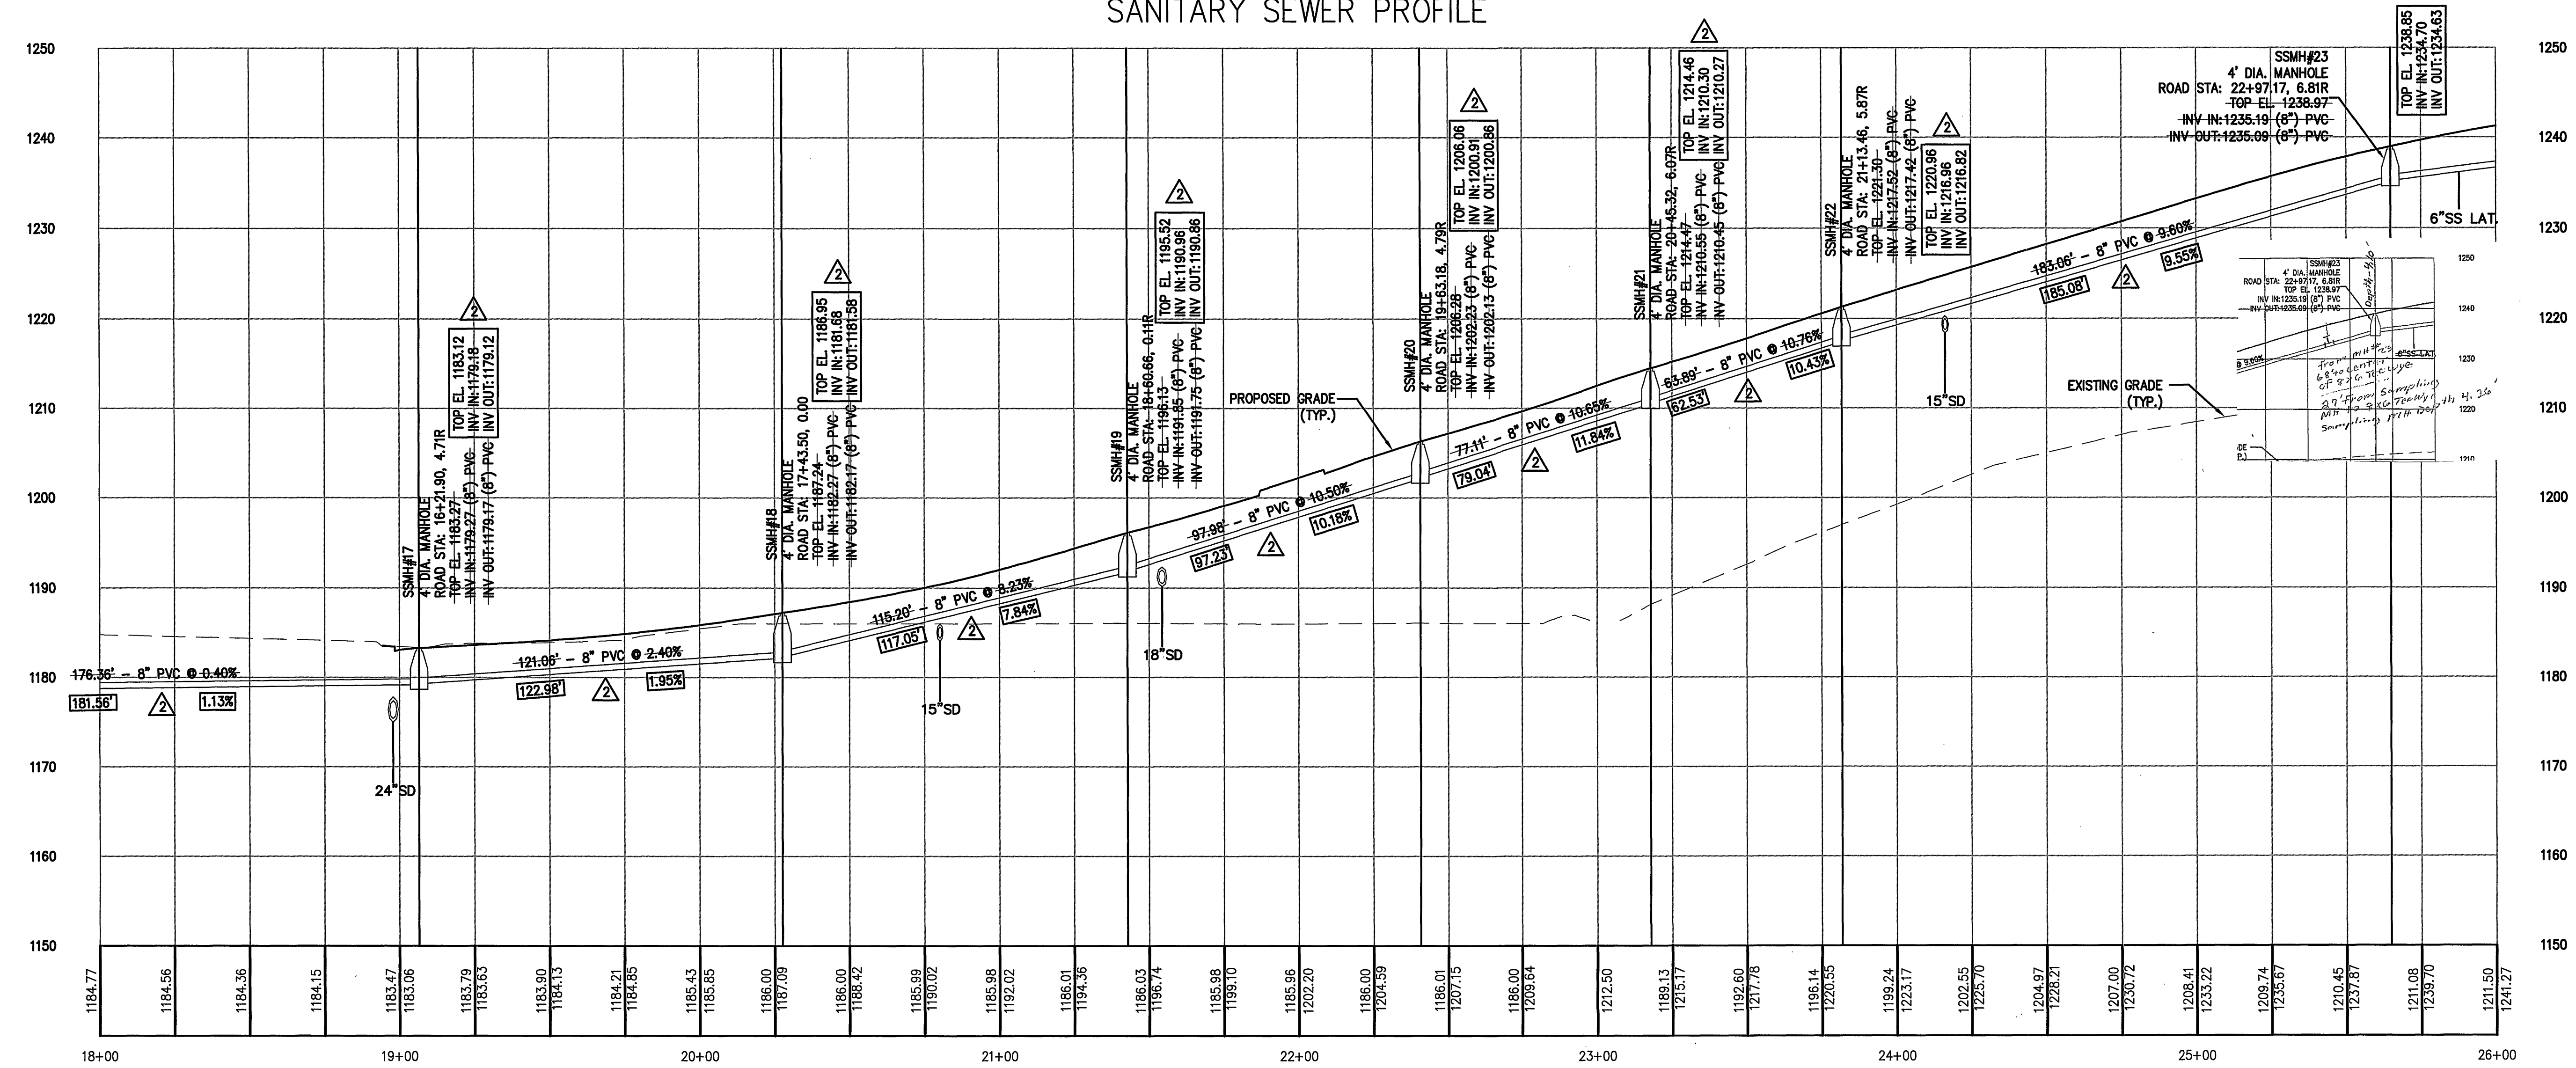
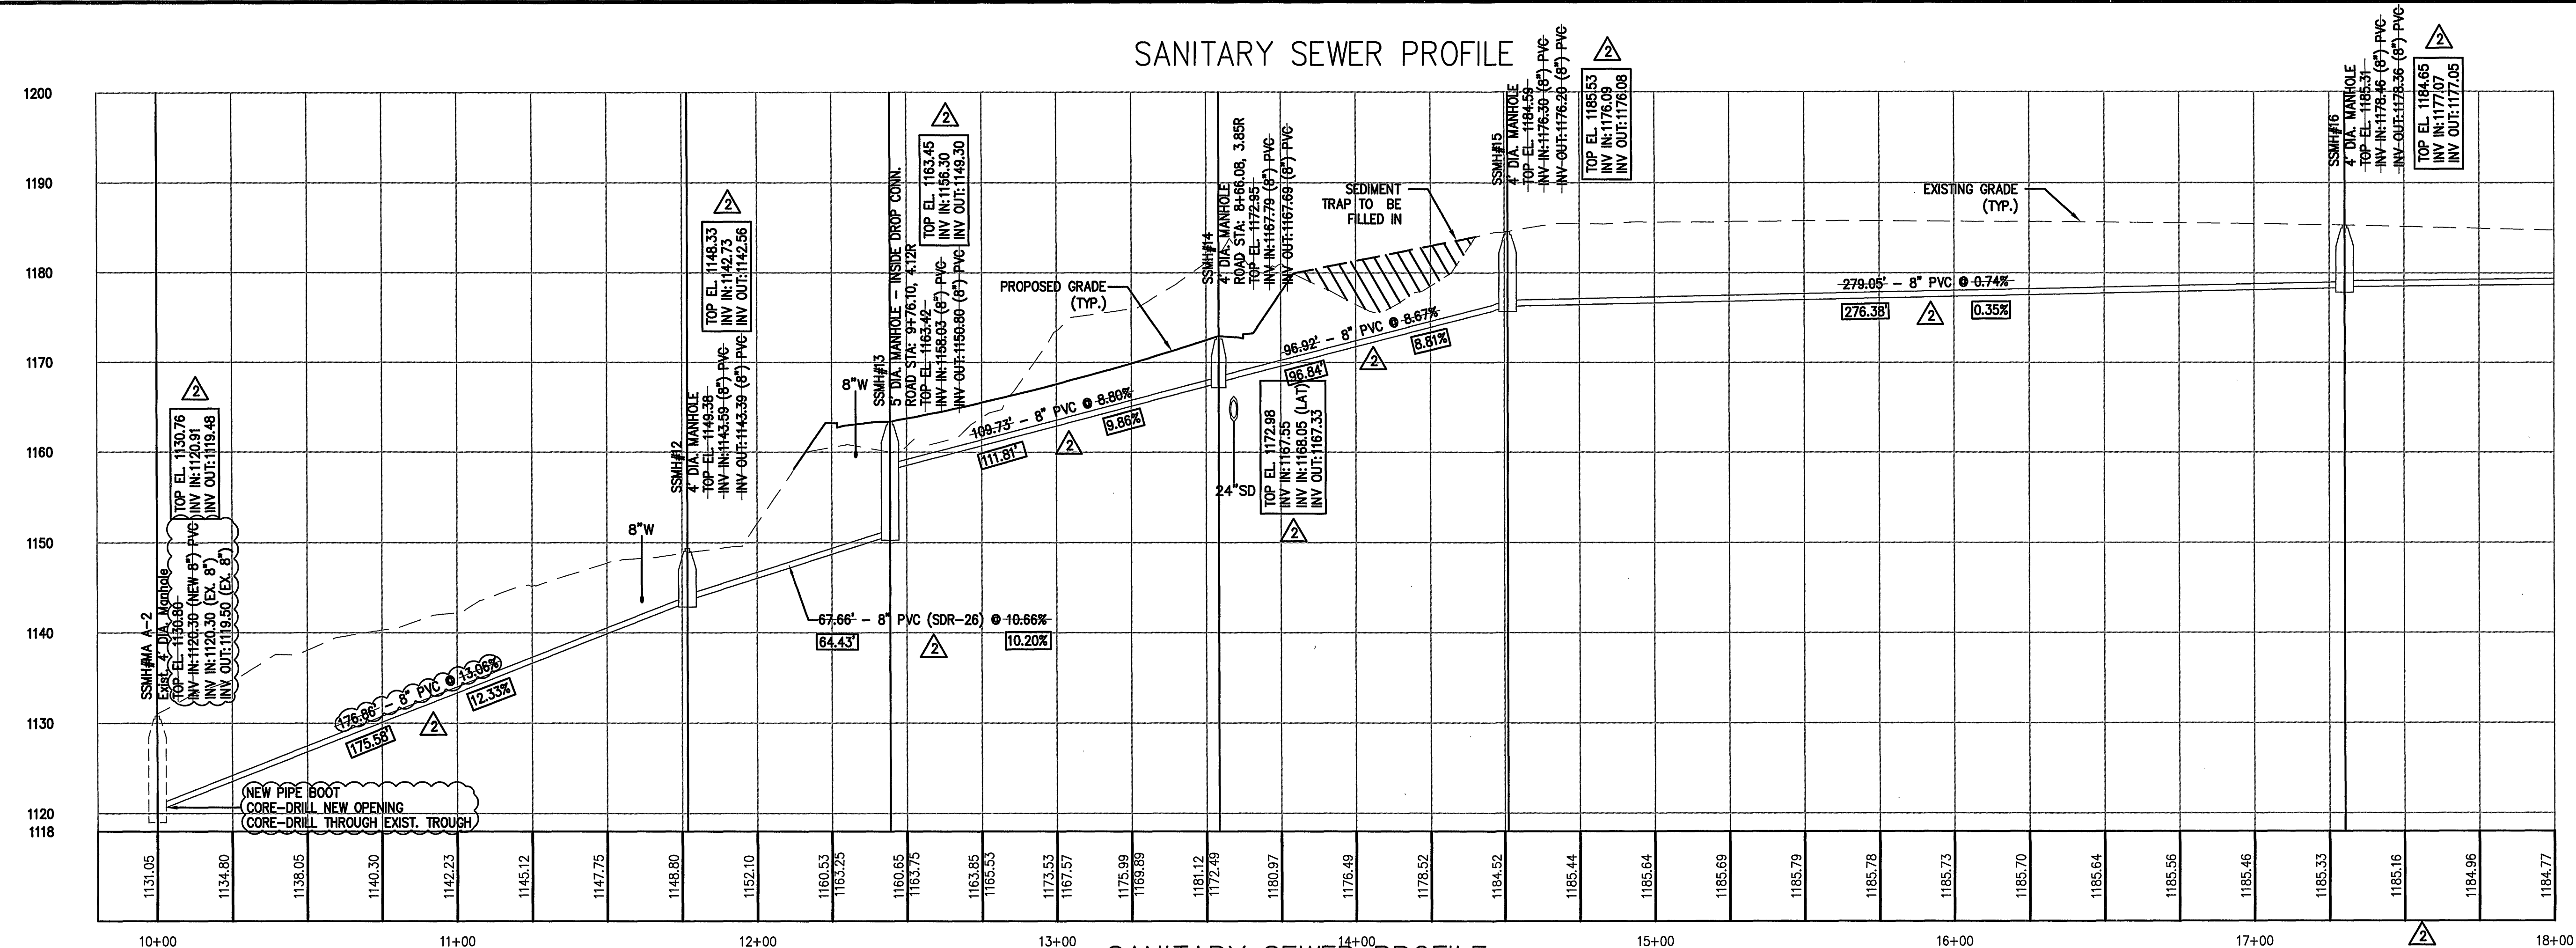


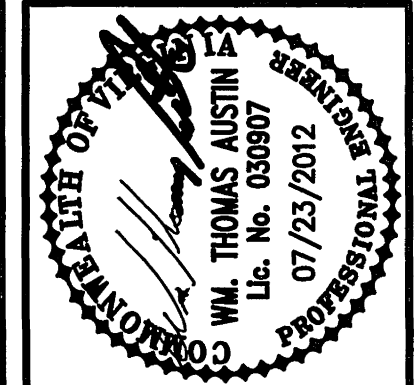

SEE SHEET C-5 FOR UTILITY NOTES AND SHEET C-12 FOR SANITARY SEWER NOTES

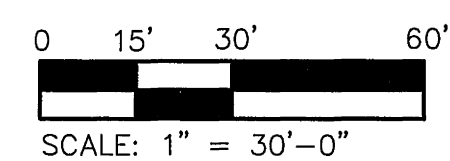

Date	11/29/12
Revisions	1 SSMH#1A A-2 REVISION
	2 AS-BUILTS

Issue Date: **JULY 23, 2012**
 Drawn By: RWA
 Designed By: RWA/WTA
 Checked By: WTA
 Date: 07/23/2012

Mattern & Craig
 CONSULTING ENGINEERS • SURVEYORS
 701 FIRST STREET, S.W.
 ROANOKE, VIRGINIA 24016
 (540) 346-9342
 FAX (540) 346-7891

SOUTH PEAK BOULEVARD
 SMITH/PACKETT MED-COM, LLC
SANITARY SEWER PROFILES
 ROANOKE COUNTY, VIRGINIA

Vertical Scale:
 1" = 10'
 Horizontal Scale:
 1" = 30'
 Commission Number:
3101B

Sheet No.:
C-9