





SANITARY SEWER PROFILE

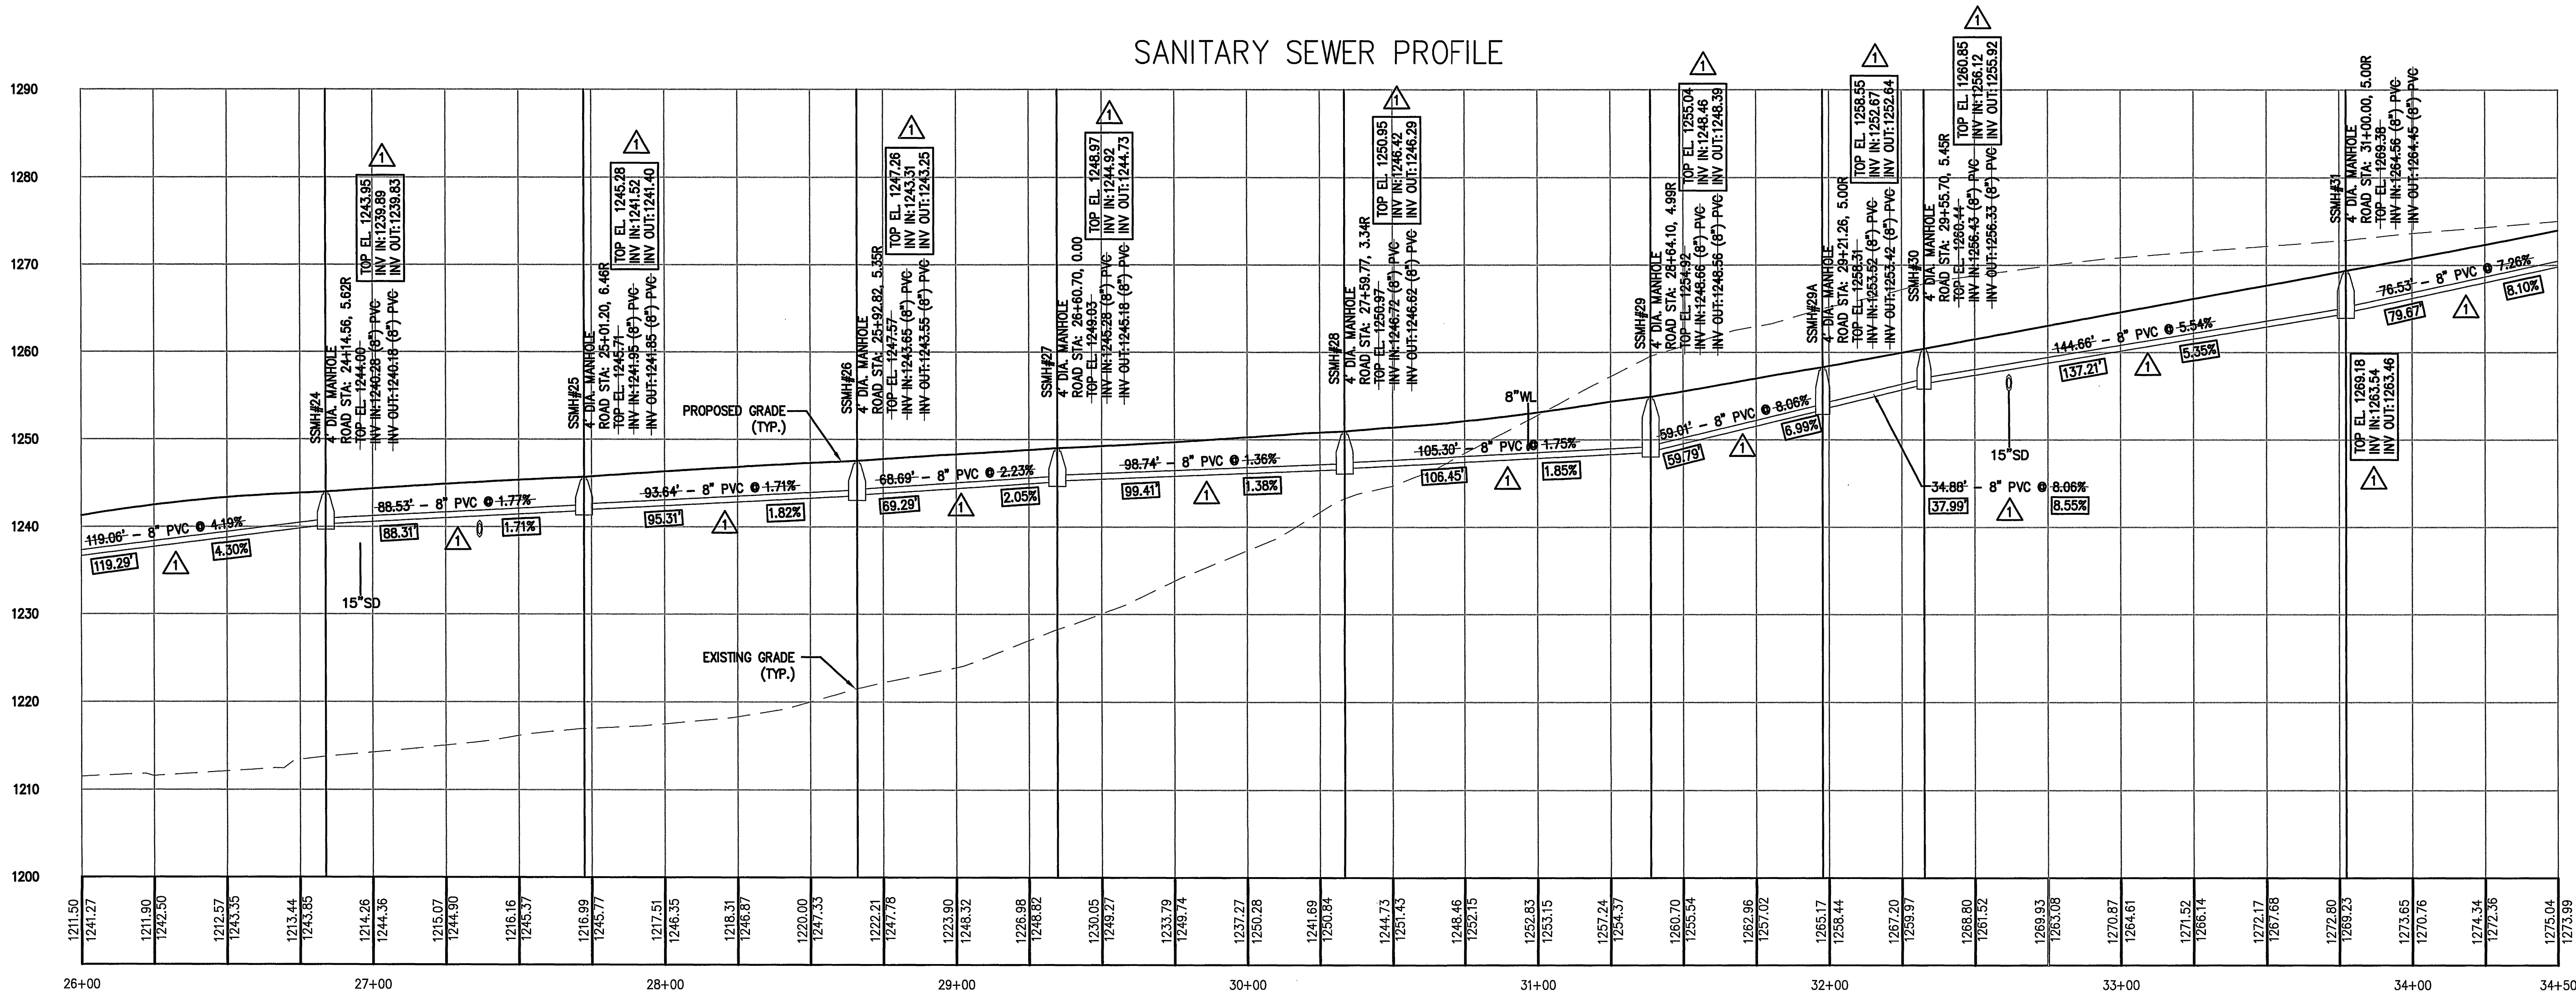

SANITARY SEWER PROFILE

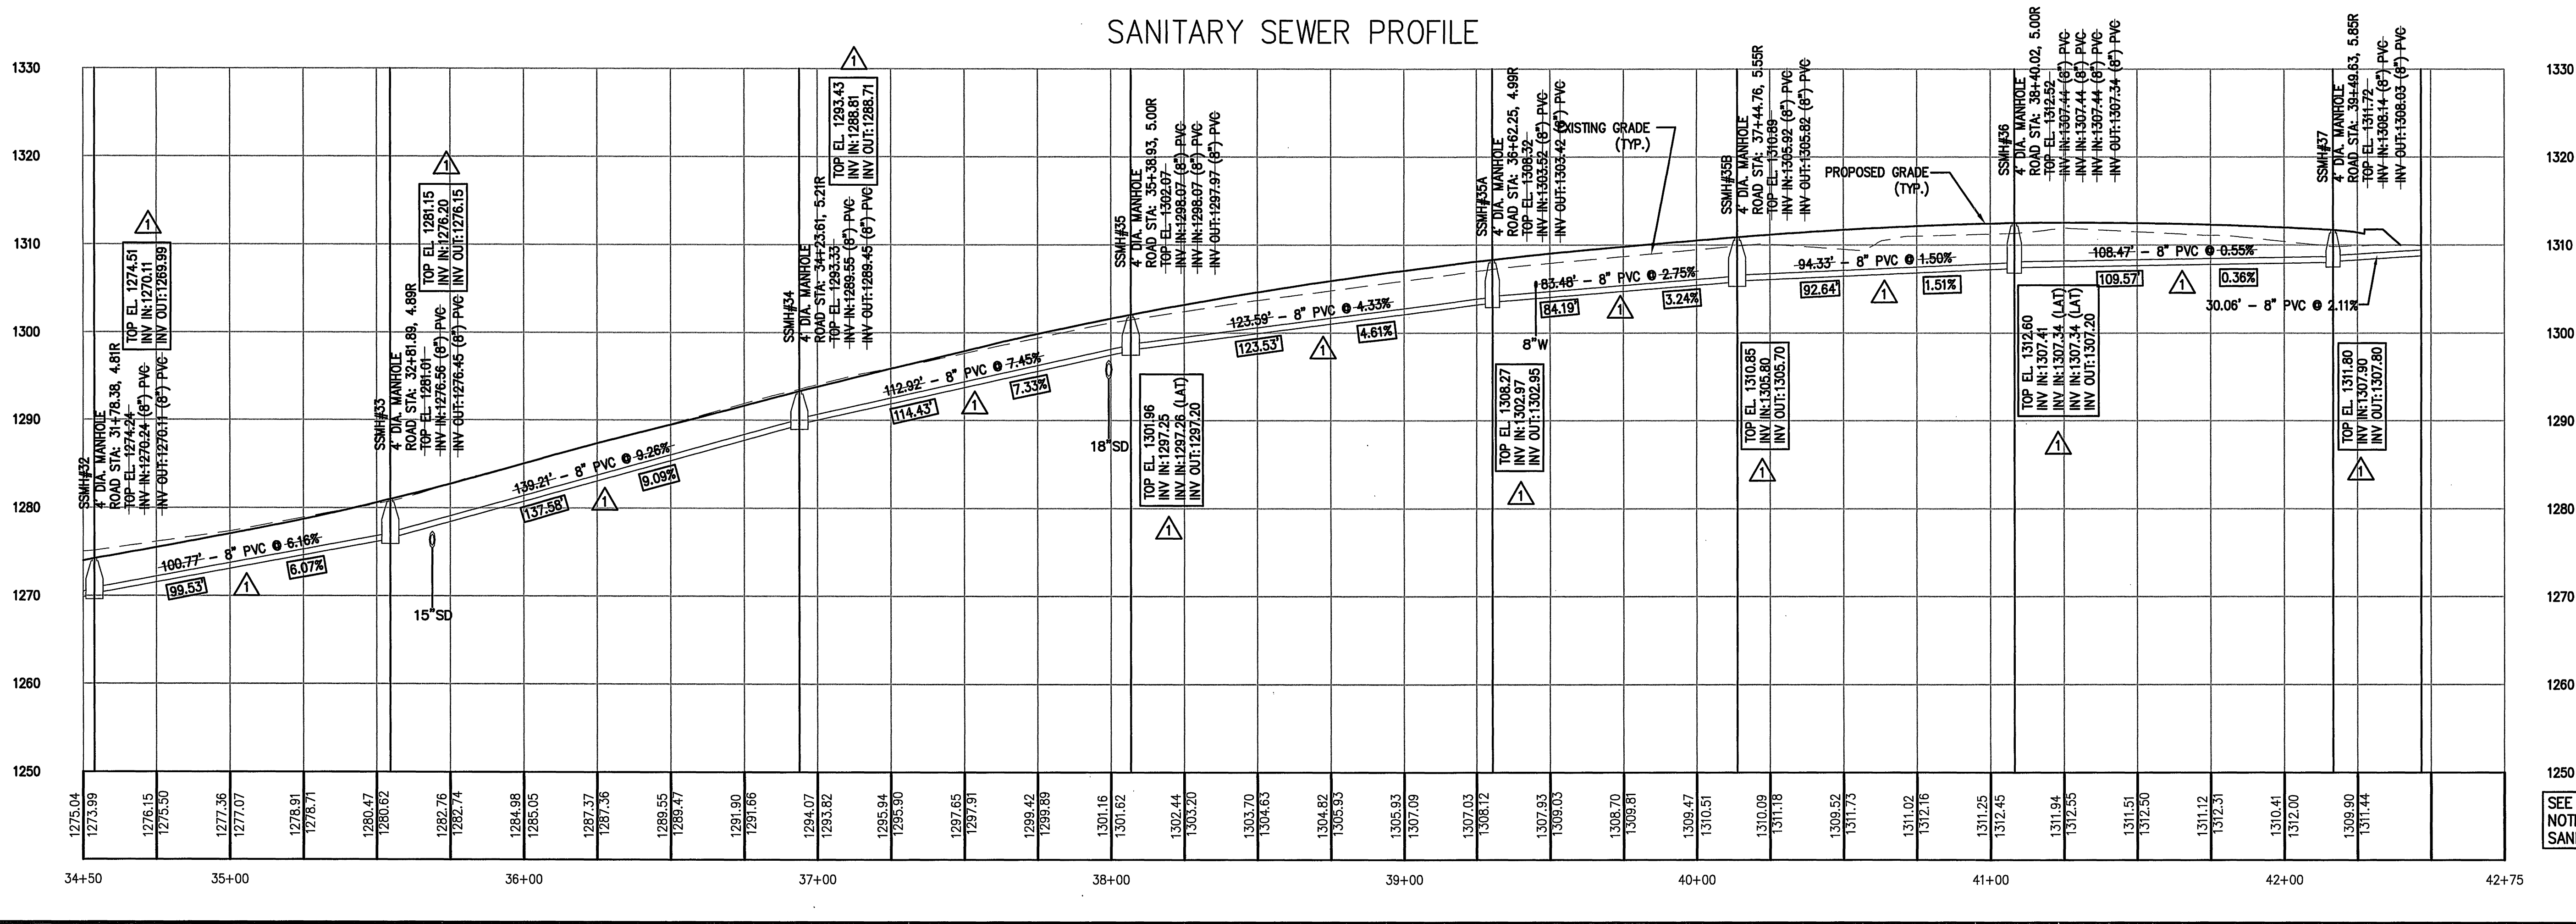

SEE SHEET C-5 FOR UTILITY
NOTES AND SHEET C-12 FOR
SANITARY SEWER NOTES

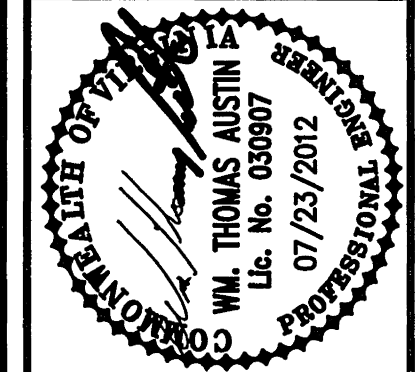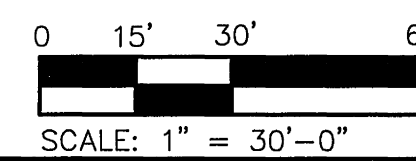

Revisions	Date
1 AS-BUILT	3/27/14

Issue Date:	JULY 23, 2012
Drawn By:	RWA
Designed By:	RWA/WTA
Checked By:	WTA
Date:	07/23/2012

Mattern & Craig
CONSULTING ENGINEERS • SURVEYORS
701 FIRST STREET, S.W.
ROANOKE, VIRGINIA 24016
(540) 345-9342
FAX (540) 345-7691

SOUTH PEAK BOULEVARD
SMITH/PACKETT MED-COM, LLC
SANITARY SEWER PROFILES
ROANOKE COUNTY, VIRGINIA

Vertical Scale:
1" = 10'

Horizontal Scale:
1" = 30'

Commission Number:
3101B

Sheet No.:
C-10