
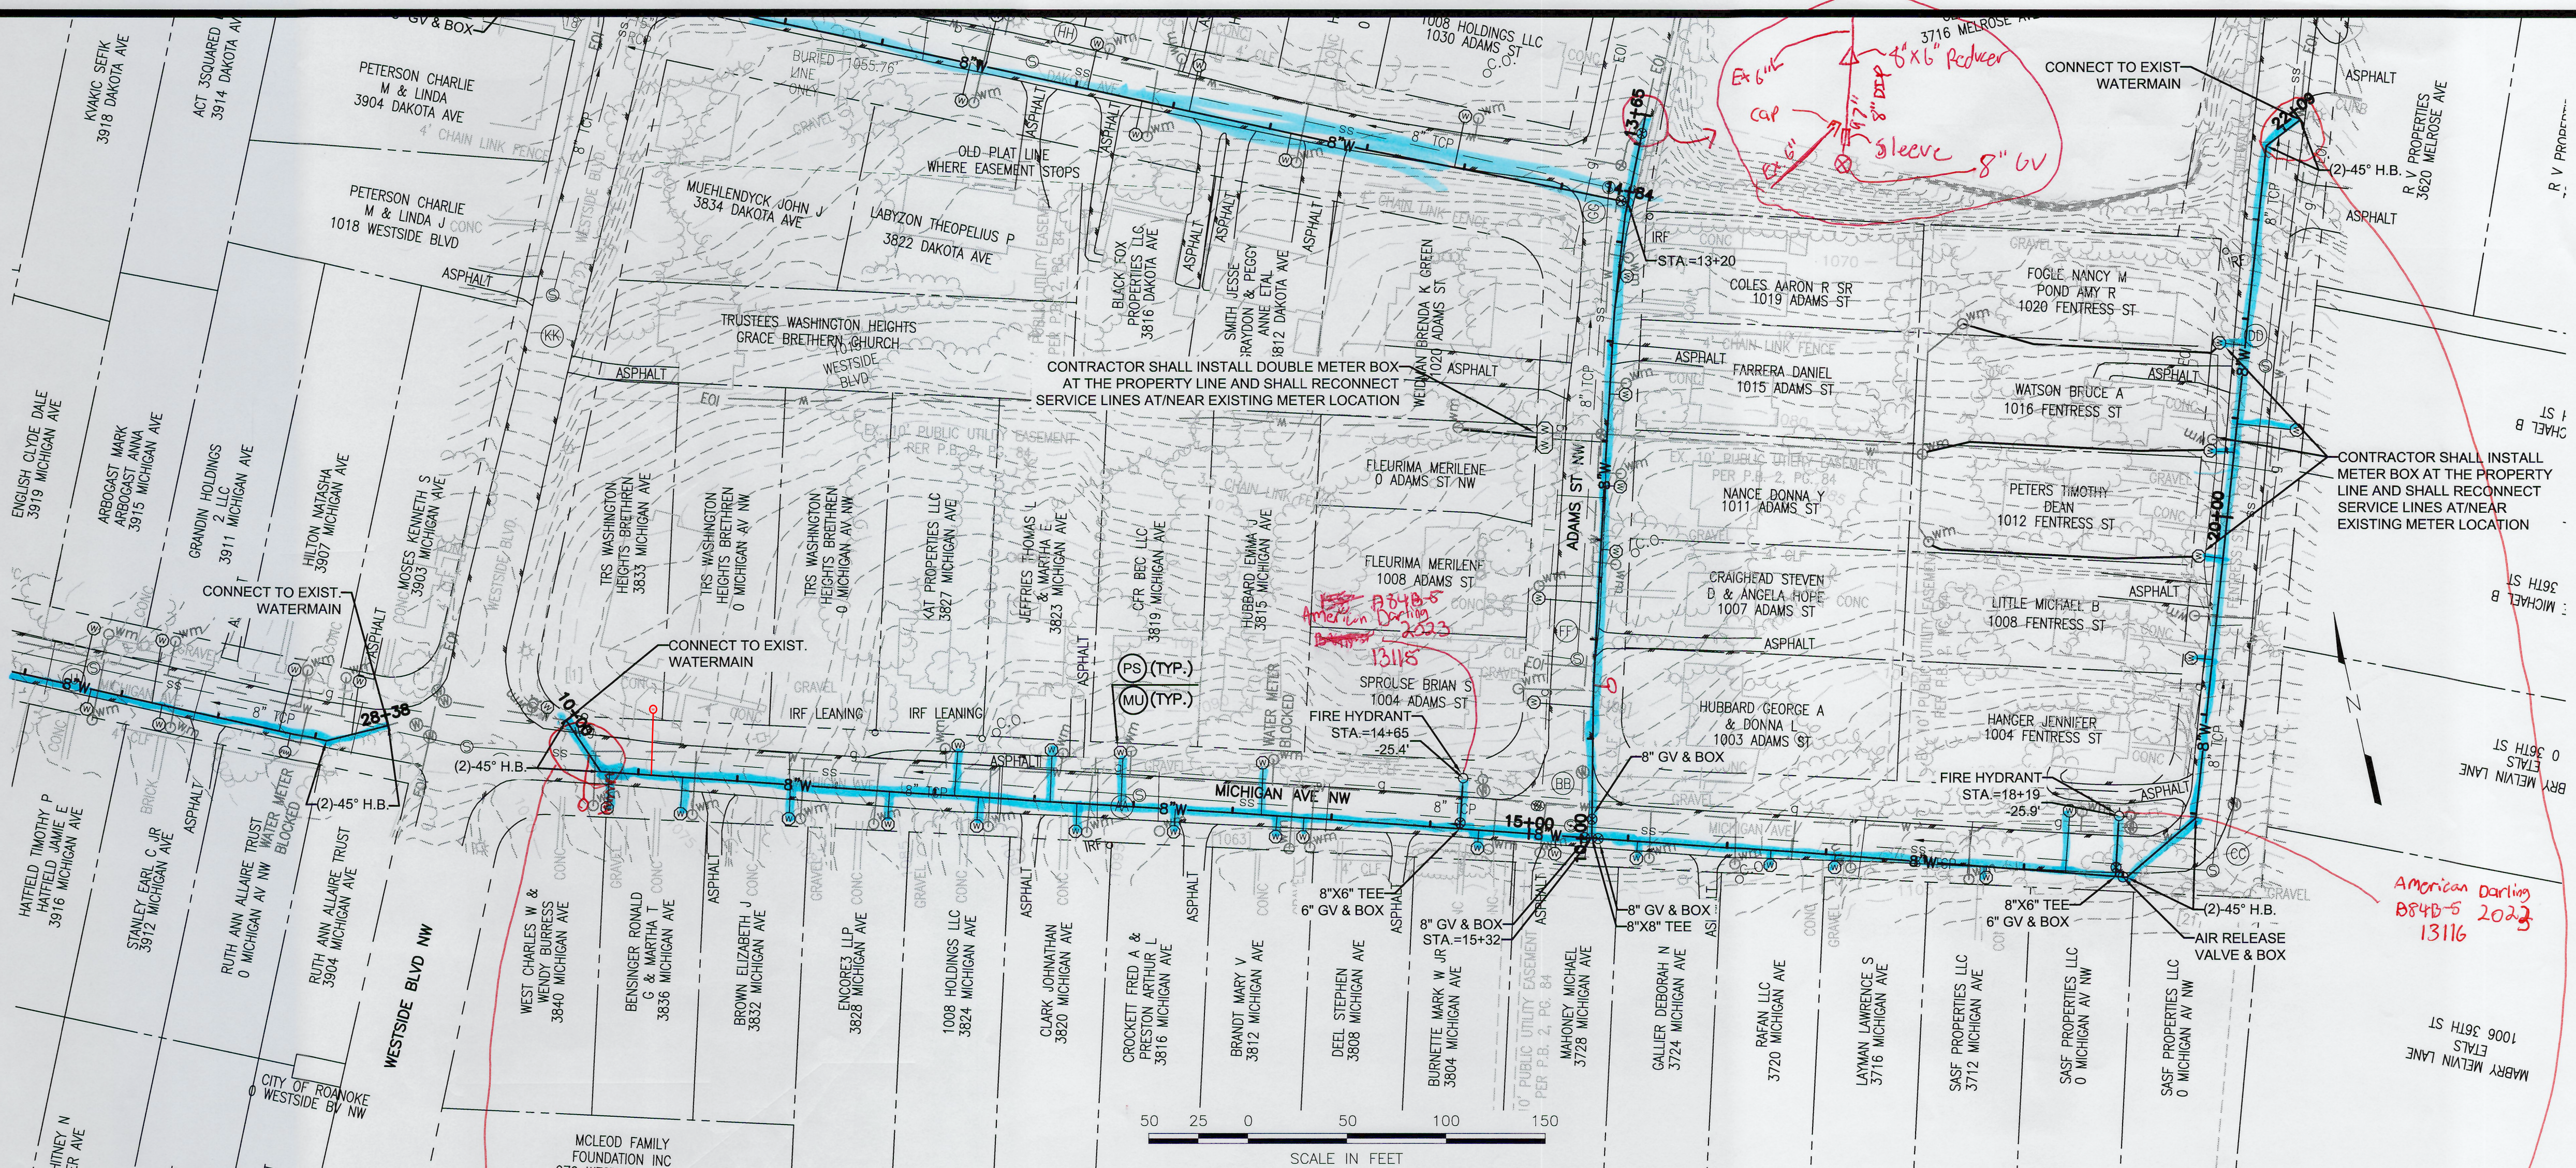


Mar 23, 2023 8:34am Z:\2022\20221665\Engineering\CAD\20221665_Design_Sheets.dwg

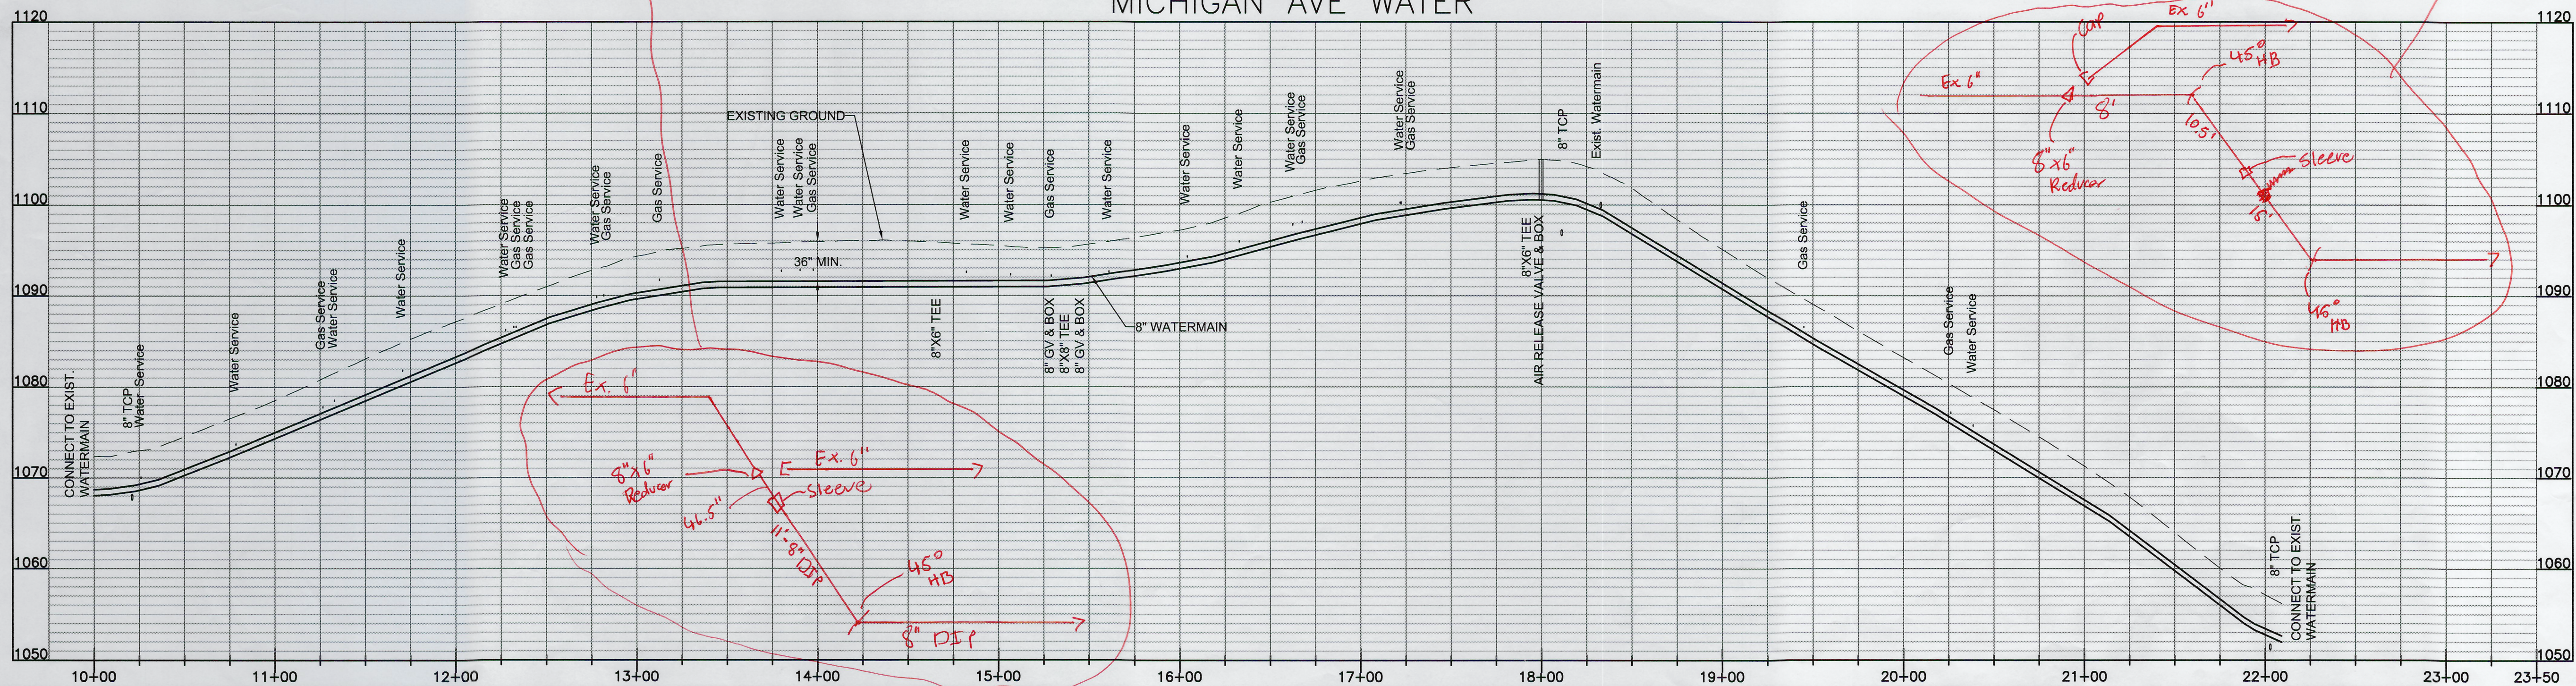

- Replace Existing Water Meter
- Replace Existing Water Meter (not found)
- Air Release or Blow Off Valve
- Gate Valve
- Fire Hydrant
- Pavement Restoration - Patch Private Entrance, per Specifications

- NOTES:
- CONTRACTOR SHALL CONFIRM EXISTING SERVICES MARKED FOR DEMOLITION ARE INACTIVE PRIOR TO DEMOLITION. OWNER WILL ASSIST CONTRACTOR WITH VERIFICATION.
 - CONTRACTOR SHALL PERFORM EXPLORATORY EXCAVATIONS AT UTILITY CROSSINGS TO VERIFY DEPTH PRIOR TO CONSTRUCTION AS DIRECTED BY PROJECT MANUAL.
 - CONTRACTOR SHALL COORDINATE SHUTDOWNS WITH OWNER TO MAINTAIN LOOPED FLOW TO EACH STREET DURING CONSTRUCTION.
 - ALL DENUDED AREAS DISTURBED BY THE WORK SHALL BE RESTORED USING TEMPORARY SEEDING, PERMANENT SEEDING, AND MULCHING.

PLAN & PROFILE

SOUTH WASHINGTON HEIGHTS

WATER SYSTEM IMPROVEMENTS

ROANOKE, VA.


HURT & PROFFITT
INSPIRED / RESPONSIVE / TRUSTED

HP

540.552.5592
1861 PRATT DR, STE 100
BLACKSBURG, VA 24060

HANDP.COM
SURVEYING • LAND DEVELOPMENT • ENVIRONMENTAL
ENGINEERING • CONSTRUCTION TESTING & INSPECTION • CULTURAL RESOURCES

PROJECT NO.	20221665
LAT.	36.911436
LONG.	-80.318494
DATE:	20 MAR 23
DRAWN BY:	CBD
CHECKED BY:	DAA

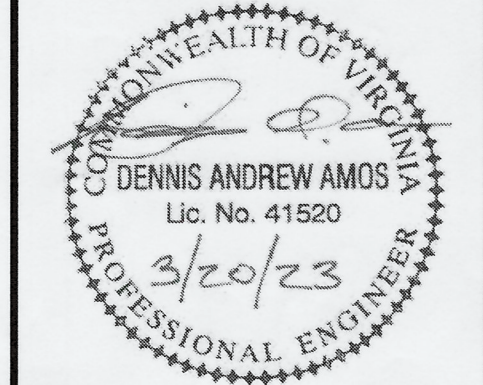

PLAN & PROFILE

HURT & PROFFITT

SHEET NO.	REV.
C103	