
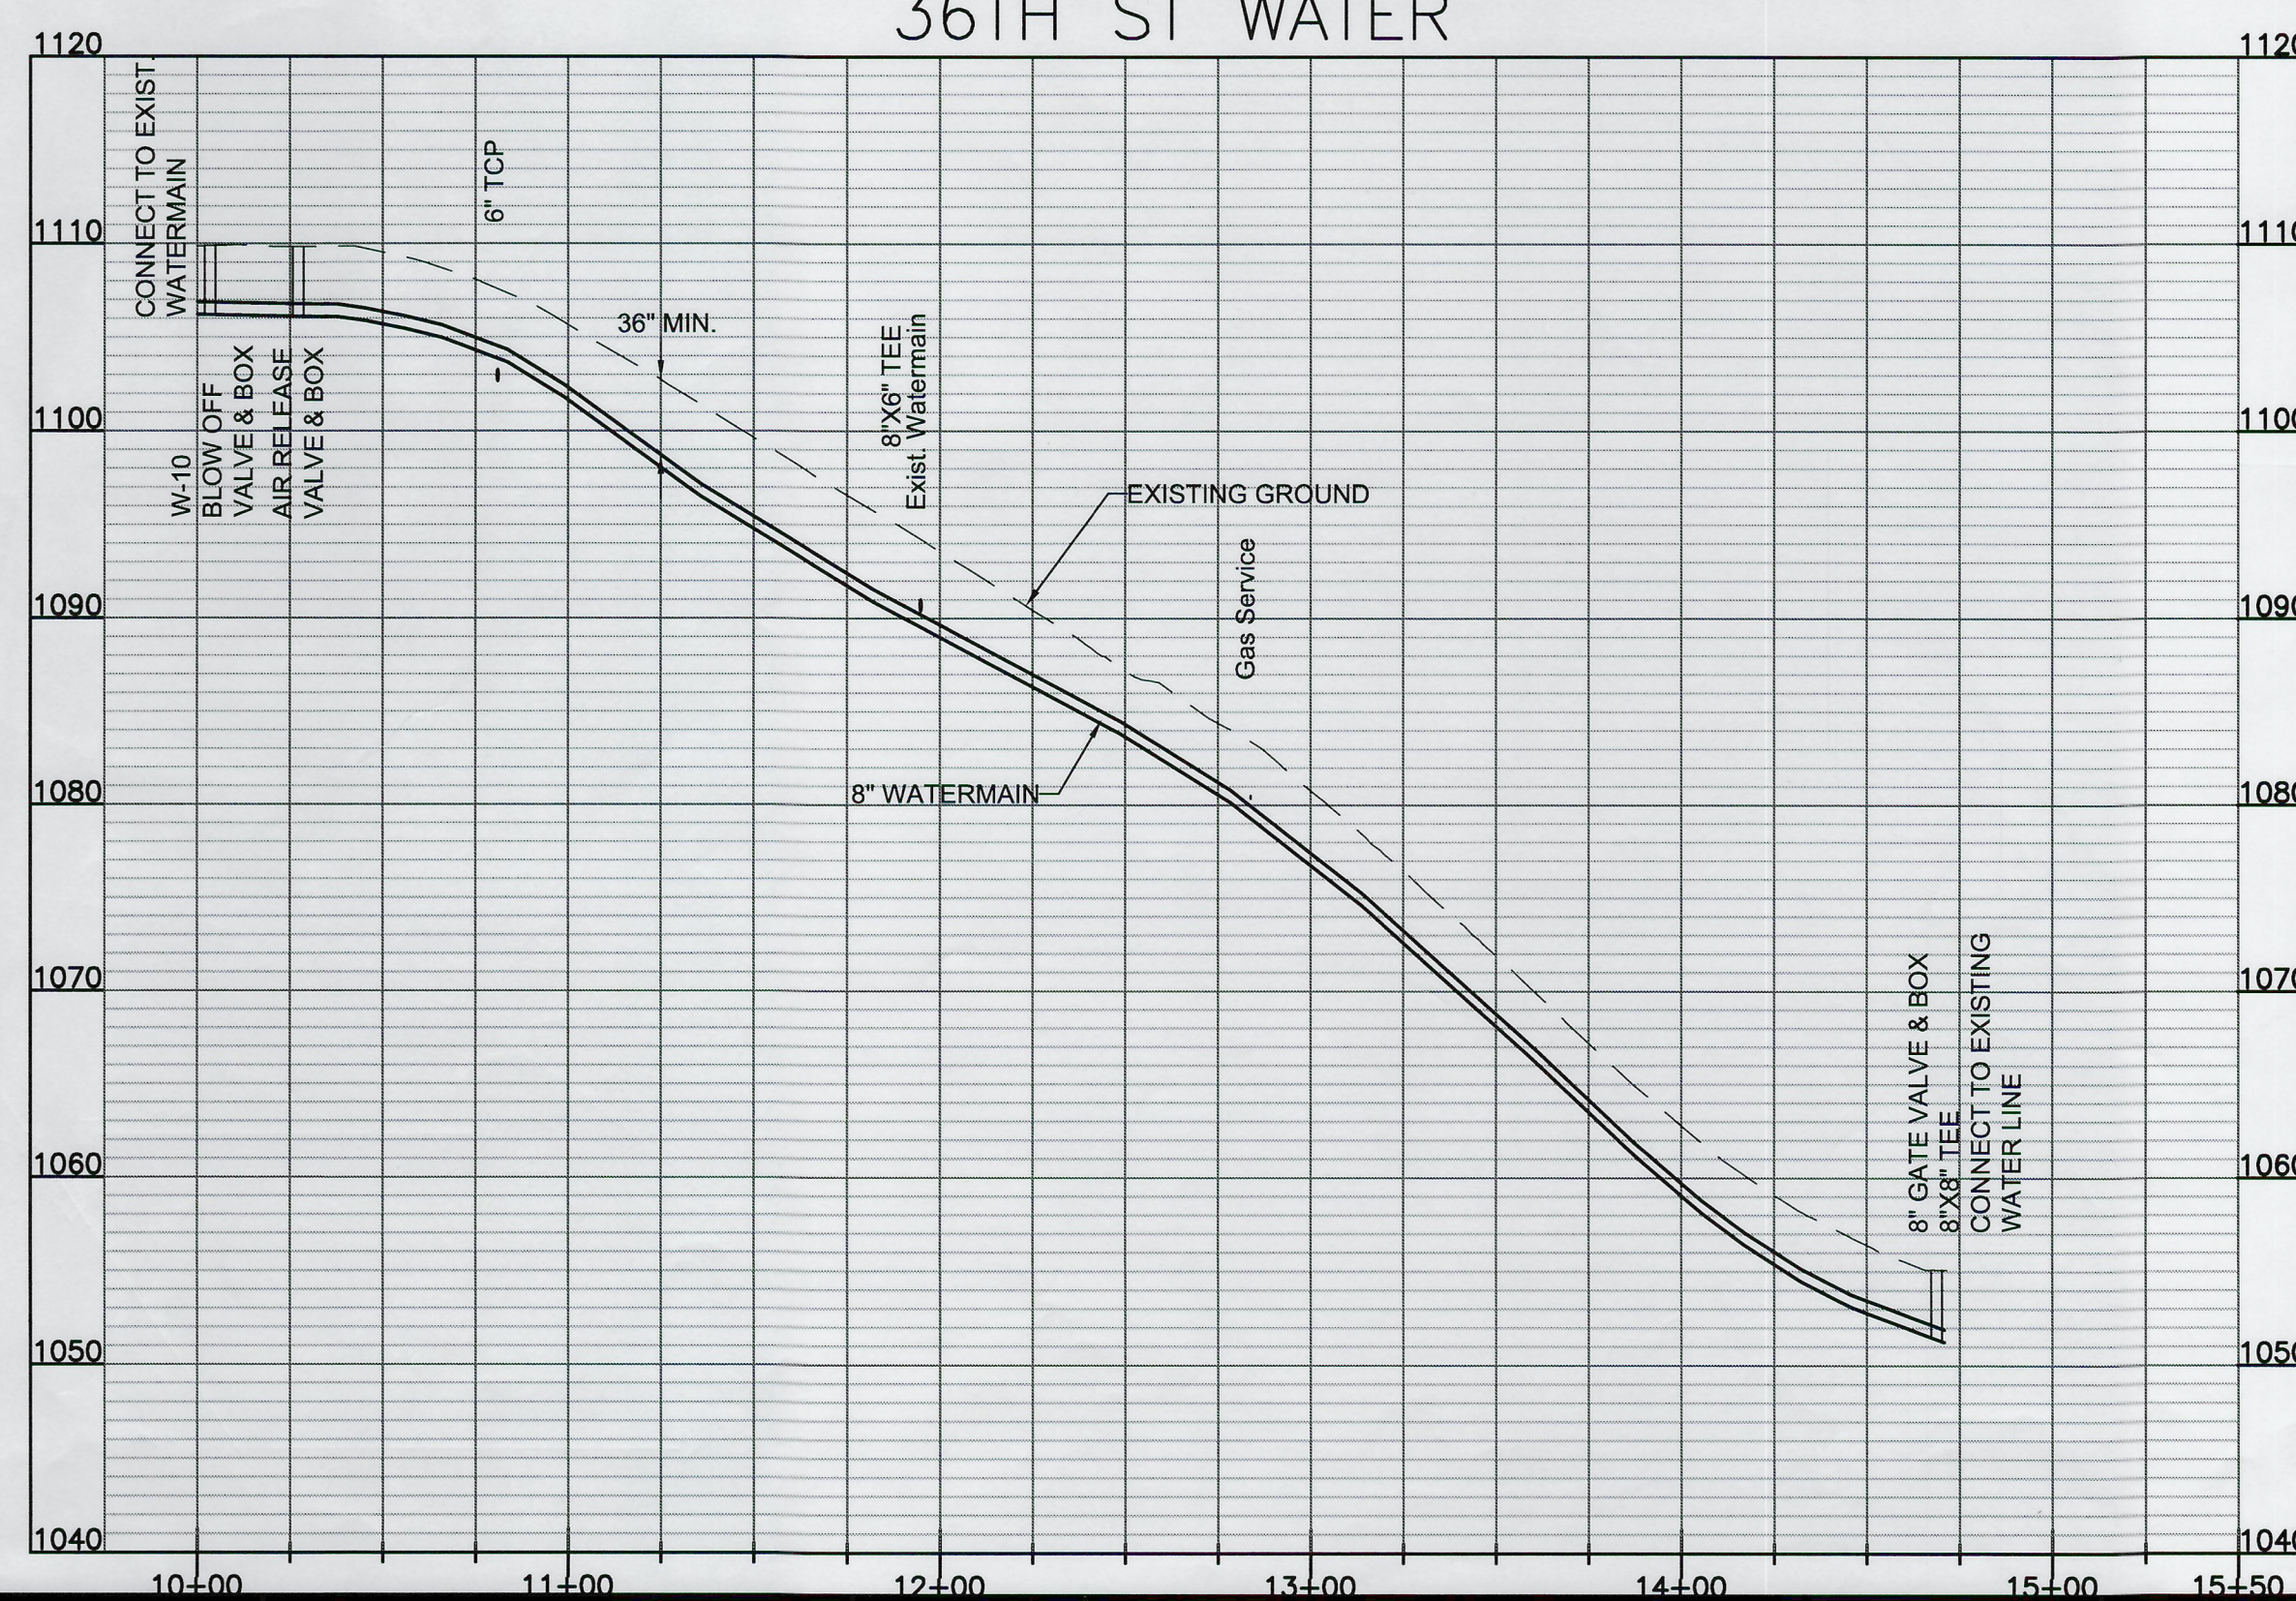
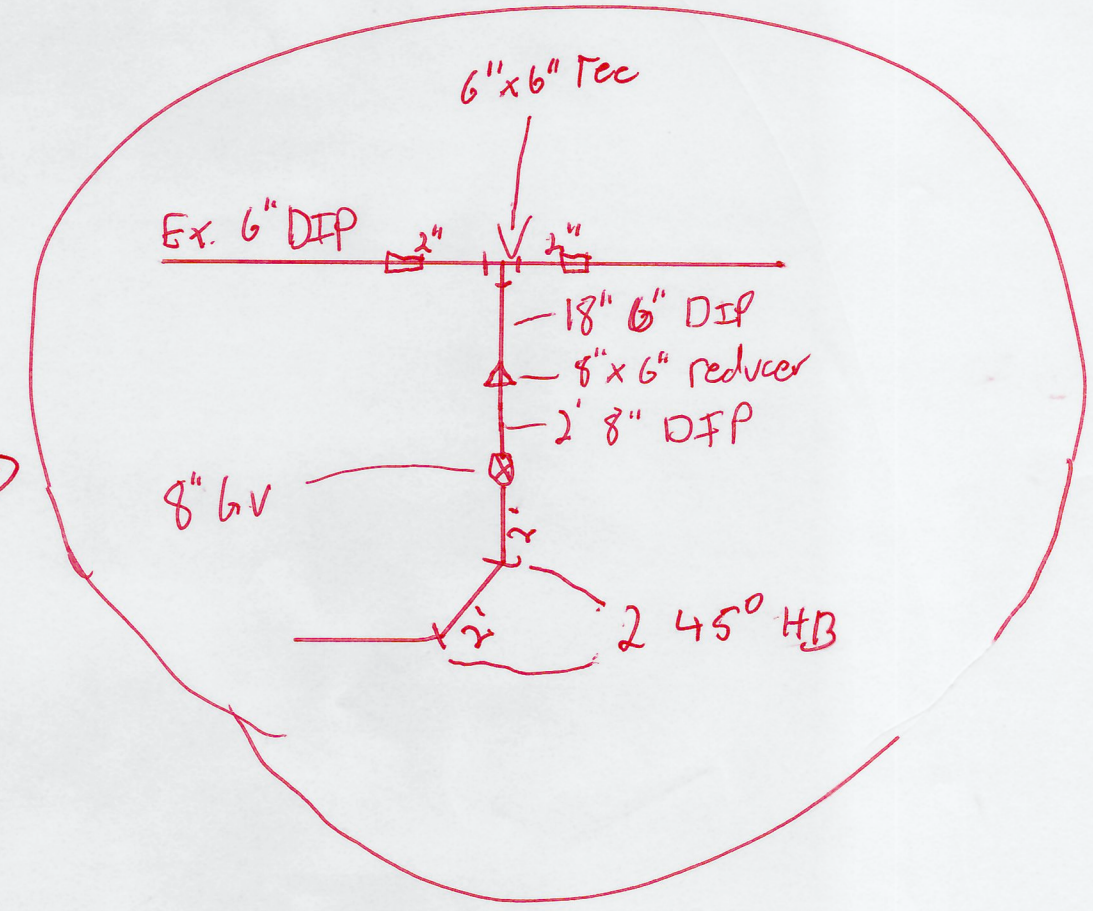


Mar 23, 2023 8:34am Z:\2022\20221865\Engineering\CAD\20221865\_Design\_Sheets.dwg

- ⊗ Replace Existing Water Meter
- ⊖ Replace Existing Water Meter (not found)
- Air Release or Blow Off Valve
- ⊕ Gate Valve
- ⊙ Fire Hydrant
- ▨ Pavement Restoration – Patch Private Entrance, per Specifications

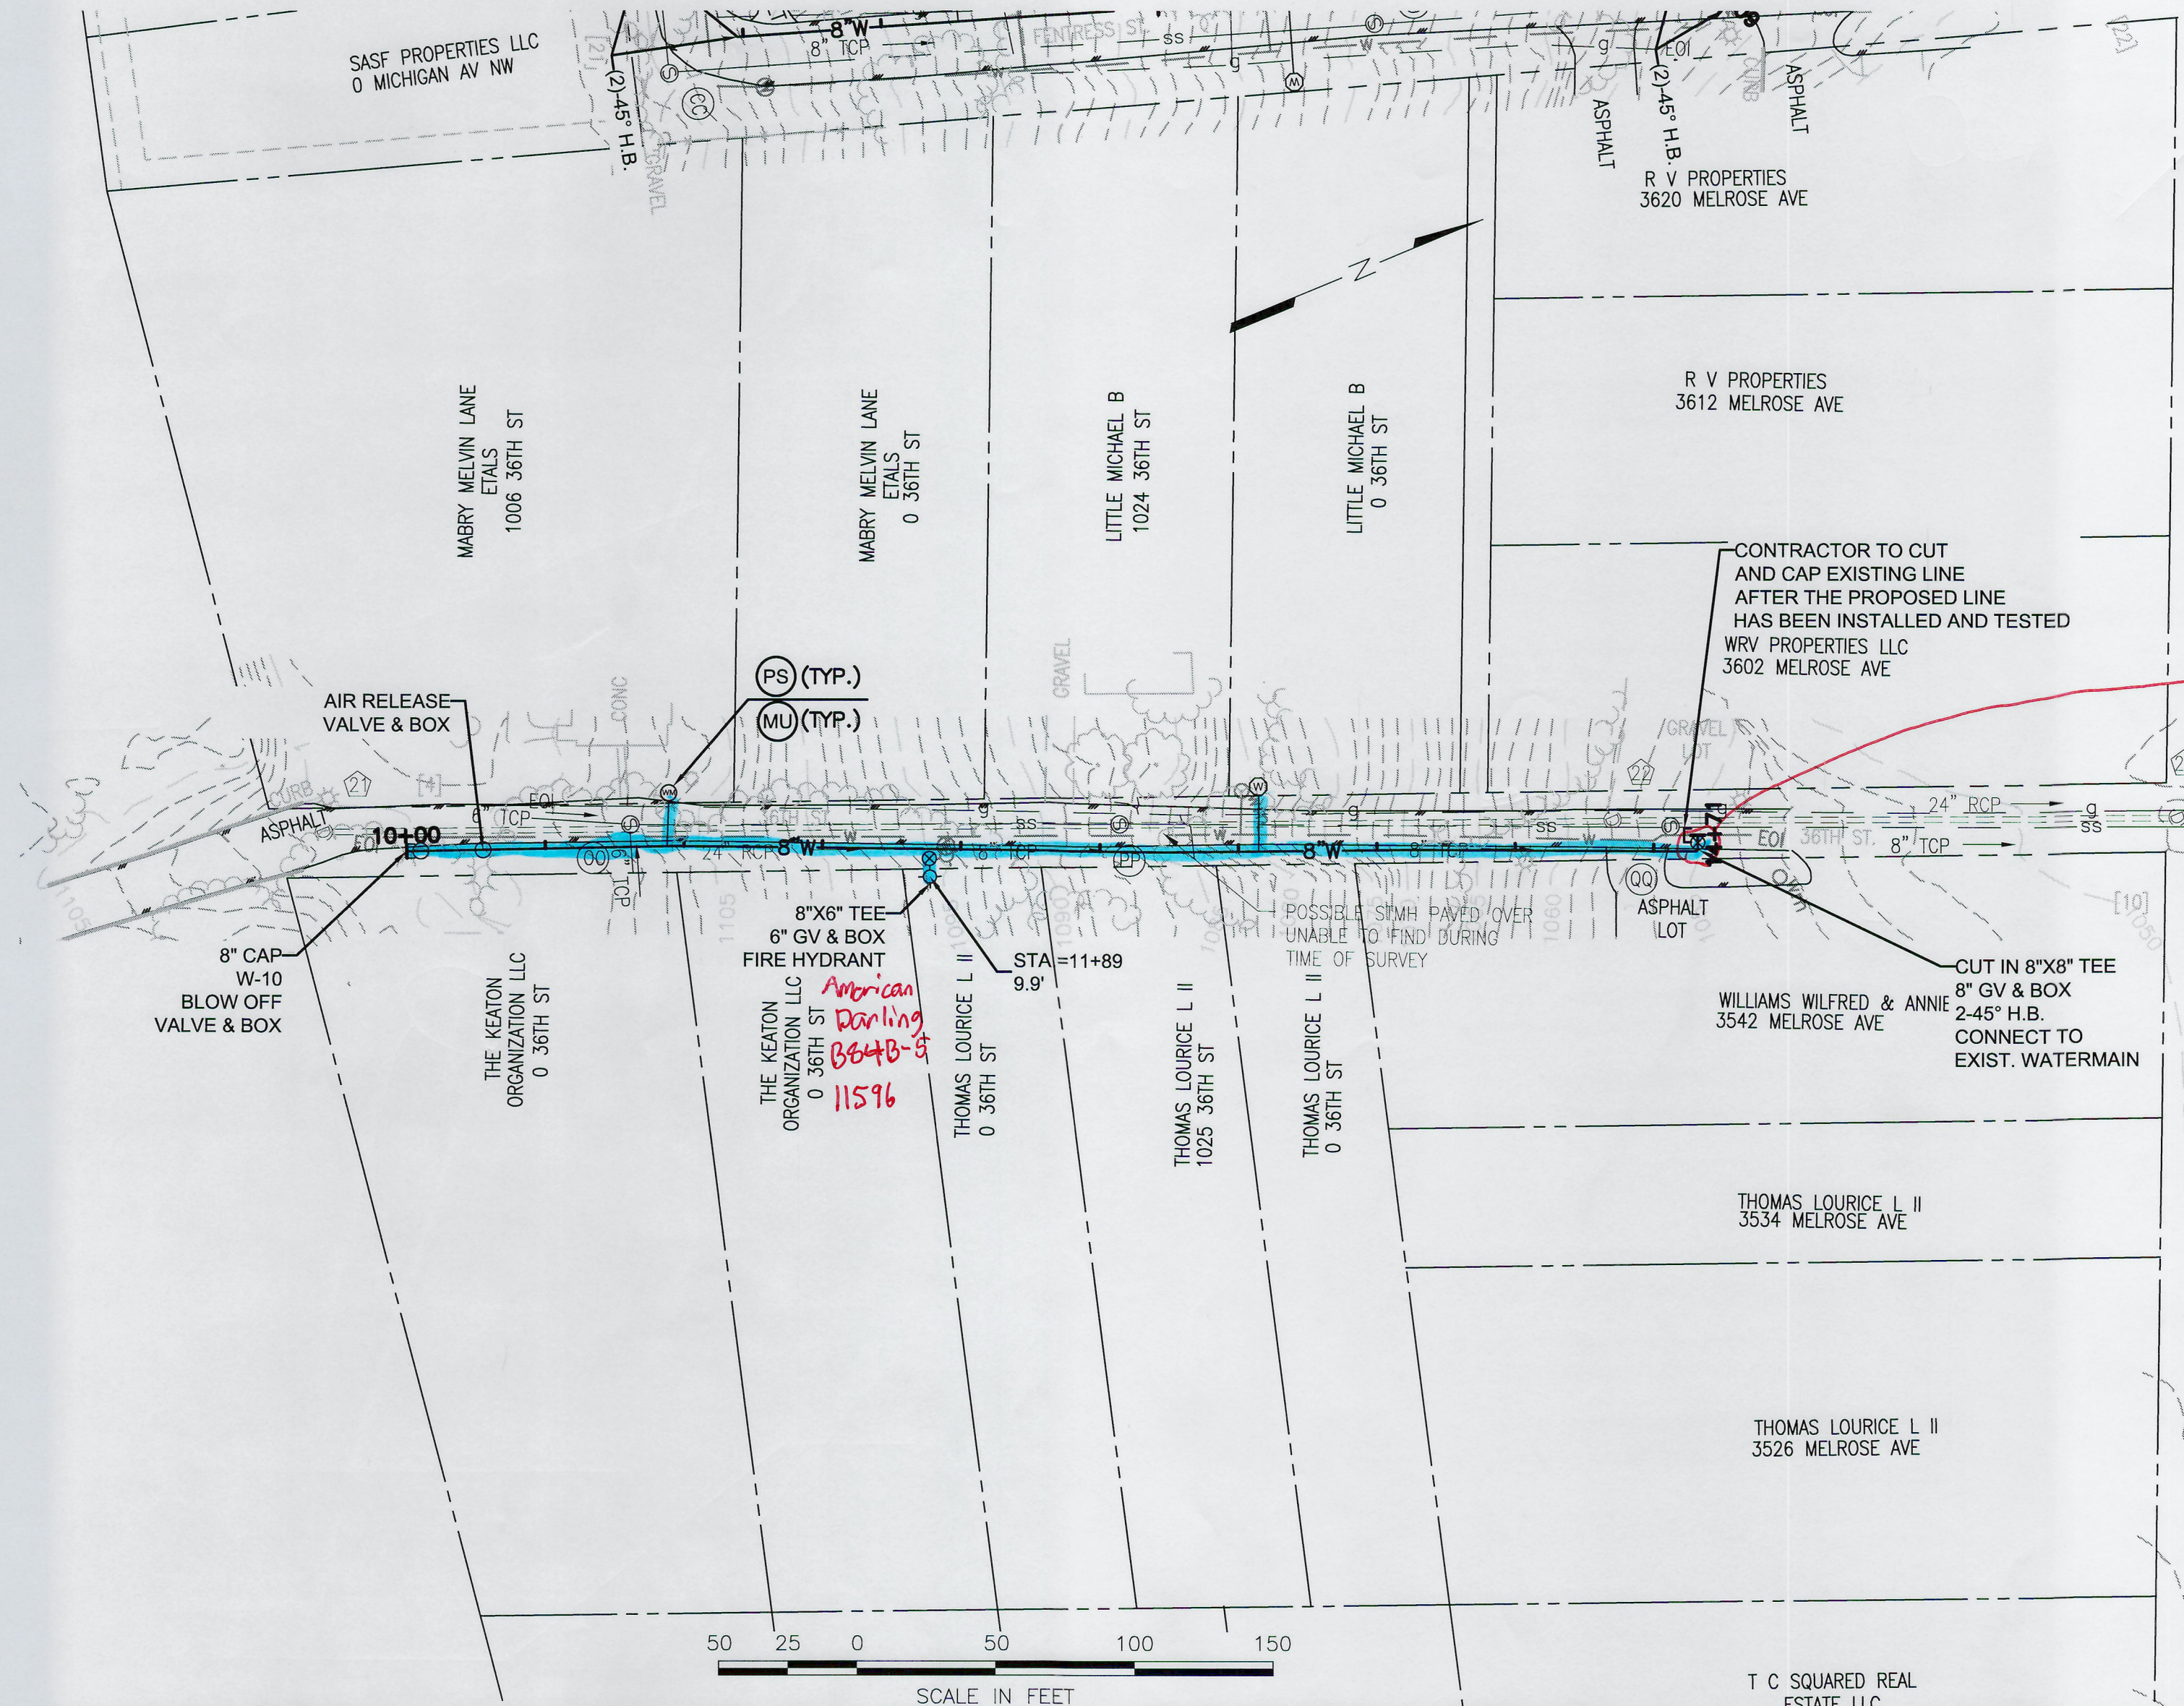

- NOTES:
1. CONTRACTOR SHALL CONFIRM EXISTING SERVICES MARKED FOR DEMOLITION ARE INACTIVE PRIOR TO DEMOLITION. OWNER WILL ASSIST CONTRACTOR WITH VERIFICATION.
  2. CONTRACTOR SHALL PERFORM EXPLORATORY EXCAVATIONS AT UTILITY CROSSINGS TO VERIFY DEPTH PRIOR TO CONSTRUCTION AS DIRECTED BY PROJECT MANUAL.
  3. CONTRACTOR SHALL COORDINATE SHUTDOWNS WITH OWNER TO MAINTAIN LOOPED FLOW TO EACH STREET DURING CONSTRUCTION.
  4. ALL DENUDED AREAS DISTURBED BY THE WORK SHALL BE RESTORED USING TEMPORARY SEEDING, PERMANENT SEEDING, AND MULCHING.

**PLAN & PROFILE**  
**SOUTH WASHINGTON HEIGHTS**  
**WATER SYSTEM IMPROVEMENTS**  
**ROANOKE, VA.**

|             |            |
|-------------|------------|
| PROJECT NO. | 20221865   |
| LAT.        | 36.911436  |
| LONG.       | -80.318494 |
| DATE:       | 20 MAR 23  |
| DRAWN BY:   | CBD        |
| CHECKED BY: | DAA        |

