



Mar 23, 2023 8:35am Z:\2022\20221865\Engineering\CAD\20221865_Design_Sheets.dwg

- ⊙ Replace Existing Water Meter
- ⊙ Replace Existing Water Meter (not found)
- Air Release or Blow Off Valve
- ⊗ Gate Valve
- ⊕ Fire Hydrant
- ▨ Pavement Restoration – Patch Private Entrance, per Specifications

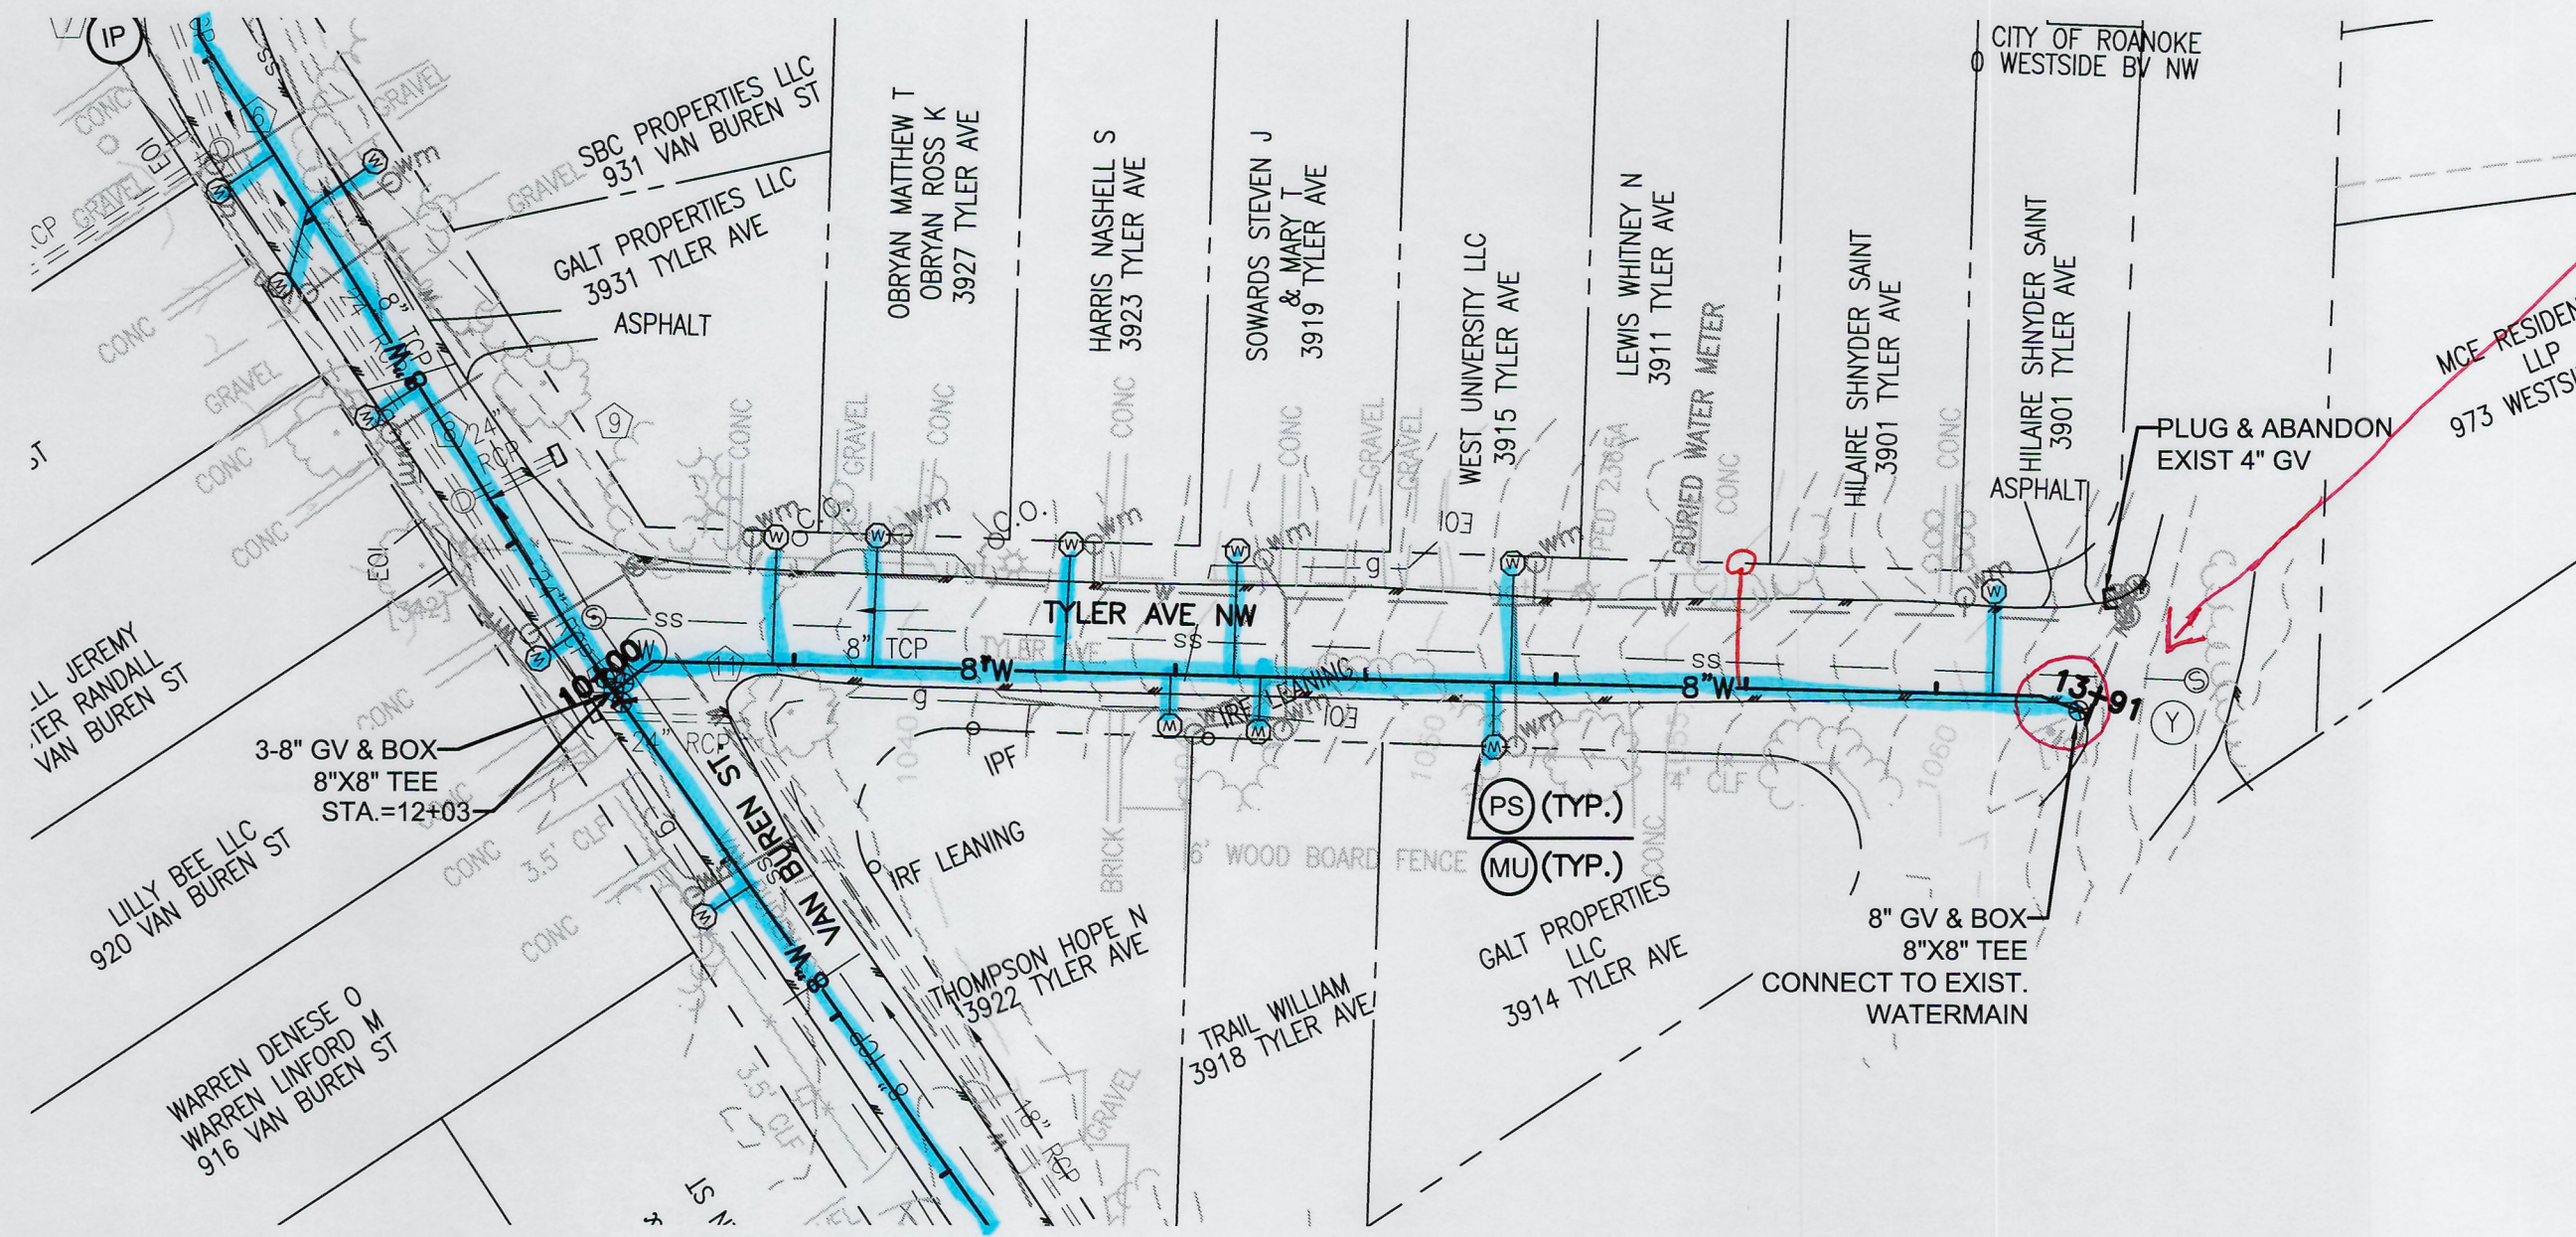


50 25 0 50 100 150
SCALE IN FEET

TYLER ST. WATER

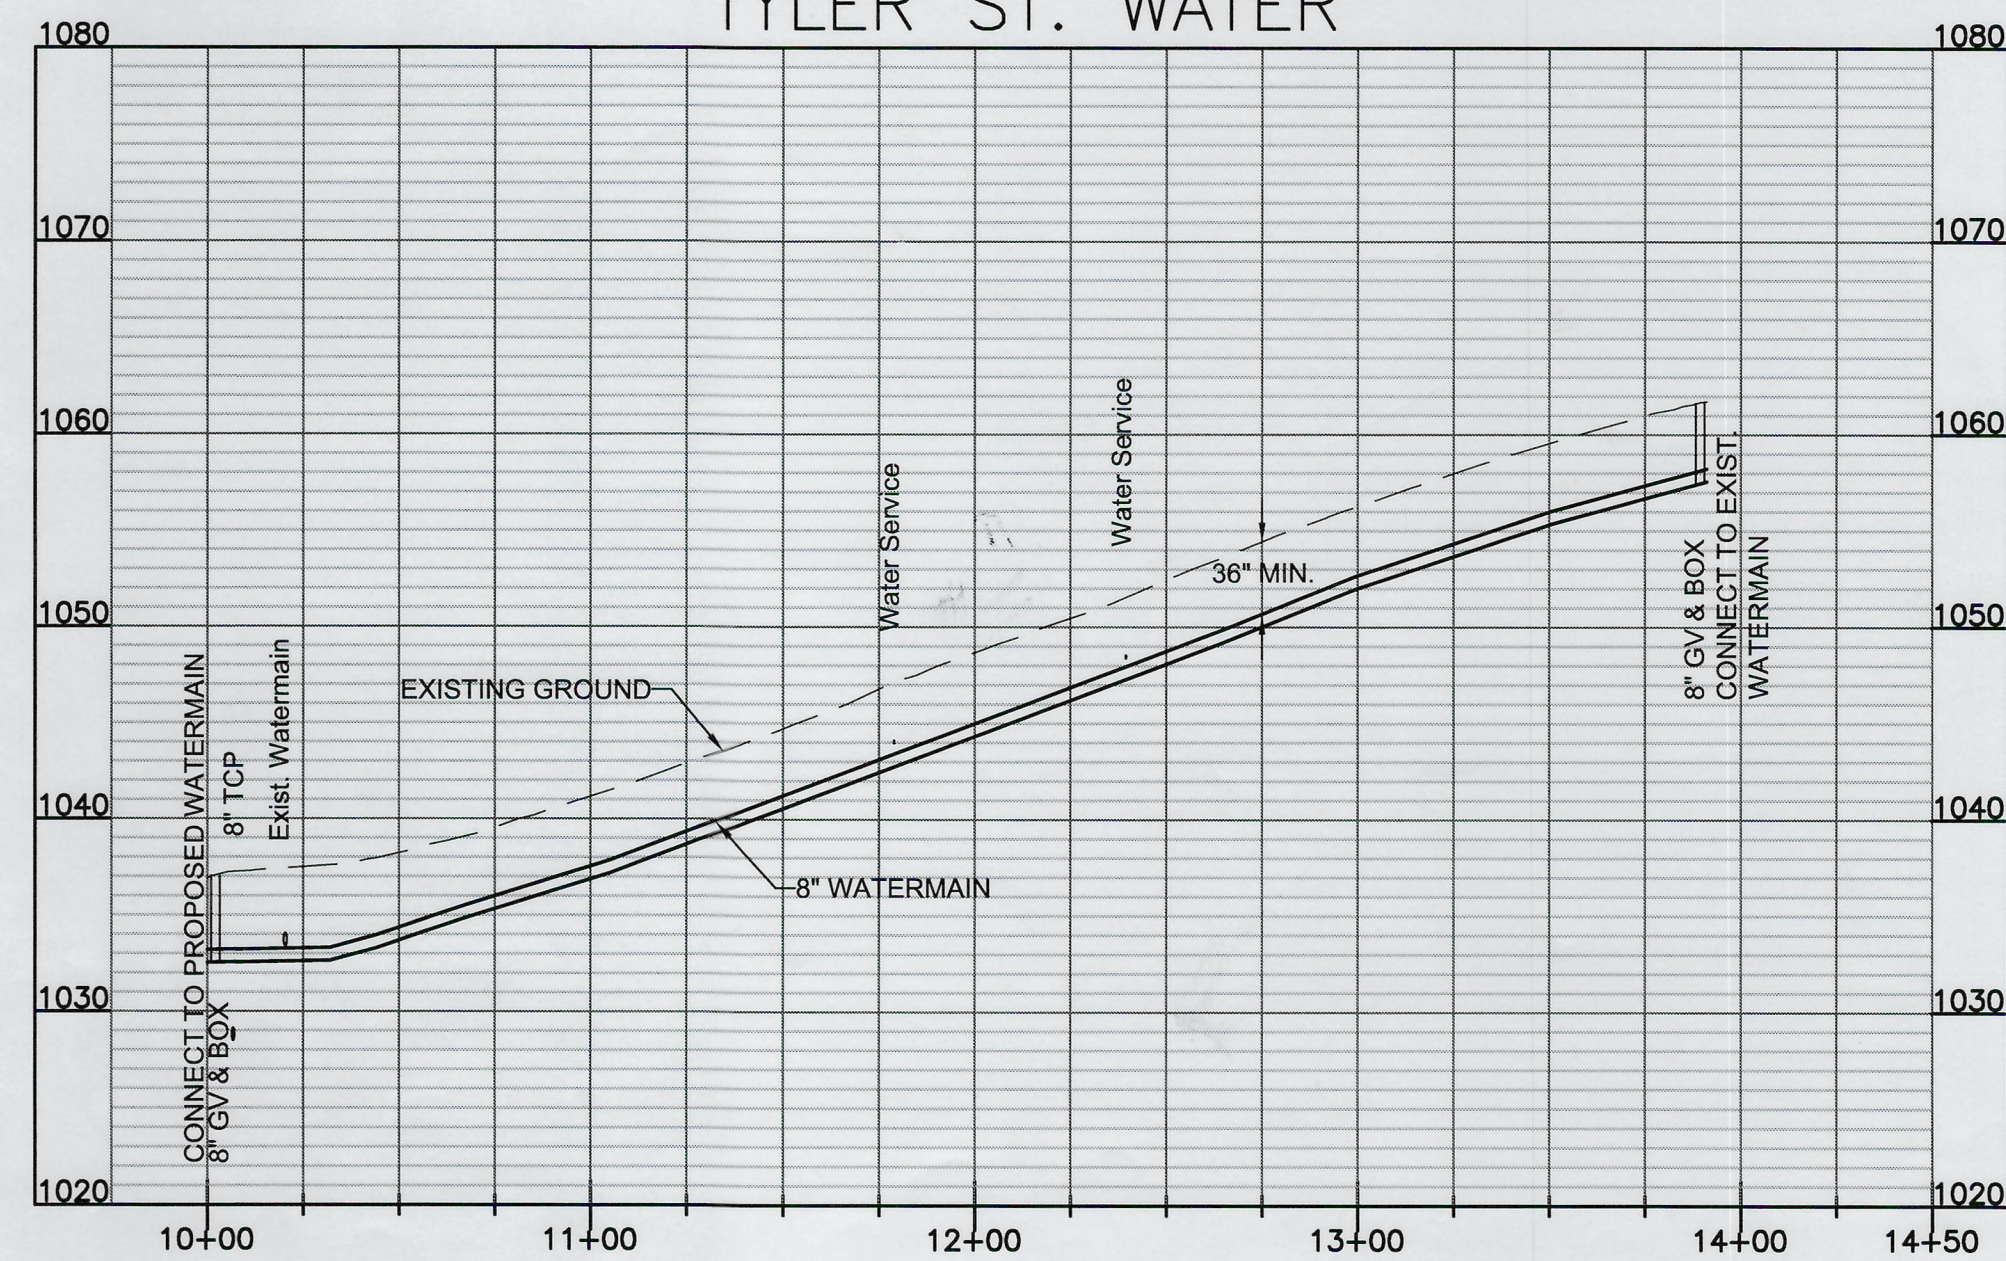

- NOTES:**
- CONTRACTOR SHALL CONFIRM EXISTING SERVICES MARKED FOR DEMOLITION ARE INACTIVE PRIOR TO DEMOLITION. OWNER WILL ASSIST CONTRACTOR WITH VERIFICATION.
 - CONTRACTOR SHALL PERFORM EXPLORATORY EXCAVATIONS AT UTILITY CROSSINGS TO VERIFY DEPTH PRIOR TO CONSTRUCTION AS DIRECTED BY PROJECT MANUAL.
 - CONTRACTOR SHALL COORDINATE SHUTDOWNS WITH OWNER TO MAINTAIN LOOPED FLOW TO EACH STREET DURING CONSTRUCTION.
 - ALL DENUDED AREAS DISTURBED BY THE WORK SHALL BE RESTORED USING TEMPORARY SEEDING, PERMANENT SEEDING, AND MULCHING.

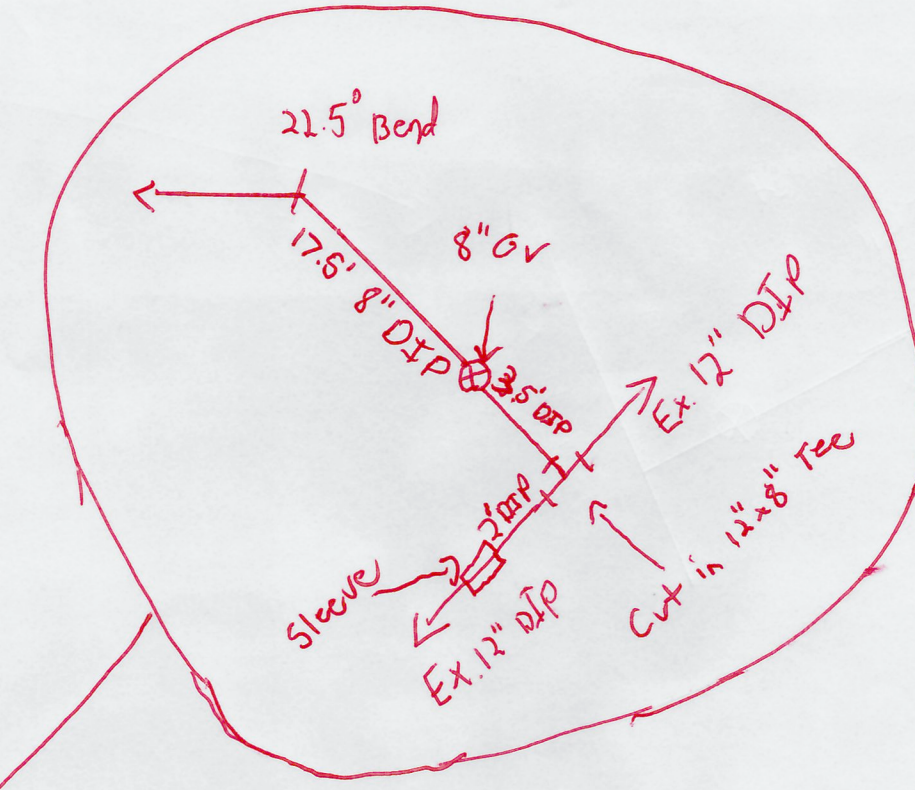

HURT & PROFFITT
INSPIRED / RESPONSIVE / TRUSTED


HP

540.552.5592
1861 PRATT DR, STE 1100
BLACKSBURG, VA, 24060

HANDP.COM
ENGINEERING • SURVEYING • LAND DEVELOPMENT • ENVIRONMENTAL
GEOTECHNICAL • CONSTRUCTION TESTING & INSPECTION • CULTURAL RESOURCES

PLAN & PROFILE SOUTH WASHINGTON HEIGHTS WATER SYSTEM IMPROVEMENTS ROANOKE, VA.

PROJECT NO.	20221865
LAT.	36.911436
LONG.	-80.318494
DATE:	20 MAR 23
DRAWN BY:	CBD
CHECKED BY:	DAA

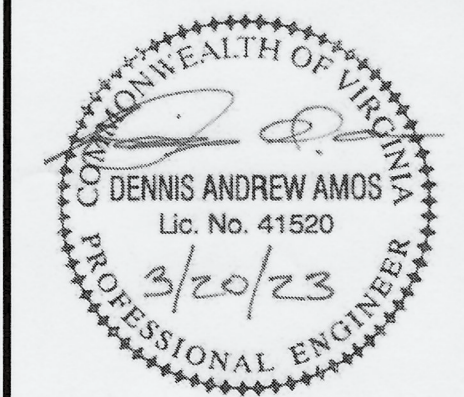

PLAN & PROFILE

HURT & PROFFITT

SHEET NO. C109	REV.
-------------------	------