


PROJECT LOCATION MAP

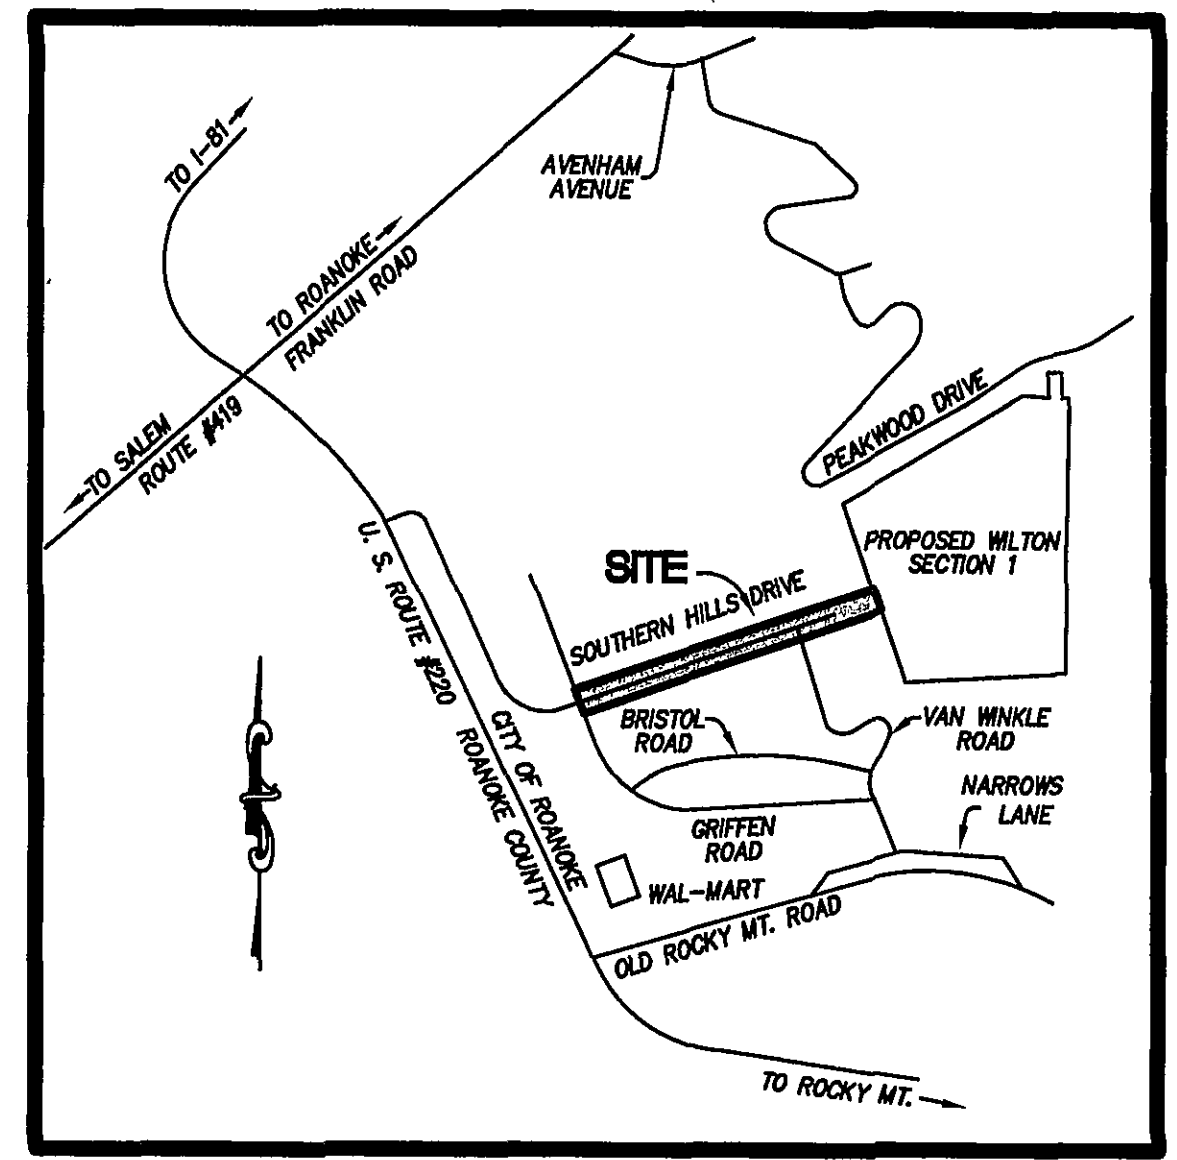

Location Map
Not to Scale



OFFICE OF CITY ENGINEER
ROOM 350
MUNICIPAL BUILDING
215 CHURCH AVENUE, S.W.
ROANOKE, VIRGINIA 24011

INDEX OF SHEETS

SHEET No.	DESCRIPTION
1	COVER SHEET
2	INDEX SHEET, SUMMARY OF QUANTITIES, AND GENERAL NOTES
3	DEMOLITION PLAN
4	DIMENSIONAL LAYOUT, GRADING AND ROAD PROFILES
5	DIMENSIONAL LAYOUT, GRADING AND ROAD PROFILES
6	DIMENSIONAL LAYOUT, GRADING AND ROAD PROFILES
7	STORM DRAIN PROFILE
8	STORM DRAIN PROFILE
9	STORM DRAIN PROFILE
10	EROSION AND SEDIMENT CONTROL PLAN
11	EROSION AND SEDIMENT CONTROL DETAILS
12	CONSTRUCTION DETAILS
13	WATER AND SANITARY SEWER DETAILS
14	WATER AND SANITARY SEWER DETAILS

11/1/07 Asbuilt
JACK BOOTH

CONSULTING ENGINEERS



LUMSDEN ASSOCIATES, P.C.
ENGINEERS-SURVEYORS-PLANNERS
ROANOKE, VIRGINIA

4664 BRAMBLETON AVENUE
P.O. BOX 20669
ROANOKE, VIRGINIA 24018
PHONE: (540) 774-4411
FAX: (540) 772-9445
E-MAIL: MAIL@LUMSDENPC.COM

PROJECT NAME

SOUTHERN HILLS DRIVE ROAD AND
DRAINAGE IMPROVEMENTS

CITY BID NUMBER: 06-04-02

APPROVED FOR CONSTRUCTION

ROANOKE CITY ENGINEER

DATE

DIRECTOR OF PUBLIC WORKS

DATE


ASSISTANT CITY MANAGER FOR OPERATIONS

DATE

DATE

DATE

COMMISSION NUMBER: 2003-374X

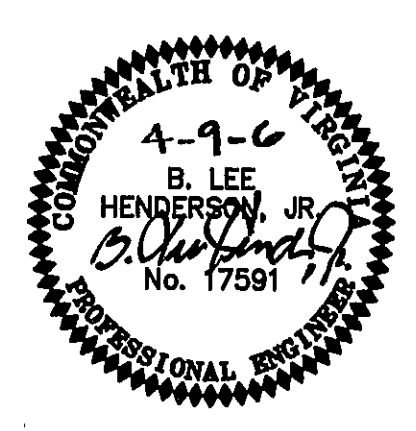

REVISION BY	DESCRIPTION:	DATE
REVISION BY	DESCRIPTION:	DATE
REVISION BY	DESCRIPTION:	DATE
REVISION BY	DESCRIPTION:	DATE

ADVERTISED DATE: APRIL 9, 2006

SET NUMBER: 13

SHEET NUMBER: 1 OF 14