


DESIGNED JTP		SCALE		W/2 NO	
DRAWN JTP		AS		2230	
CHECKED JTP		SHOWN		FILE	
		DATE		R-24	
		1-2-80		SHEET	
				1 OF 1	

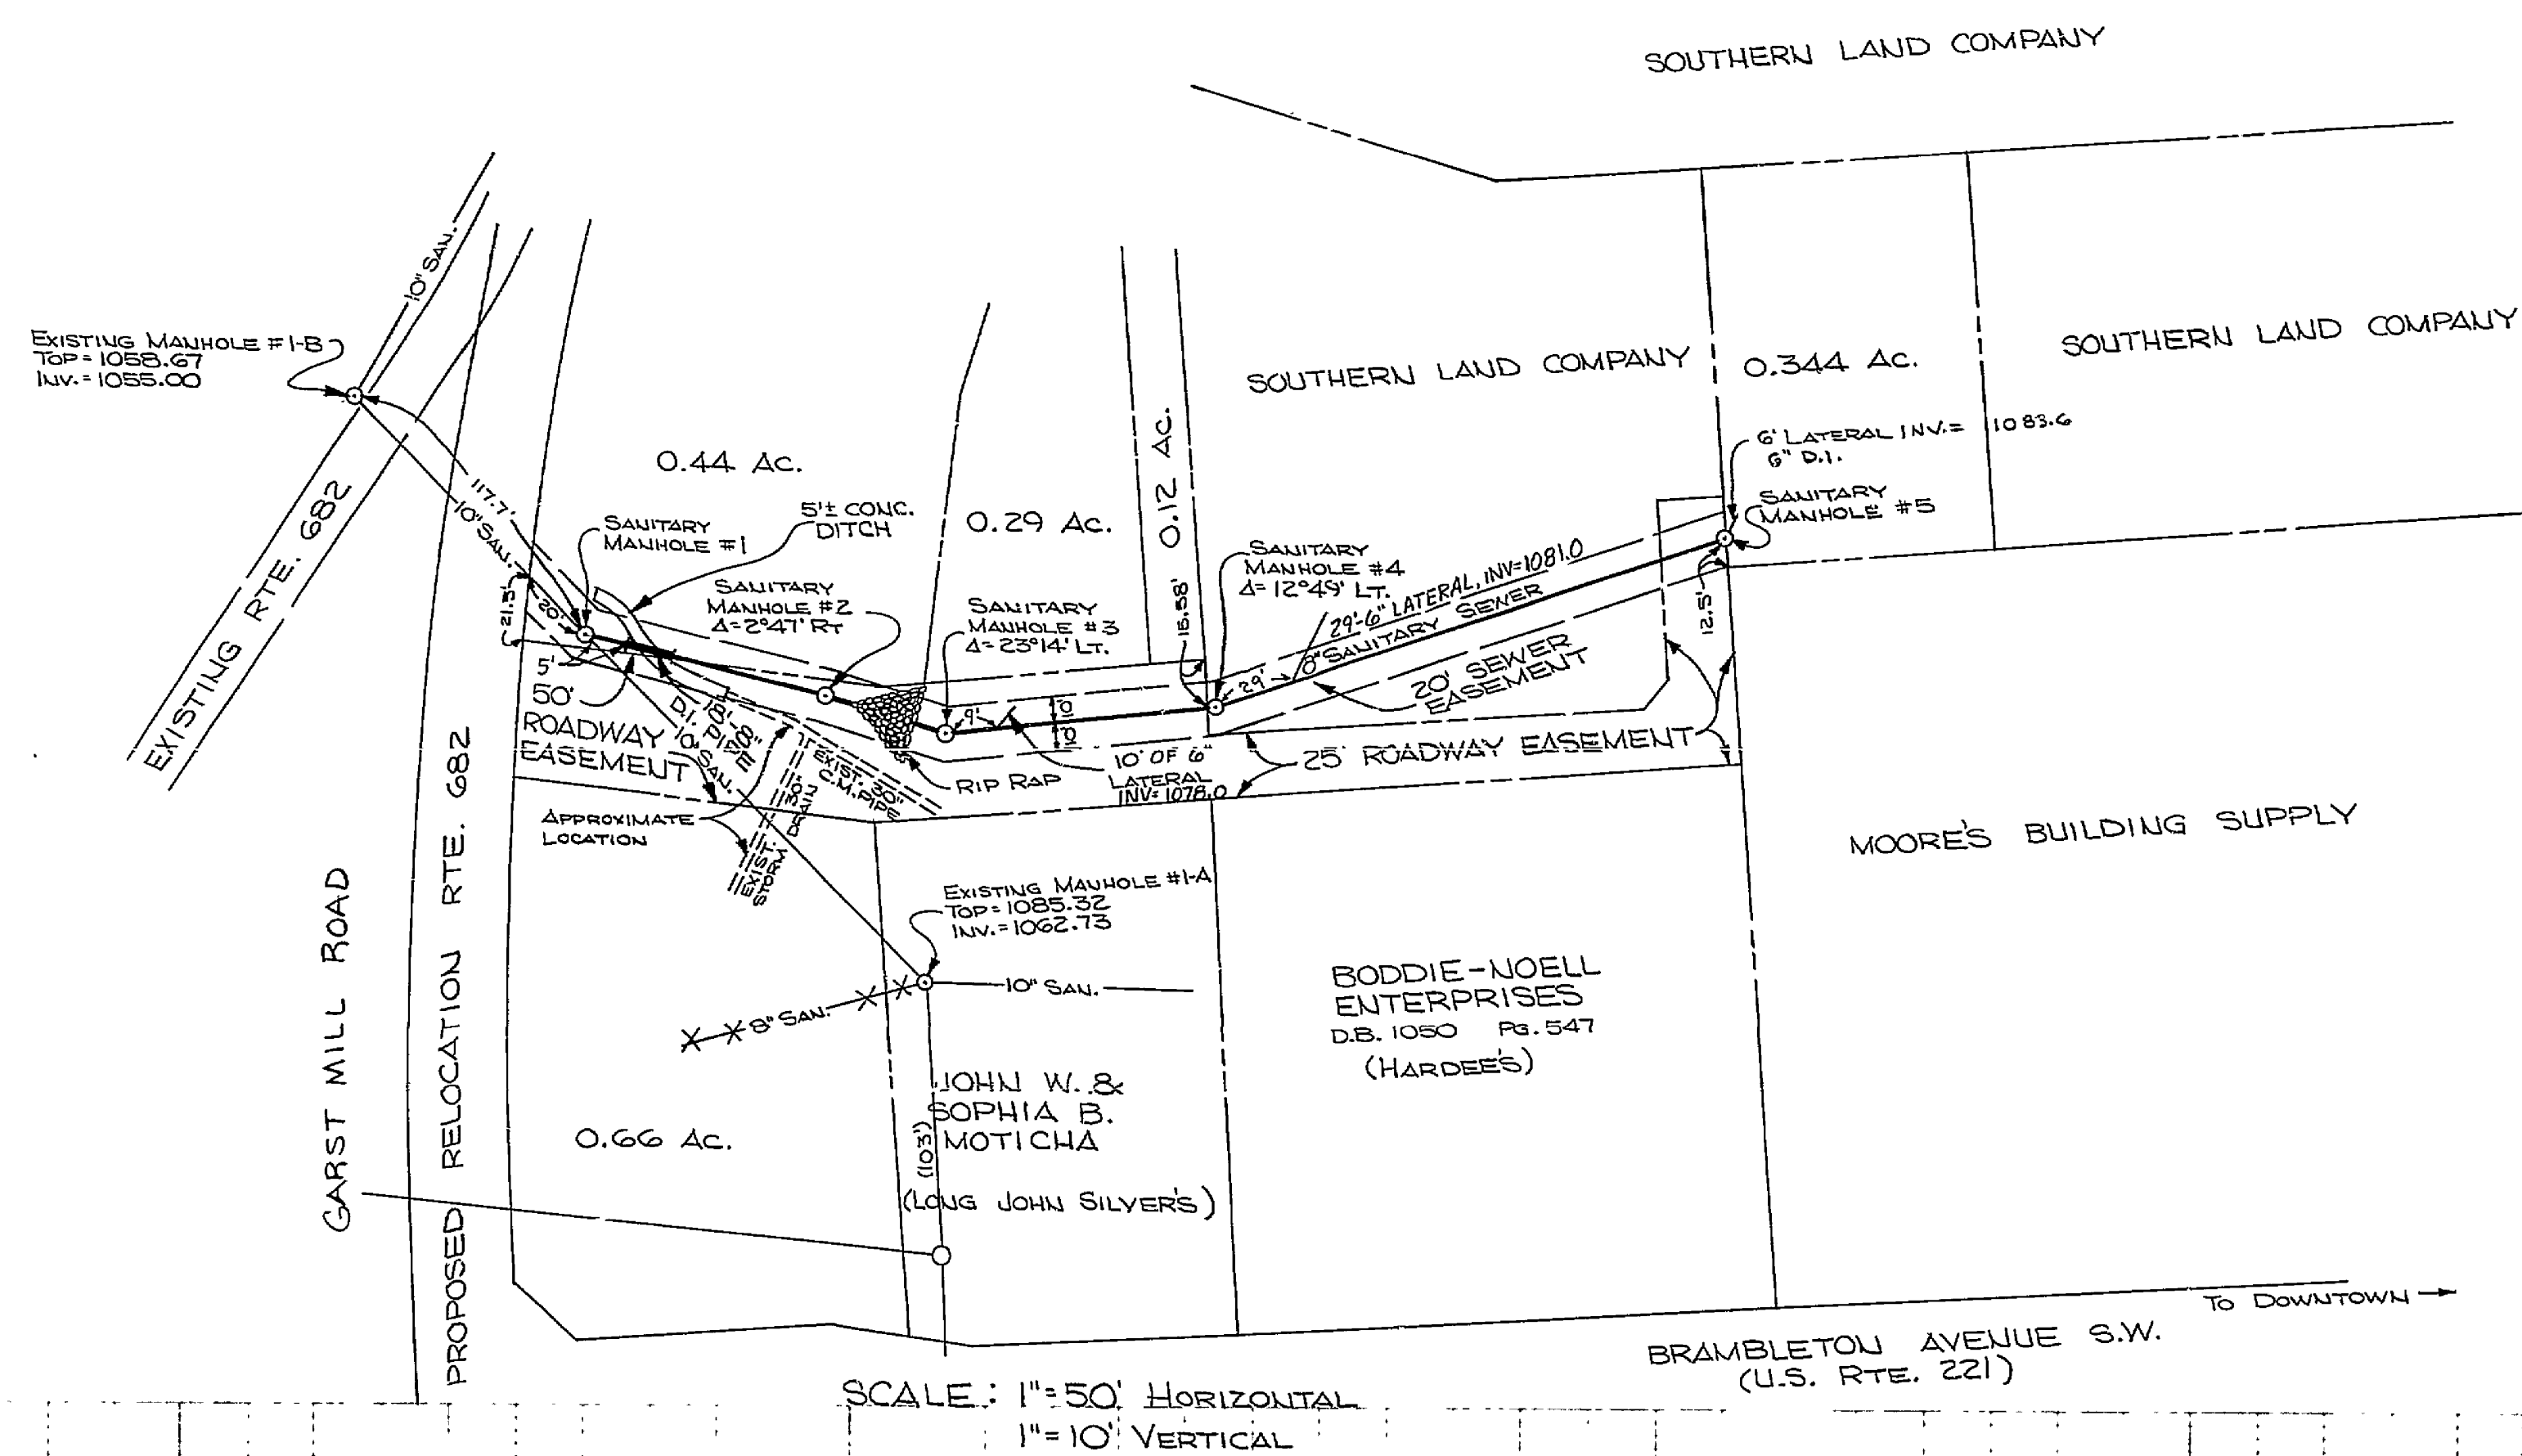