


AS-BUILT for  
Sewer Extension for  
5650 Southern Pines Dr.  
(Southwest Roanoke Co.)

Ken Winslow  
Substantial Completion: 2/24/2005

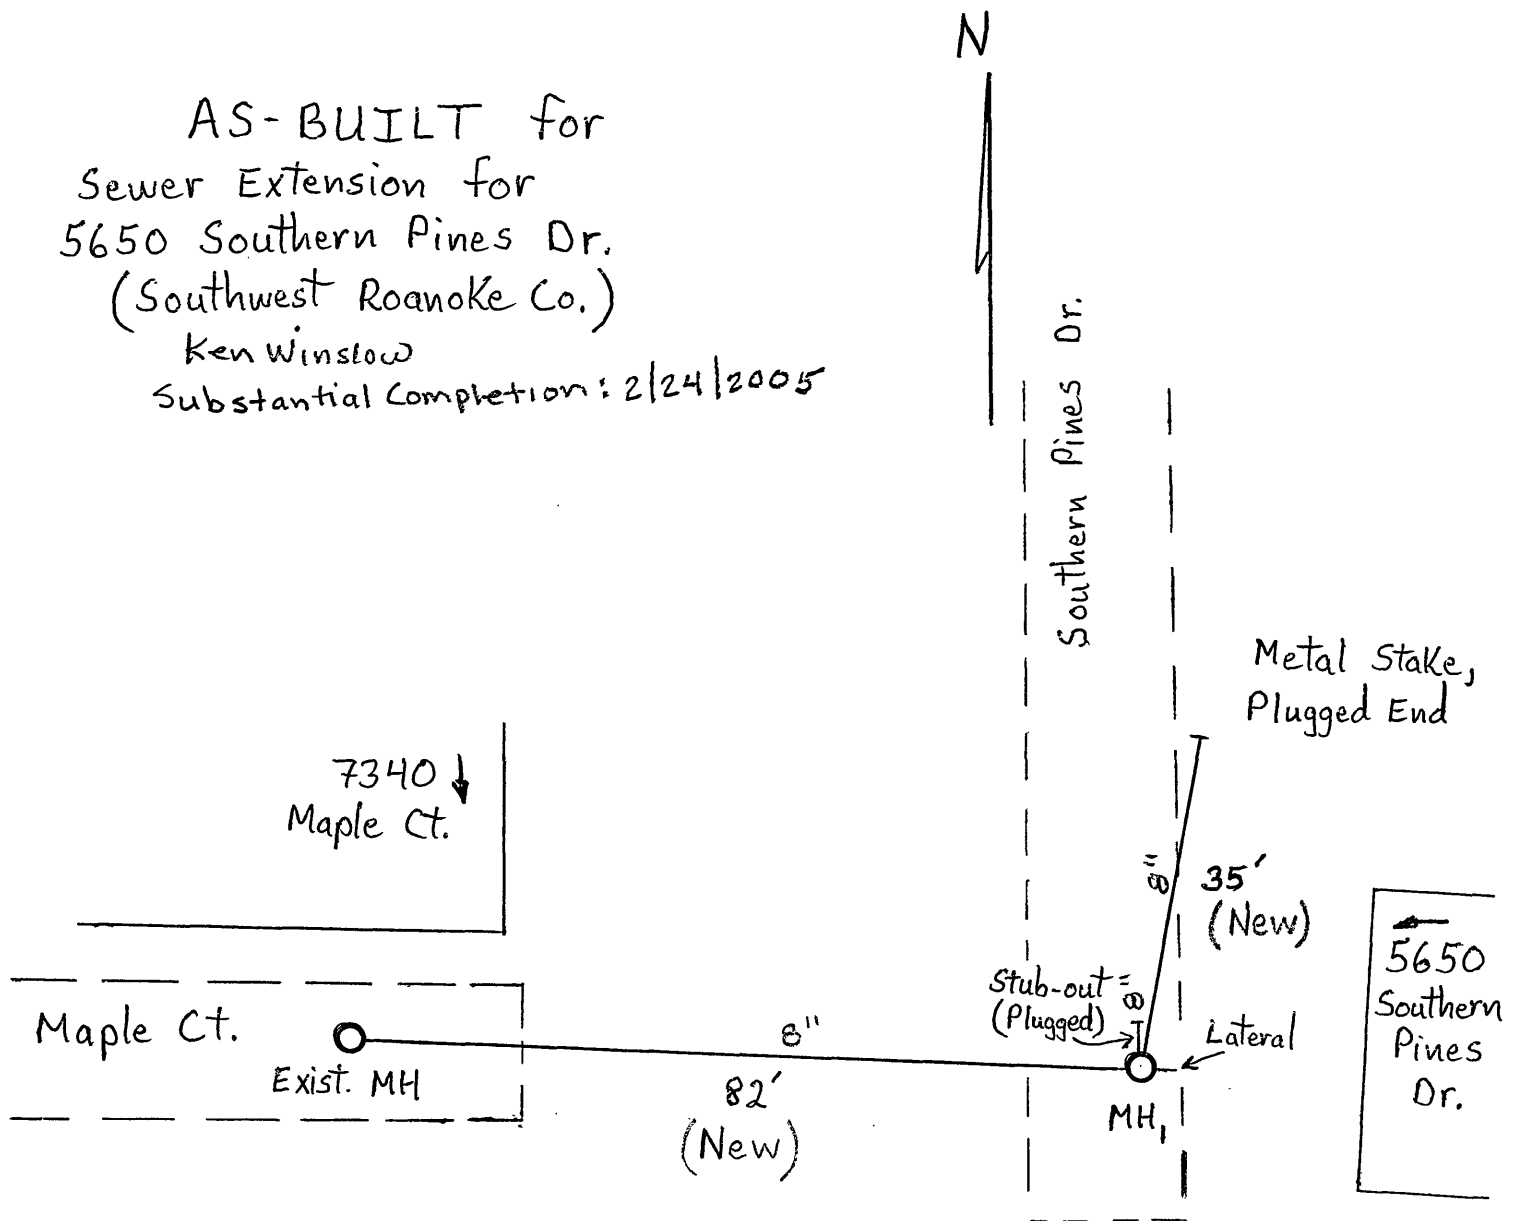

1 MH  
3 MAINS 8"  
1 Lat.  
Total Length → 117'