


Roanoke / Richmond Shenandoah Valley New River Valley / Lynchburg www.balzer.cc

1208 Corporate Circle Roanoke, VA 24018 540.772.9580

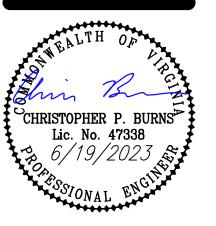

HYUNDAI AM THERN 0 DRAWN BY

BTC BTC 5/16/2022 1" = 30'

DESIGNED BY CHECKED BY DATE SCALE

REVISIONS 7/15/2022

8/10/2022

2/23/2023 PR#1

6/19/2023 PR#2

