
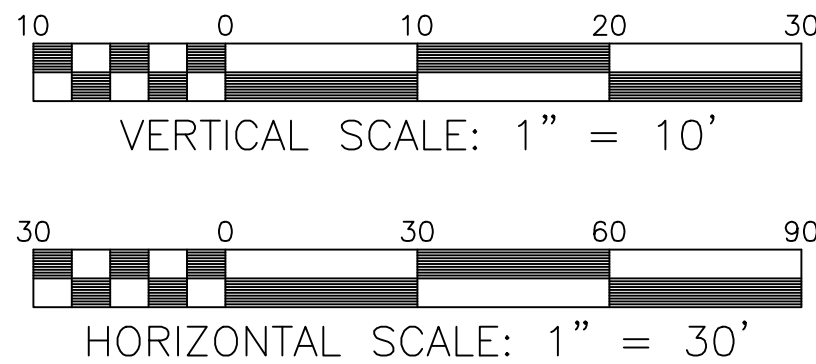
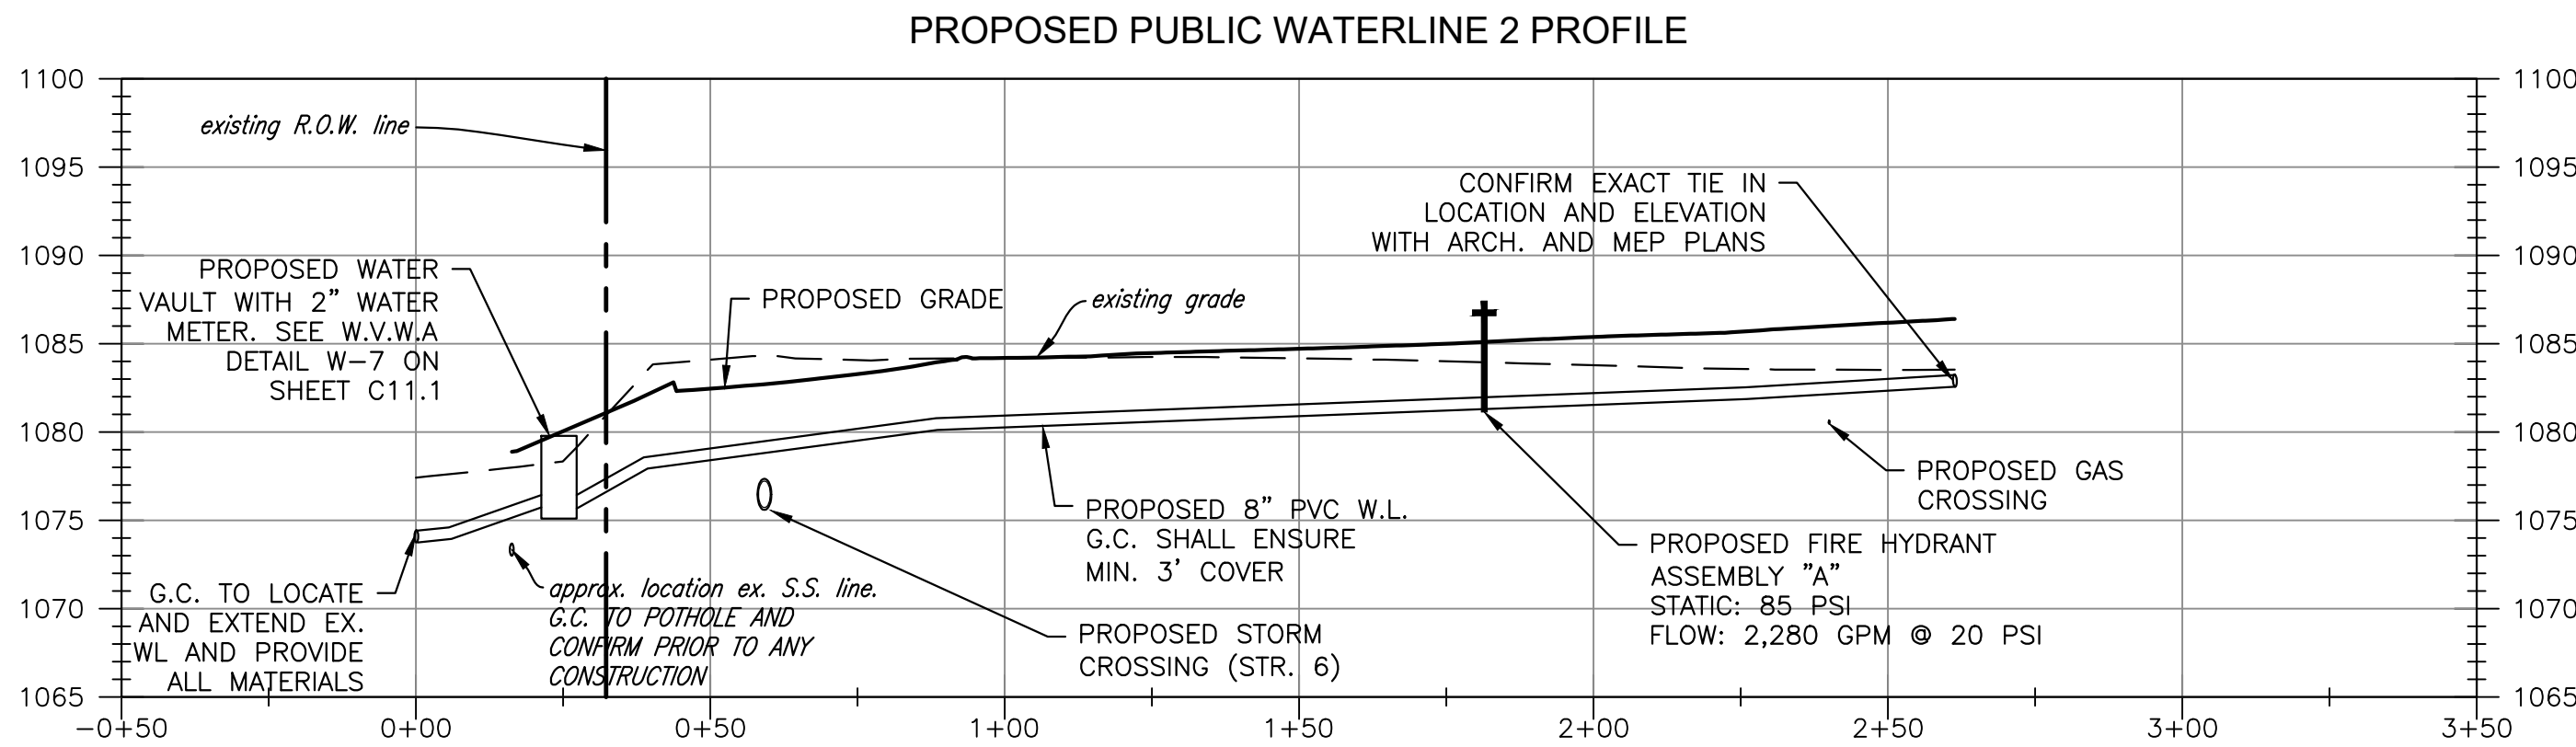
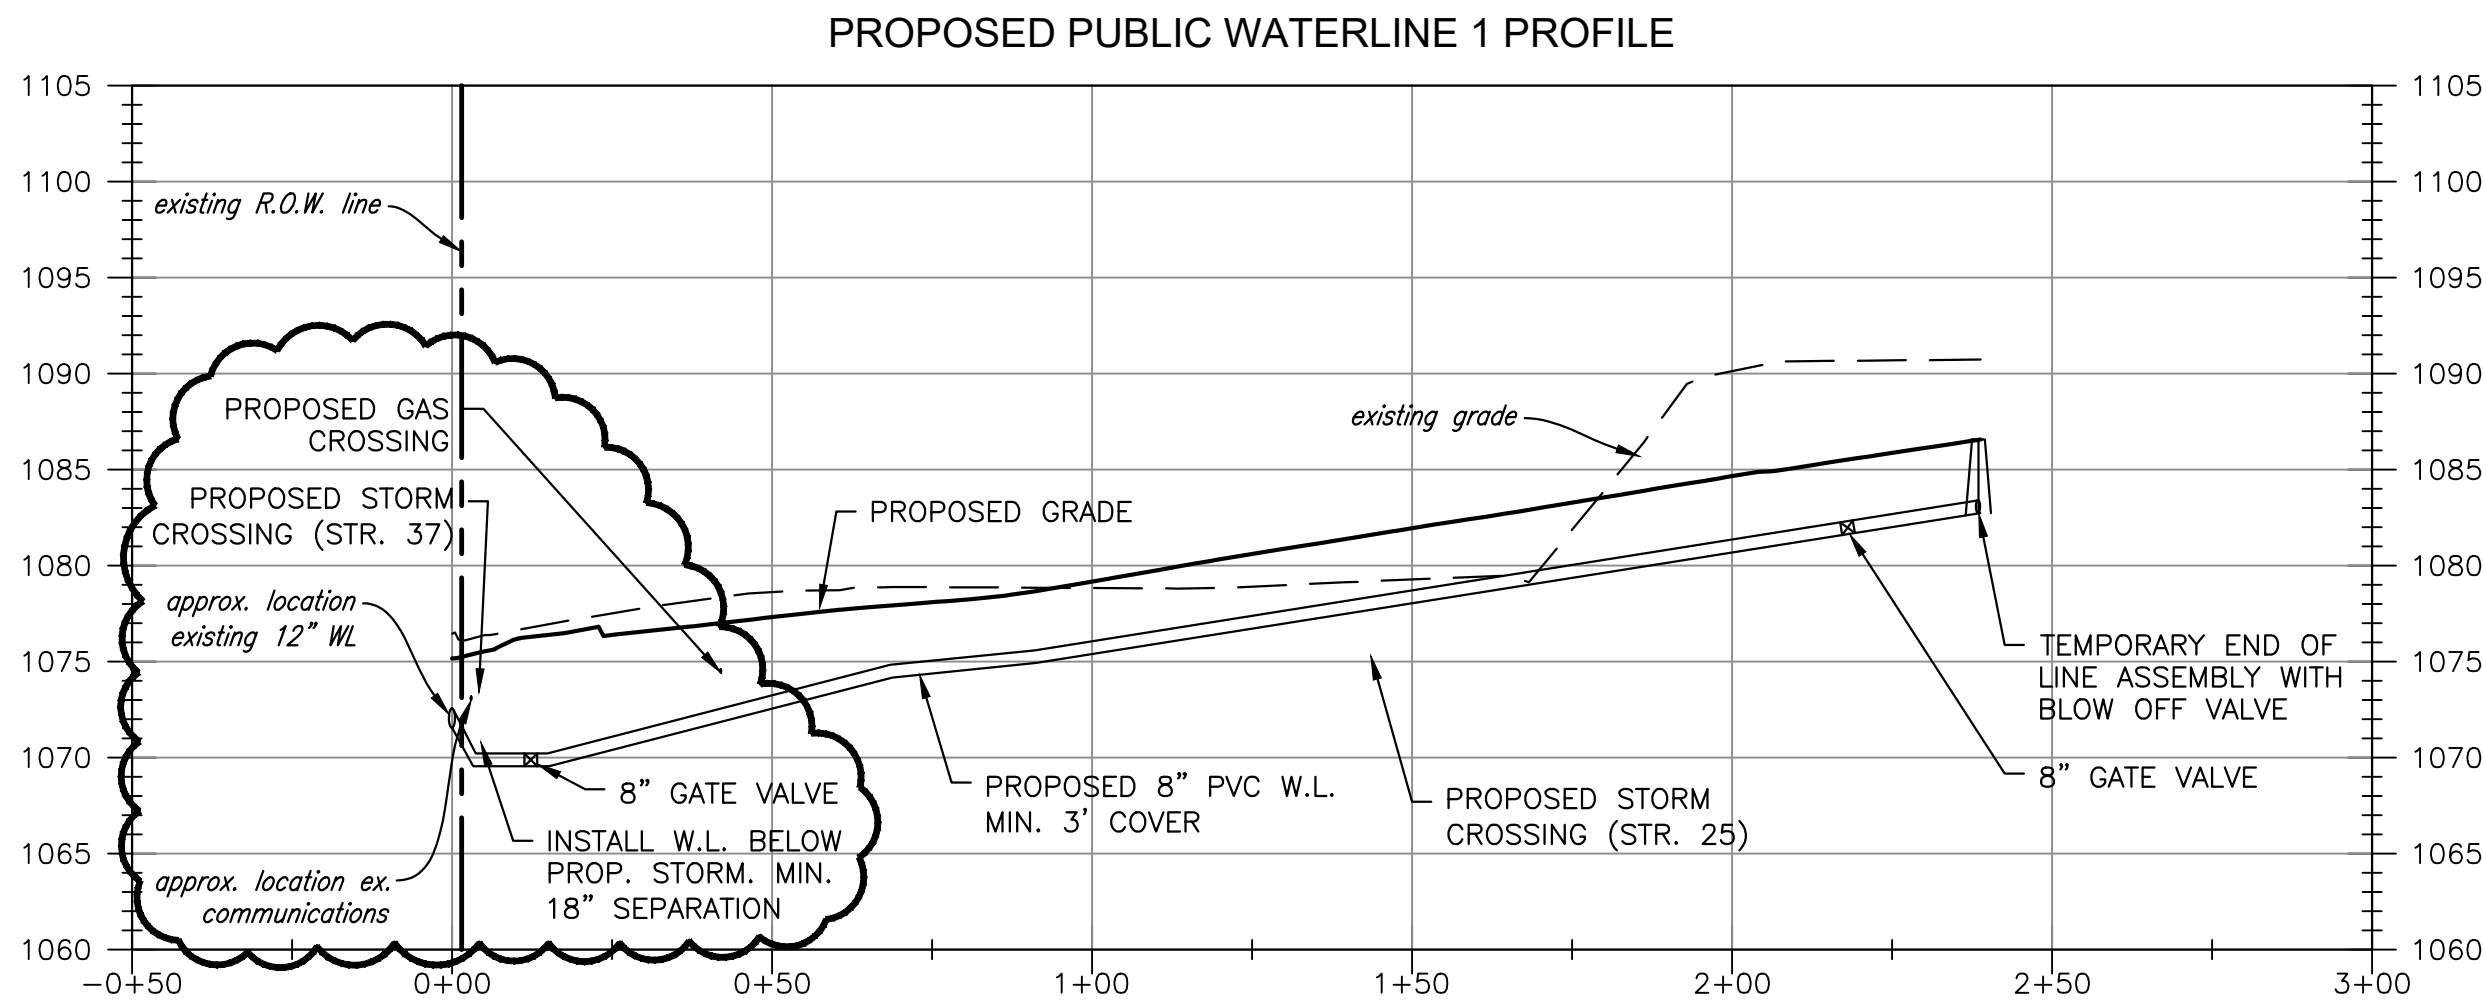


SANITARY SEWER SCHEDULE:

- (A) PUBLIC S.S. MANHOLE W/ ST'D LID
TOP= 1086.58
INV. OUT= 1080.00
- (A) (B) 26 LF OF 8" SDR-35 PVC AT 3.88%
- (B) PUBLIC S.S. MANHOLE W/ ST'D LID
TOP=1085.21
INV. IN= 1079.00
INV. OUT= 1078.90
- (B) (C) 233 LF OF 8" SDR-35 PVC AT 0.51%
- (C) PUBLIC S.S. MANHOLE W/ ST'D LID
TOP=1084.96
INV. IN= 1077.70
INV. IN= 1077.70
INV. OUT= 1077.60
- (C) (D) 117 LF OF 8" SDR-35 PVC AT 0.60%
- (D) PUBLIC S.S. MANHOLE W/ ST'D LID
TOP=1081.50
INV. IN= 1076.90 (8" MAIN)
INV. OUT= 1076.80
- (D) (E) 50 LF OF 8" SDR-35 PVC AT 0.60%
- (E) PUBLIC S.S. MANHOLE W/ ST'D LID
TOP=1081.40
INV. IN= 1076.50
INV. OUT= 1076.40
- (E) (F) 68 LF OF 8" SDR-35 PVC AT 2.07%
- (F) PUBLIC S.S. MANHOLE W/ST'D LID
TOP=1079.10
INV. IN= 1075.00
EX. INV. OUT: G.C. TO CONFIRM
G.C. SHALL POT HOLE AND VERIFY EXACT
LOCATION (HORIZONTAL AND VERTICAL) OF
EXISTING SANITARY SEWER PIPE PRIOR TO
CONSTRUCTION.
- (G) PUBLIC SAMPLING MANHOLE
TOP= 1085.22
INV. IN= 1078.00
INV. IN= 1078.00
INV. OUT= 1077.90
COORD. EXACT INVERT AND TIE IN
LOCATION WITH ARCH. AND MEP PLANS
SEPARATE TROUGHS FROM THE UPSTREAM
INVERTS SHALL BE PROVIDED WITHIN M.H.
G FOR SAMPLING PURPOSES
- (G) (C) 21 LF OF 8" SDR-26 PVC AT 0.97%

NOTES:
1. G.C. TO CONFIRM & COORDINATE ALL BUILDING
TIE-IN LOCATIONS WITH M.E.P. AND ARCHITECTURAL
DRAWINGS PRIOR TO CONSTRUCTION OF LATERALS.
2. G.C. TO CONFIRM ALL TIE-IN LOCATIONS TO
EXISTING LINES PRIOR TO CONSTRUCTION AND
NOTIFY THE ENGINEER OF ANY DISCREPANCIES.
3. G.C. SHALL CORE DRILL EXISTING MANHOLE AND
PROVIDE FLEXIBLE BOOT CONNECTION FOR
PROPOSED TIE IN CONNECTION.

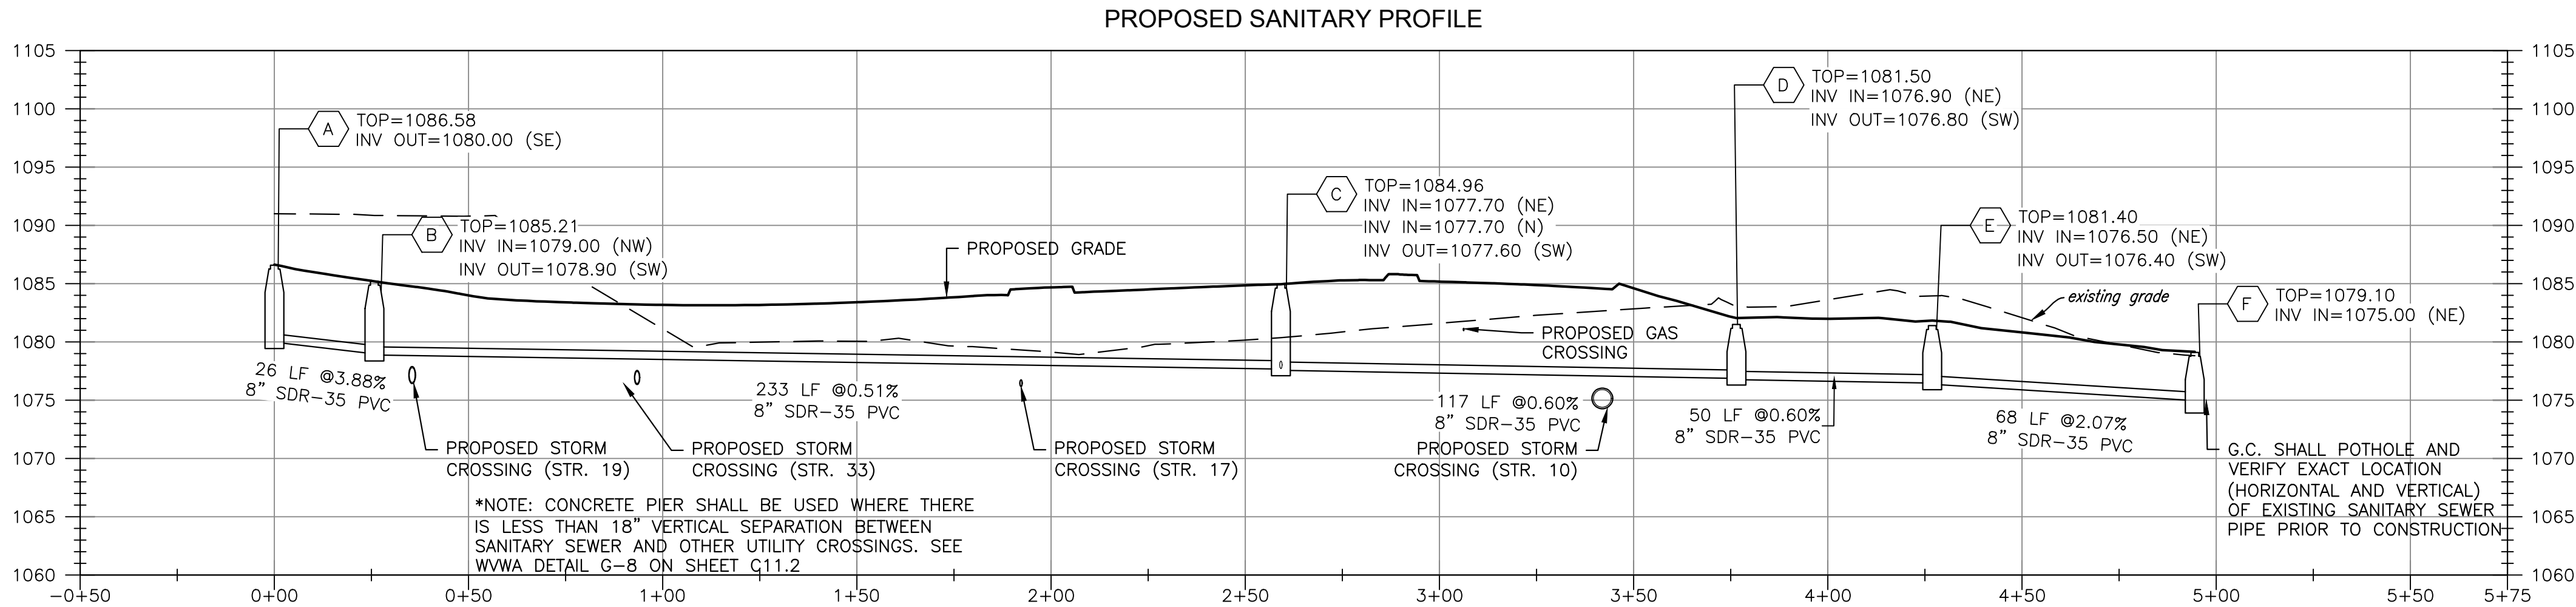

**BALZER
& ASSOCIATES**
PLANNERS / ARCHITECTS
ENGINEERS / SURVEYORS

Roanoke / Richmond
Shenandoah Valley
New River Valley / Lynchburg

www.balzer.cc

1208 Corporate Circle
Roanoke, VA 24018
540.772.9580



SOUTHERN TEAM HYUNDAI

UTILITY PROFILES II

730 WILLIAMSON ROAD
ROANOKE COUNTY, VIRGINIA

DRAWN BY KAM
DESIGNED BY BTC
CHECKED BY BTC
DATE 5/16/2022
SCALE AS SHOWN
REVISIONS
7/15/2022

8/10/2022

2/23/2023 PR#1

6/19/2023 PR#2

C8.2
PROJECT NO. 04220008.00