


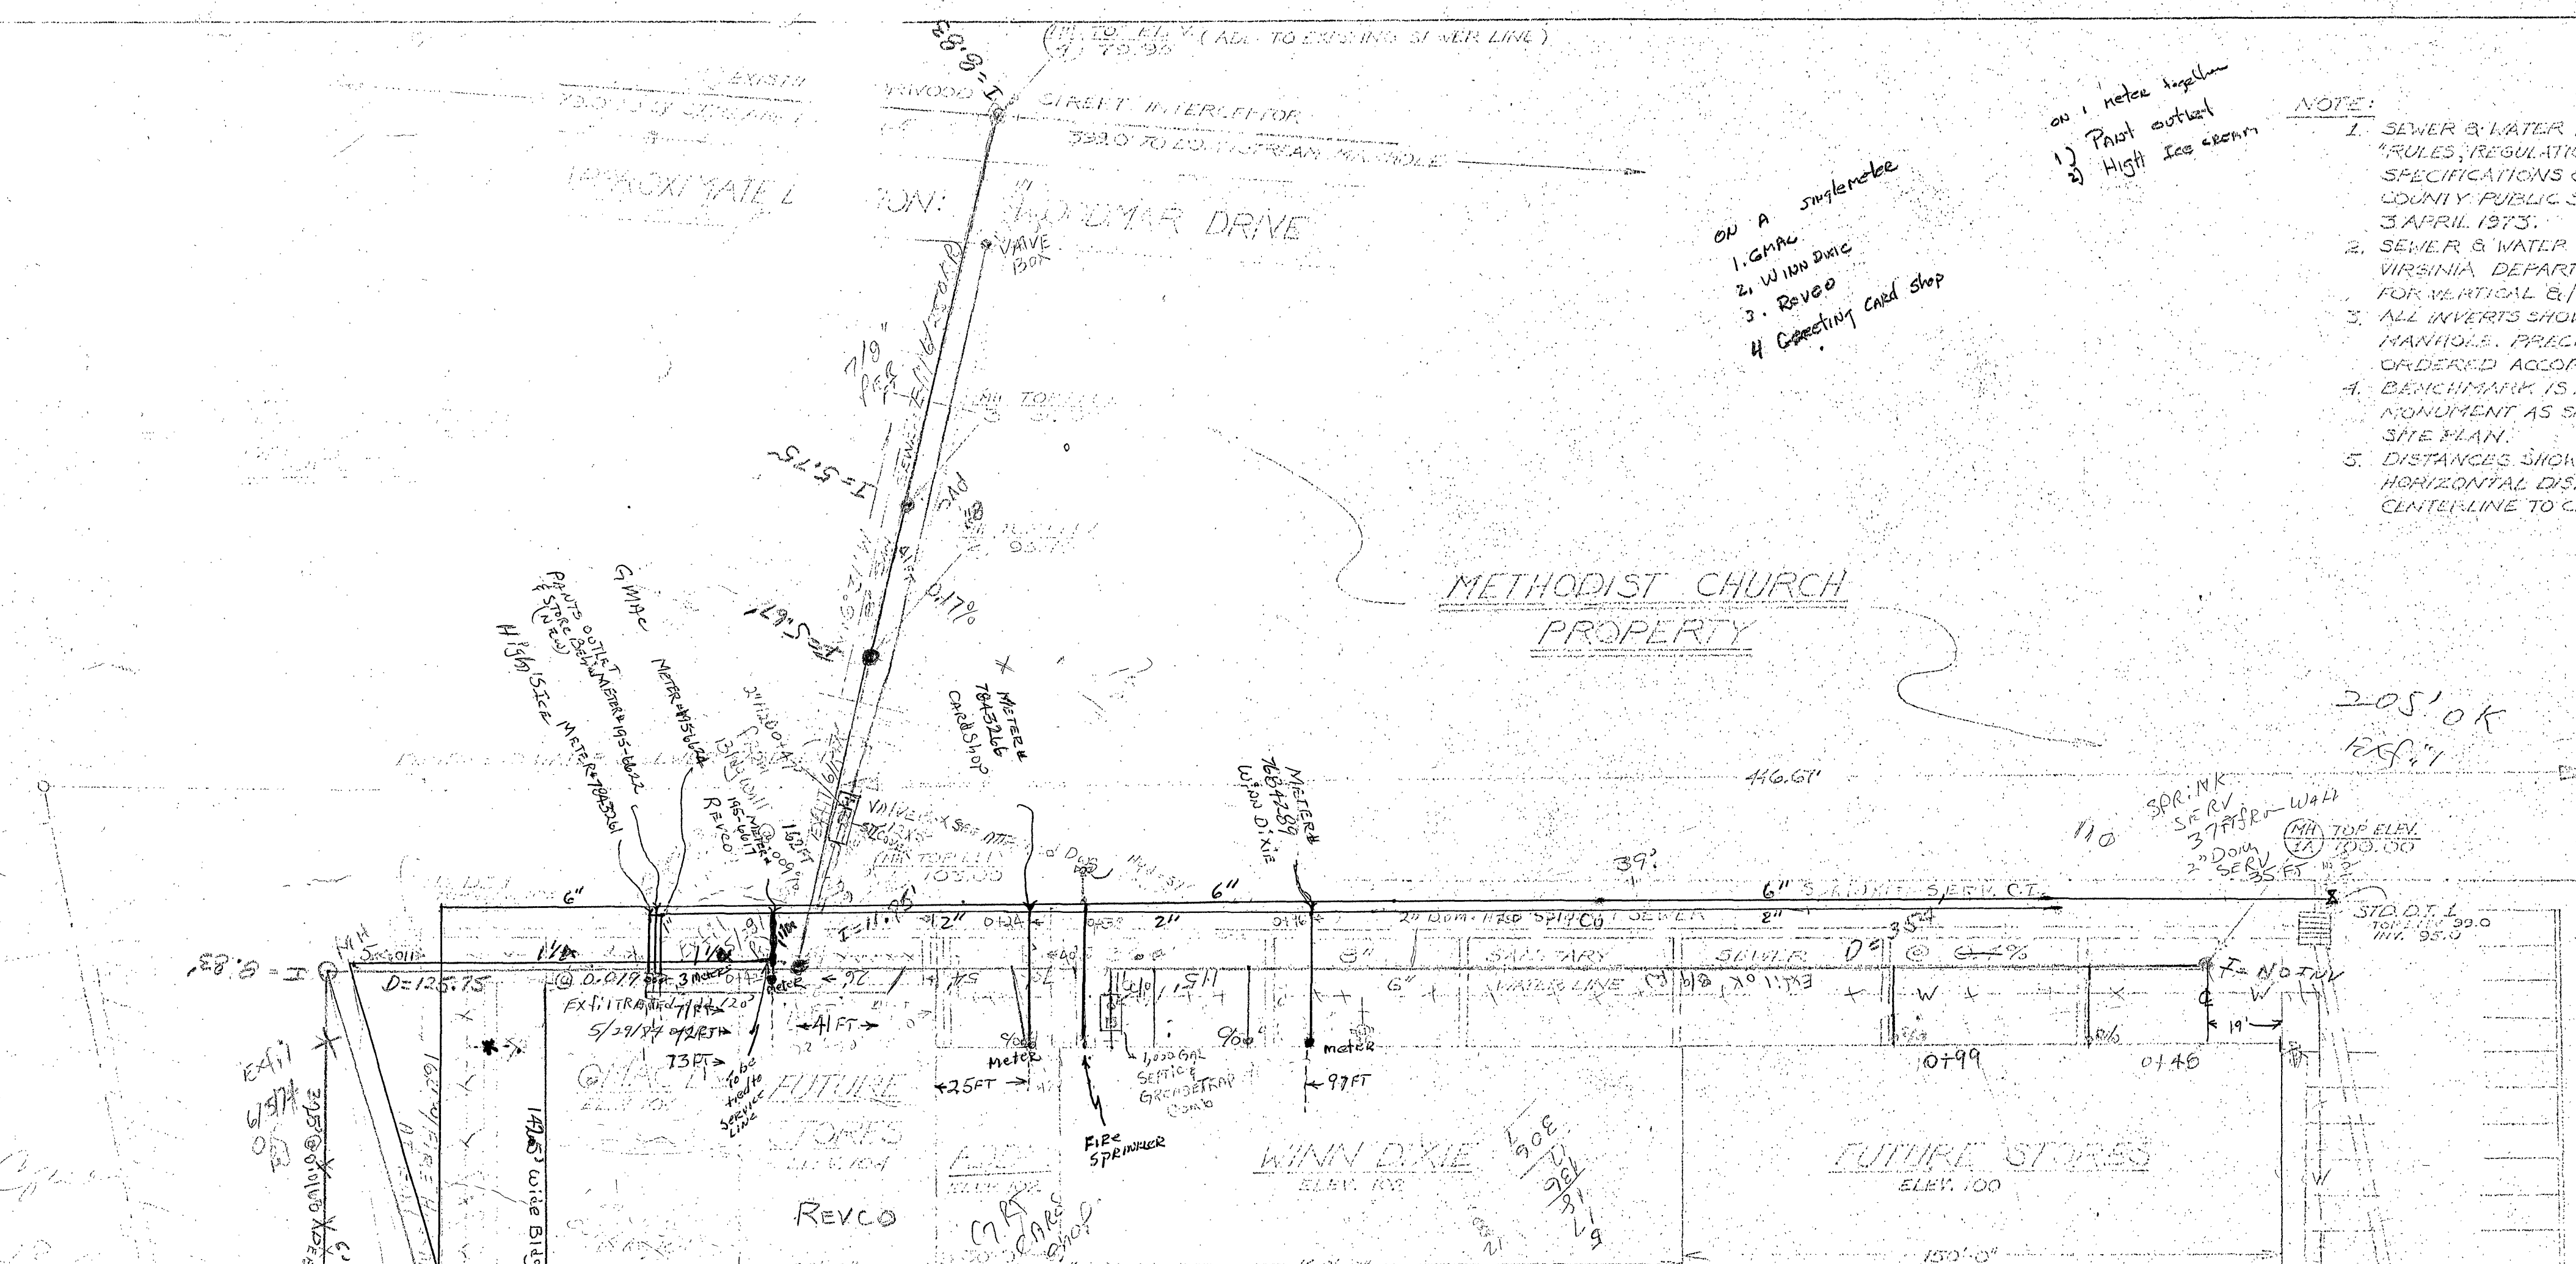

DATE	10/1/78
DESIGNED BY	DRAPER, MARKS, ADEN
DRAWN BY	CLARK, JAMES, INC.
CHECKED BY	CLARK, JAMES, INC.
APPROVED BY	CLARK, JAMES, INC.
PROJECT	SOUTHWEST PLAZA
LOCATION	SHOPPING CENTER
REVISIONS	
NO.	1
DATE	10/1/78
BY	CLARK, JAMES, INC.
REASON	SCHEMATIC PRELIMINARY
PLANTING	23

SOUTHWEST PLAZA SHOPPING CENTER

322.25
 31.25
 354.00

14" x 11" (11" x 14")
 1/4" = 10' (1/4" = 10')
 1/8" = 5' (1/8" = 5')
 1/16" = 2.5' (1/16" = 2.5')
 1/32" = 1.25' (1/32" = 1.25')

1/4" = 10' (1/4" = 10')
 1/8" = 5' (1/8" = 5')
 1/16" = 2.5' (1/16" = 2.5')
 1/32" = 1.25' (1/32" = 1.25')