


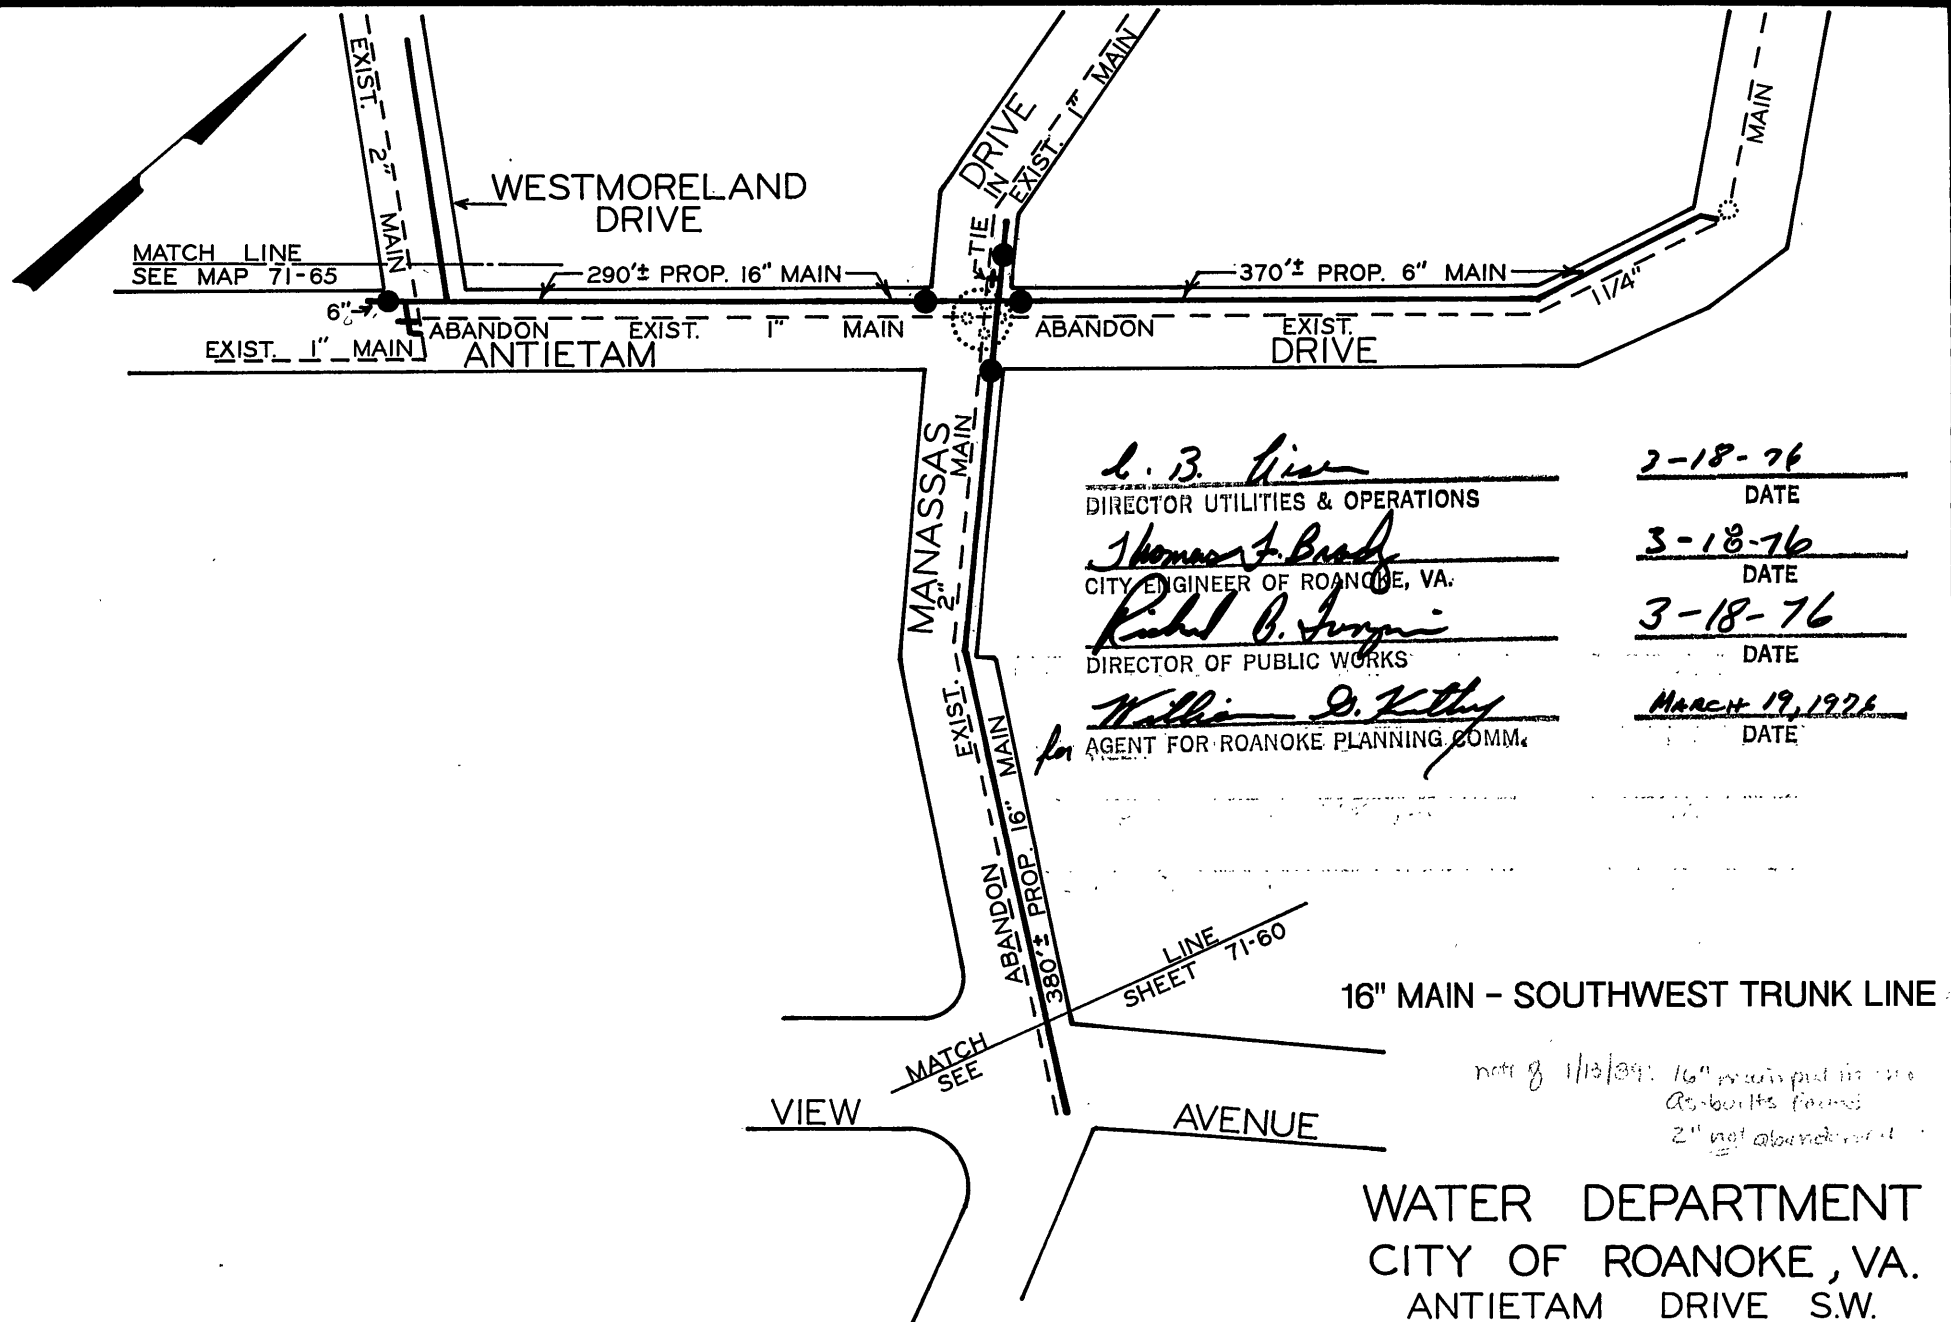

L. B. Lisen
 DIRECTOR UTILITIES & OPERATIONS

Thomas F. Brady
 CITY ENGINEER OF ROANOKE, VA.

Rubel B. Jorgensen
 DIRECTOR OF PUBLIC WORKS

William D. Kethy
 for AGENT FOR ROANOKE PLANNING COMM.

2-18-76
 DATE

3-18-76
 DATE

3-18-76
 DATE

MARCH 19, 1976
 DATE

LINE
 SHEET 71-60

16" MAIN - SOUTHWEST TRUNK LINE

note 8 1/13/89: 16" main put in 1970
 as built's found
 2" not abandoned

WATER DEPARTMENT
 CITY OF ROANOKE, VA.
 ANTIETAM DRIVE S.W.
 SCALE - 1" = 100'
 DRAWN BY C.A.H. DEC. 28, 1971