



#274

FILE NUMBER
274

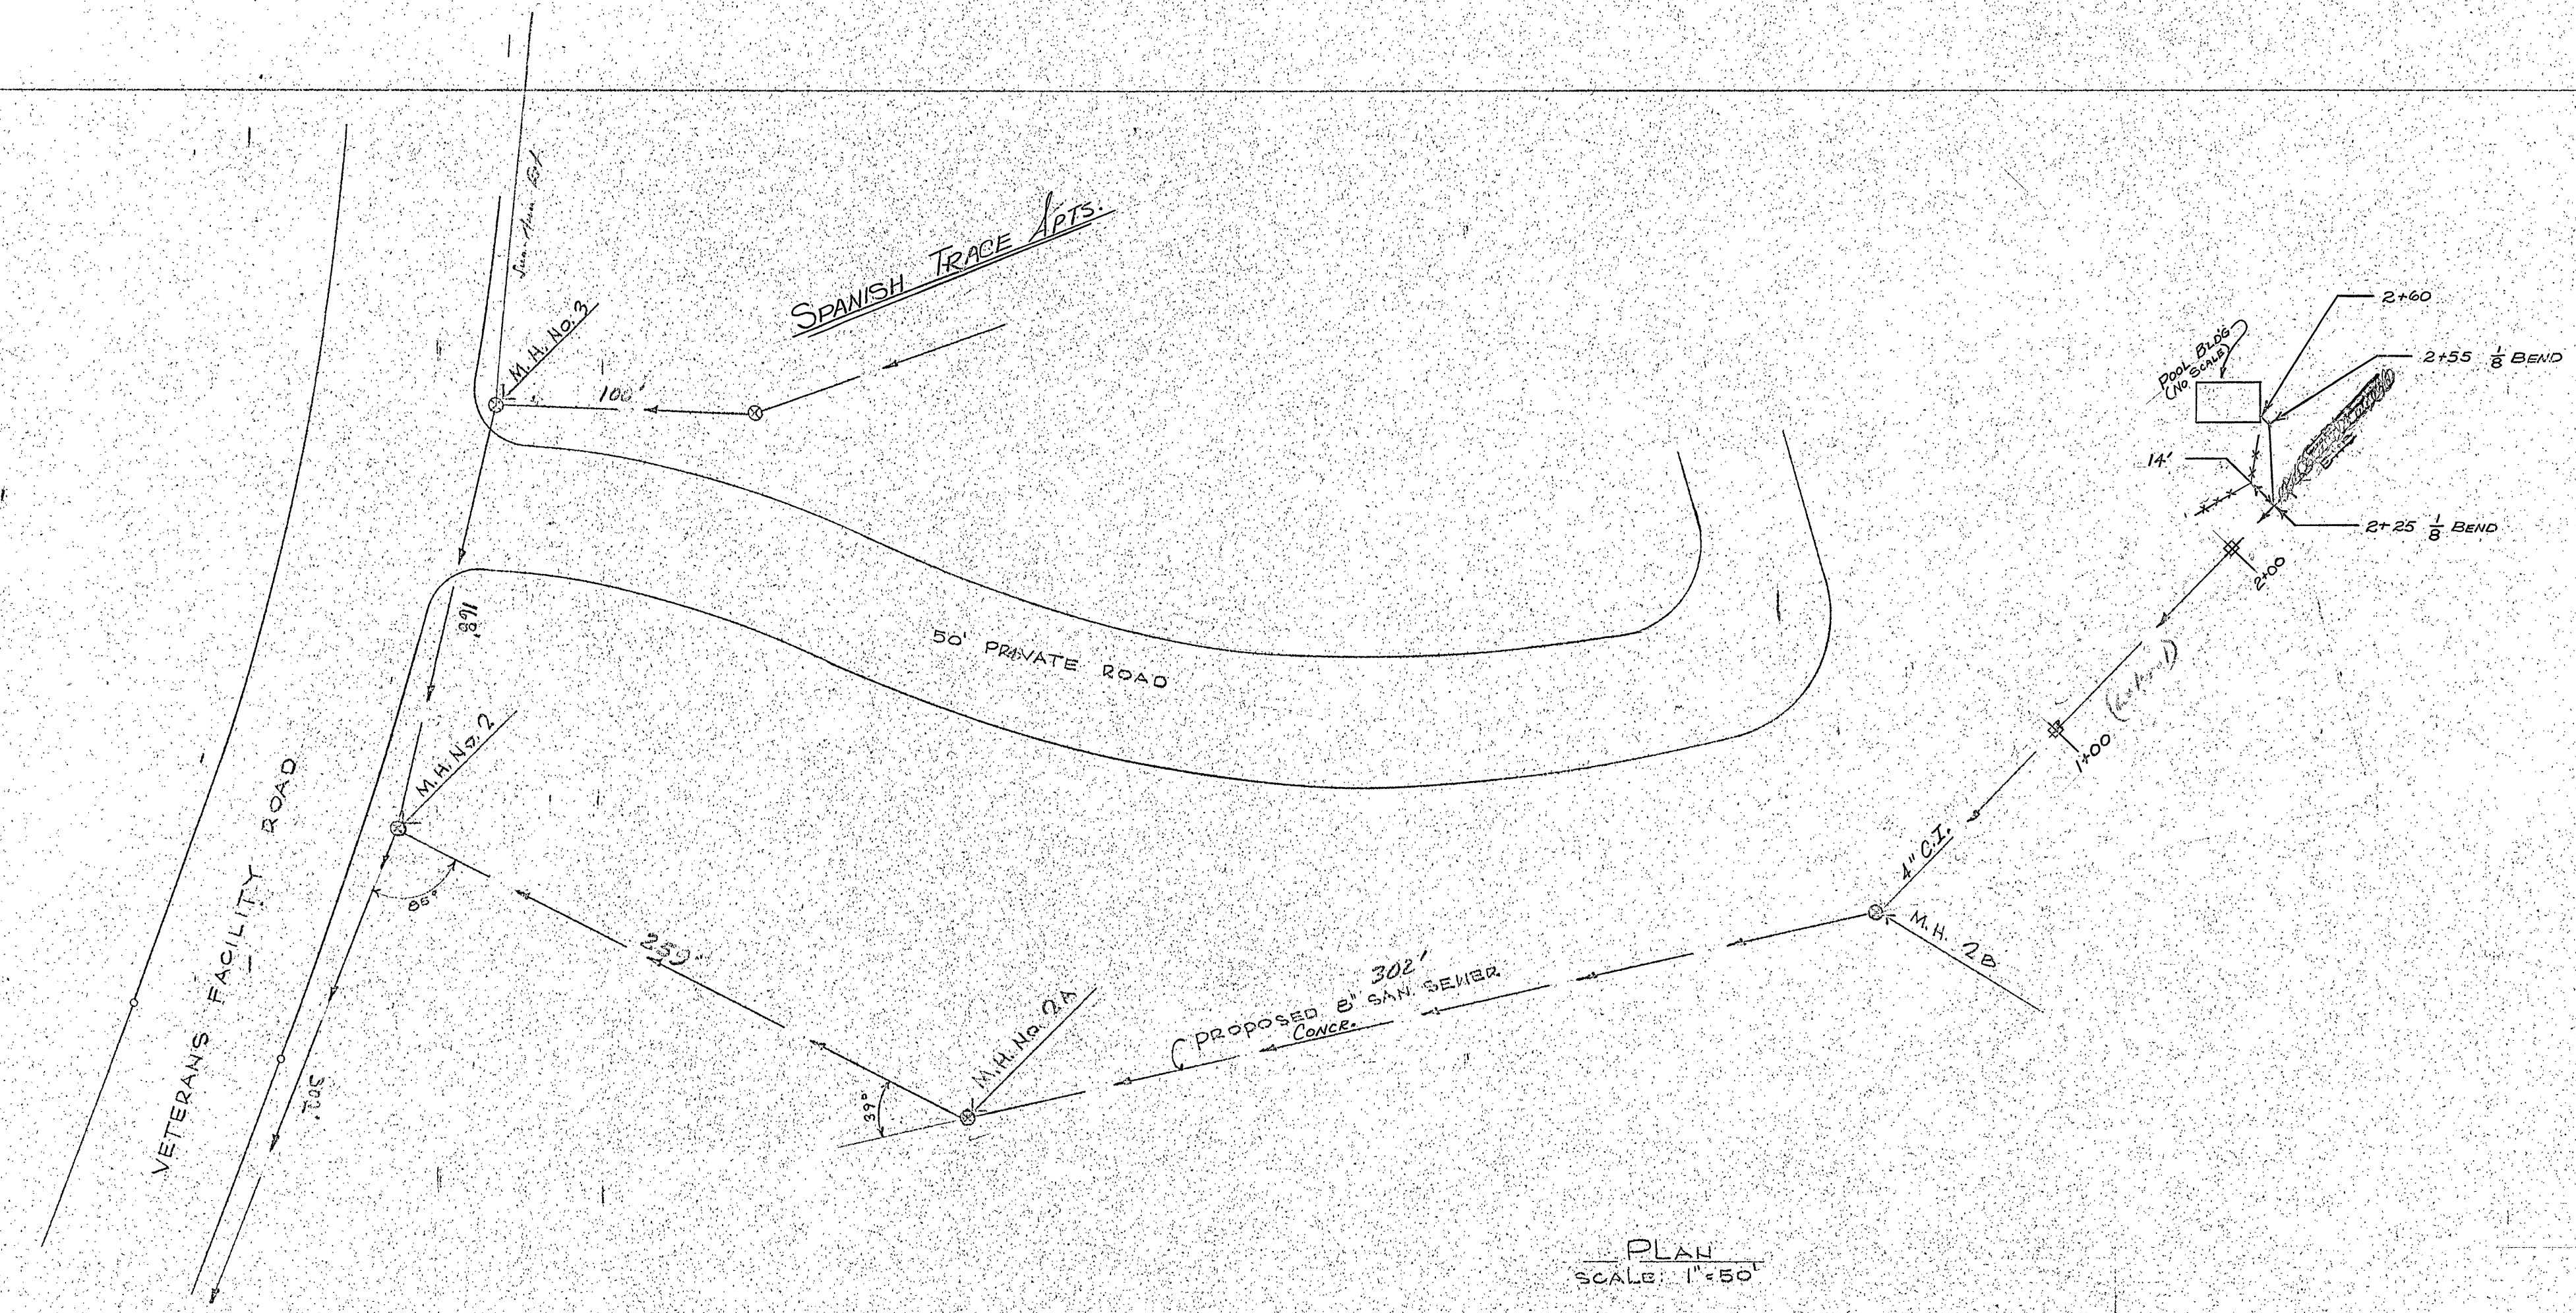

As BUILT PLAN
Insp. By: E. Hurst

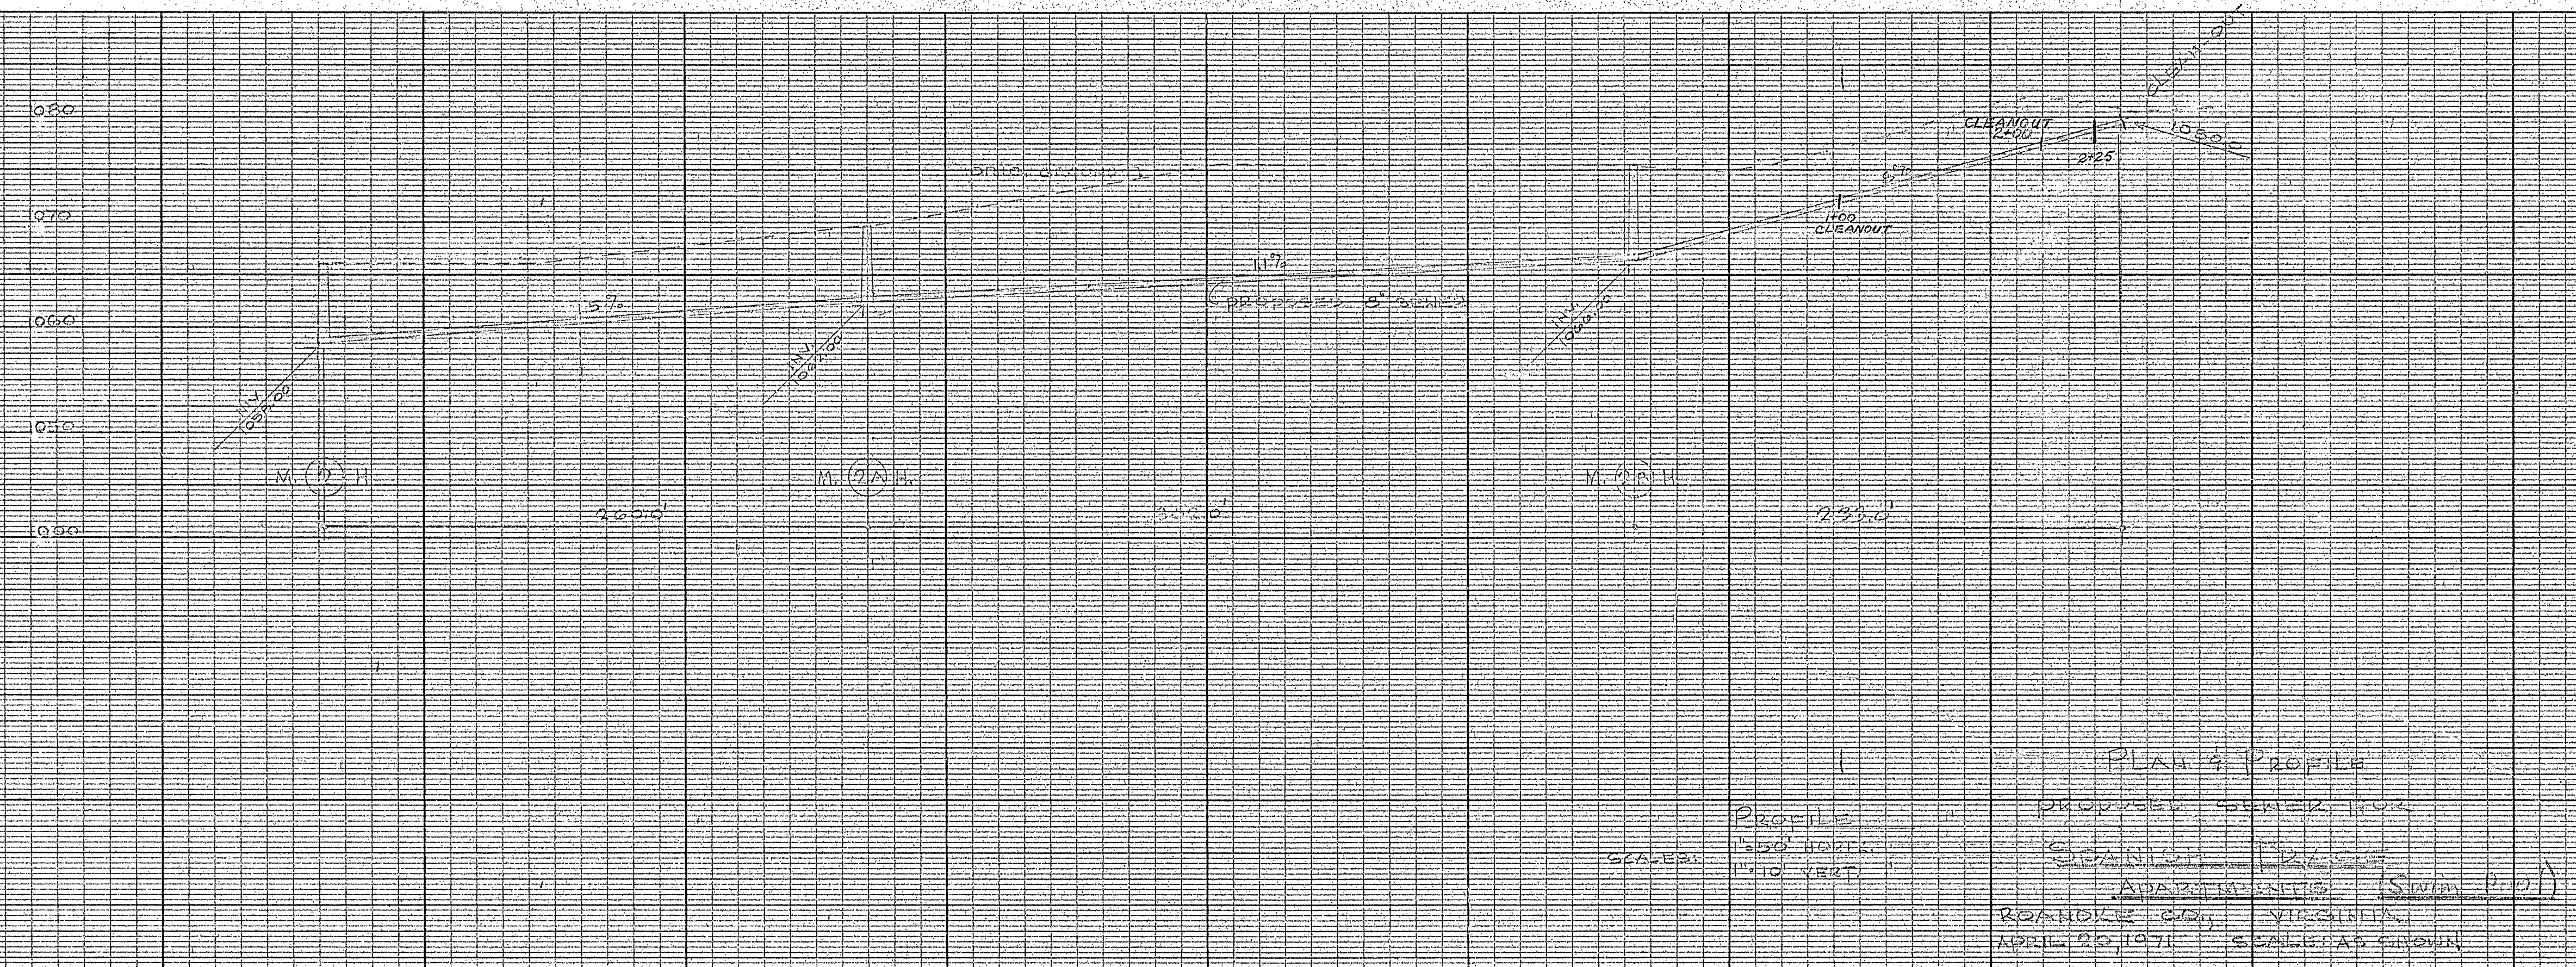

PLAN & PROFILE
PROPOSED SEWER LINE
SPANISH TRACE
APPROXIMATE (SOUTH END)
ROAD NO. 274, VIRGINIA
APRIL 20, 1971 SCALE: 1" = 50' VERT.

SPANISH TRACE