


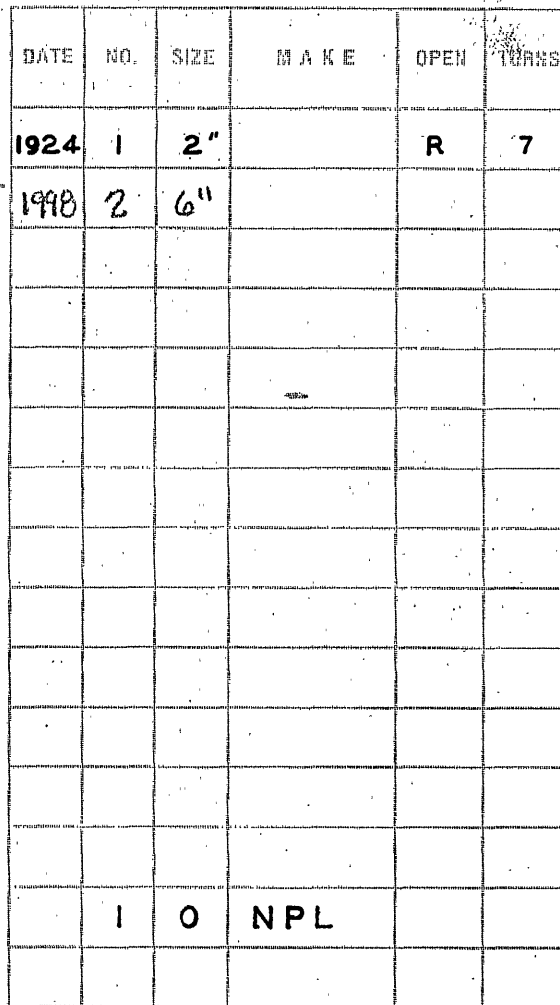

S T.

CITY OF ROANOKE—WATER DEPT
VALVE DIAGRAM

STANLEY AVE. & 26TH.
ST. SOUTH EAST

SEC. MAP 408

DATE _____ PAGE NO. **S.W. 222**

11/19/42 J.H.W.
12/22/42 CCH