


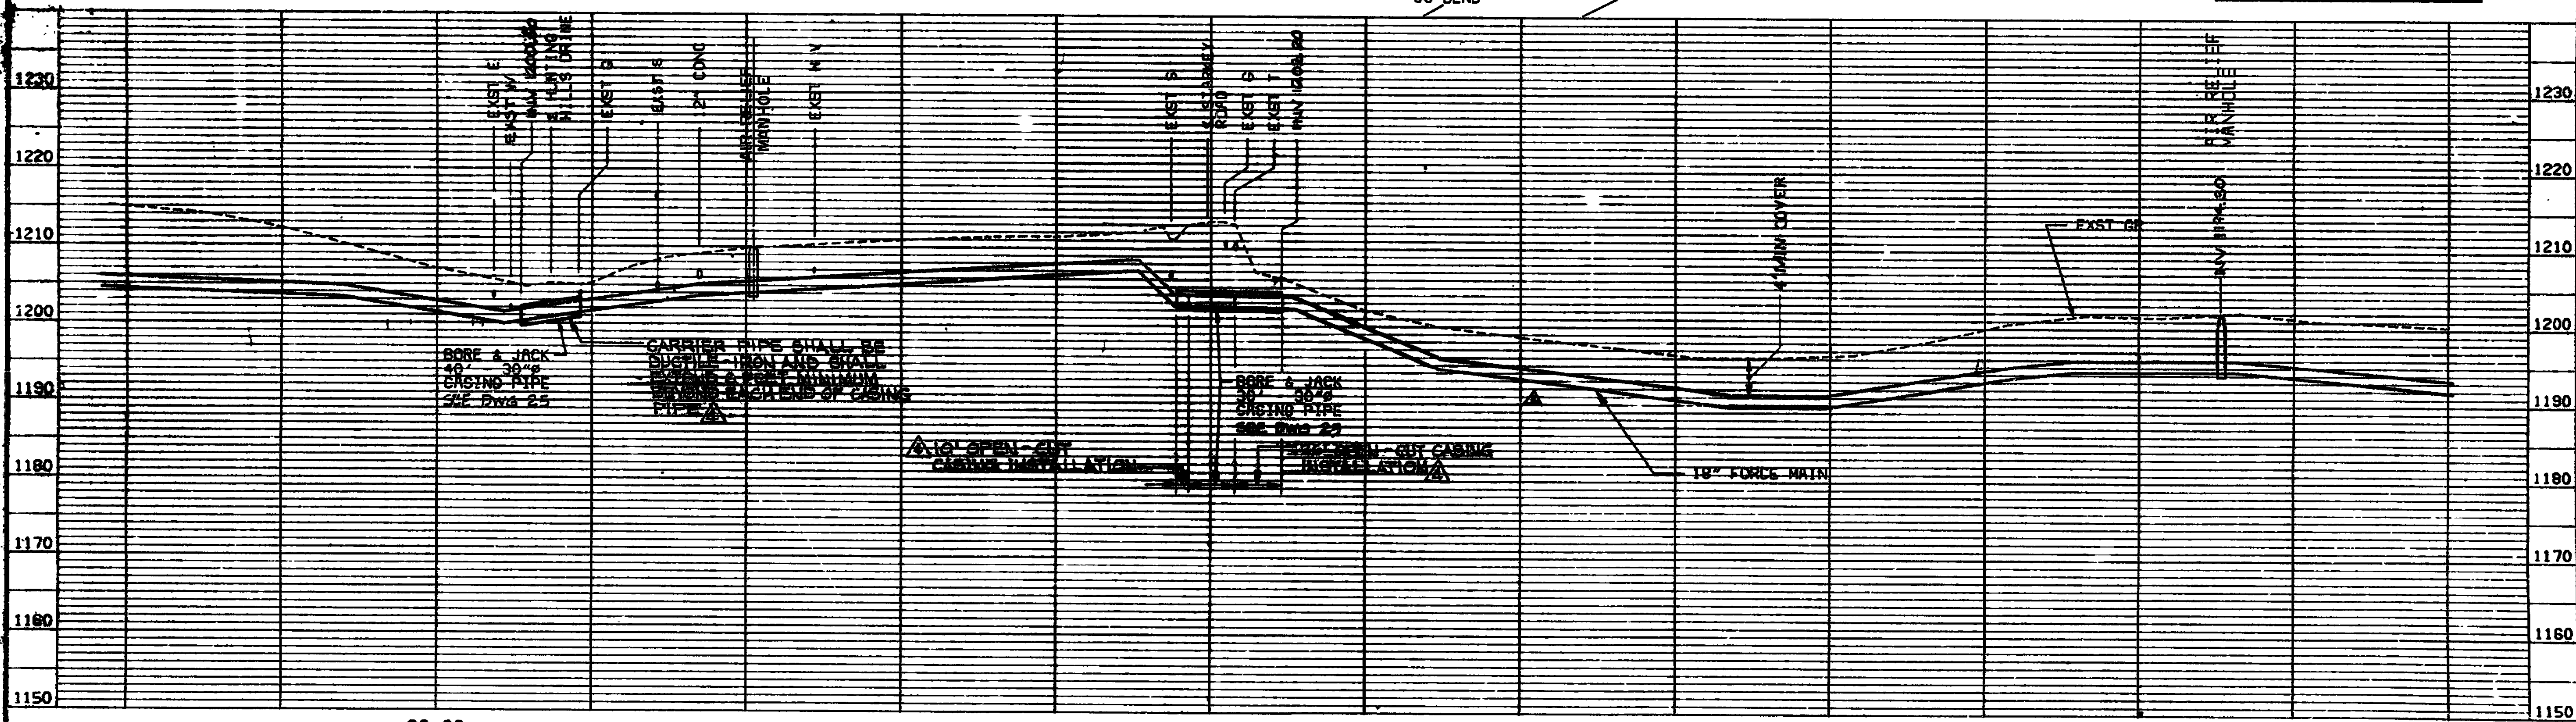

FORCE MAIN - PLAN AND PROFILE
STARKEY ROAD
STA 78+00 TO STA 93+00

SCALE: HORIZ. 1" = 50'
VERT. 1" = 10'

AS BUILT 8/30/89 84-I-S

