
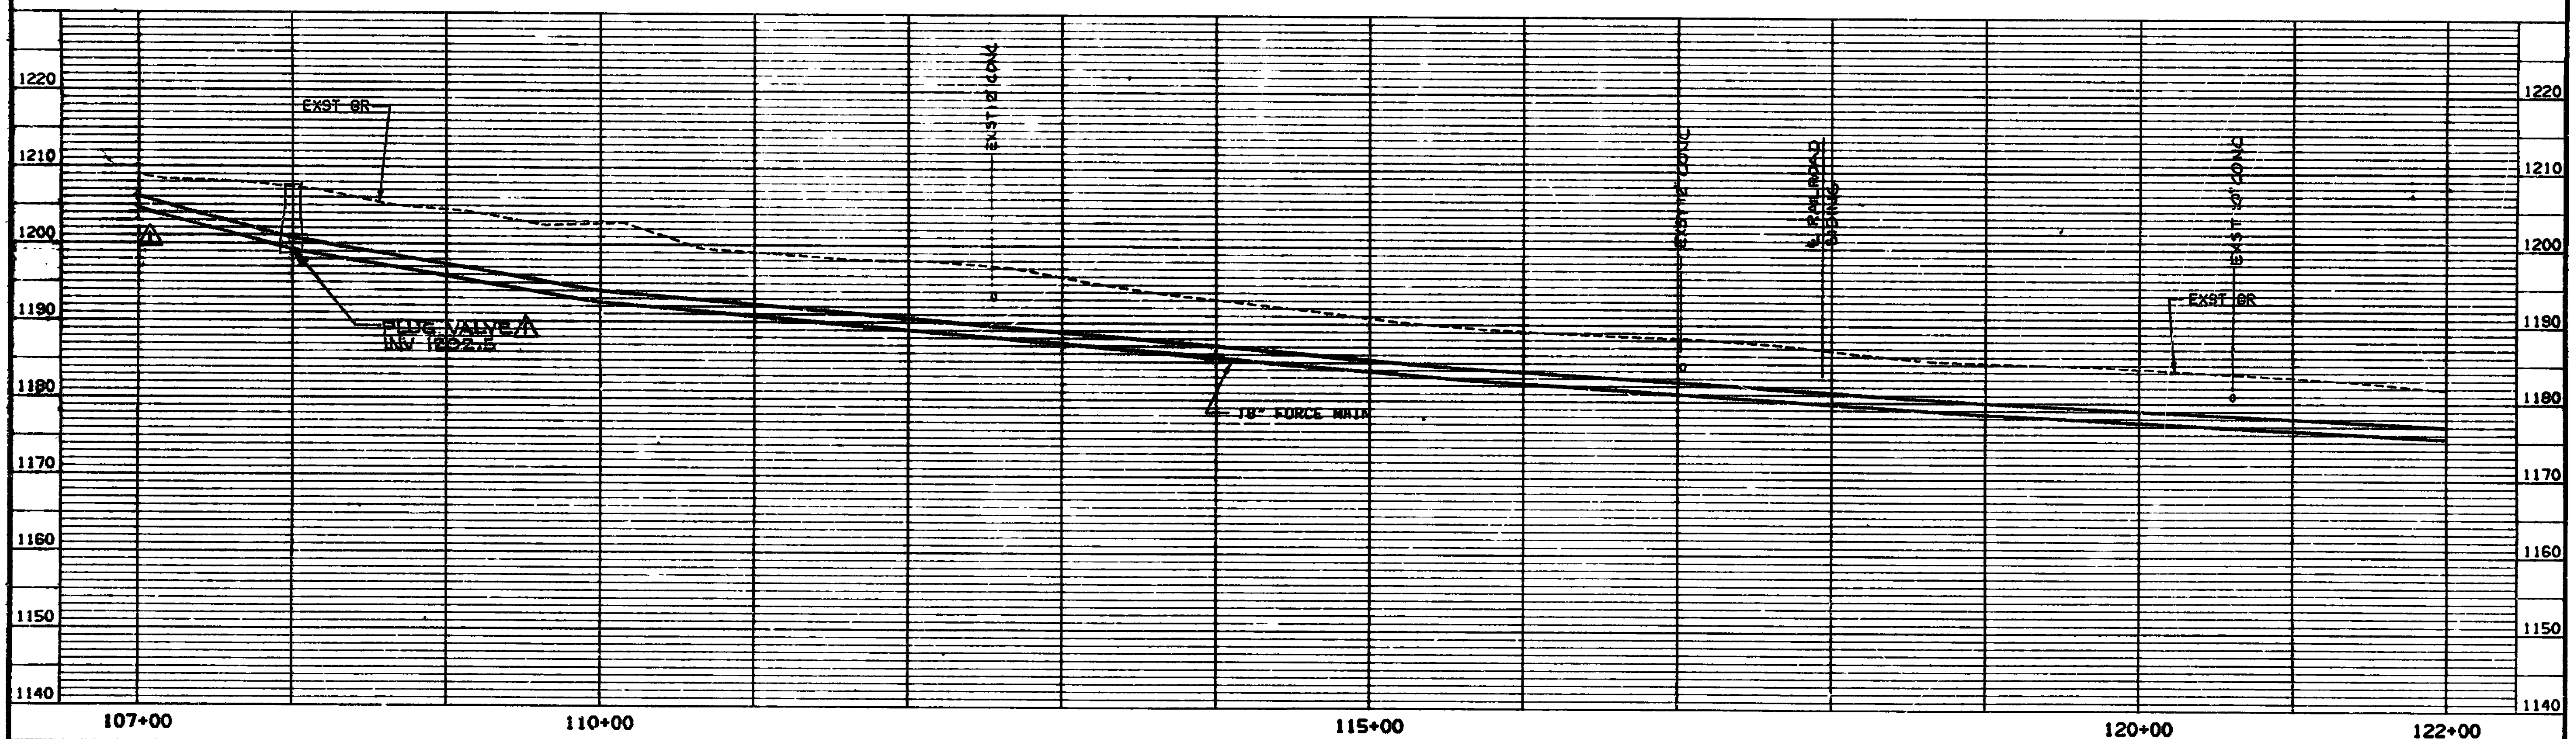


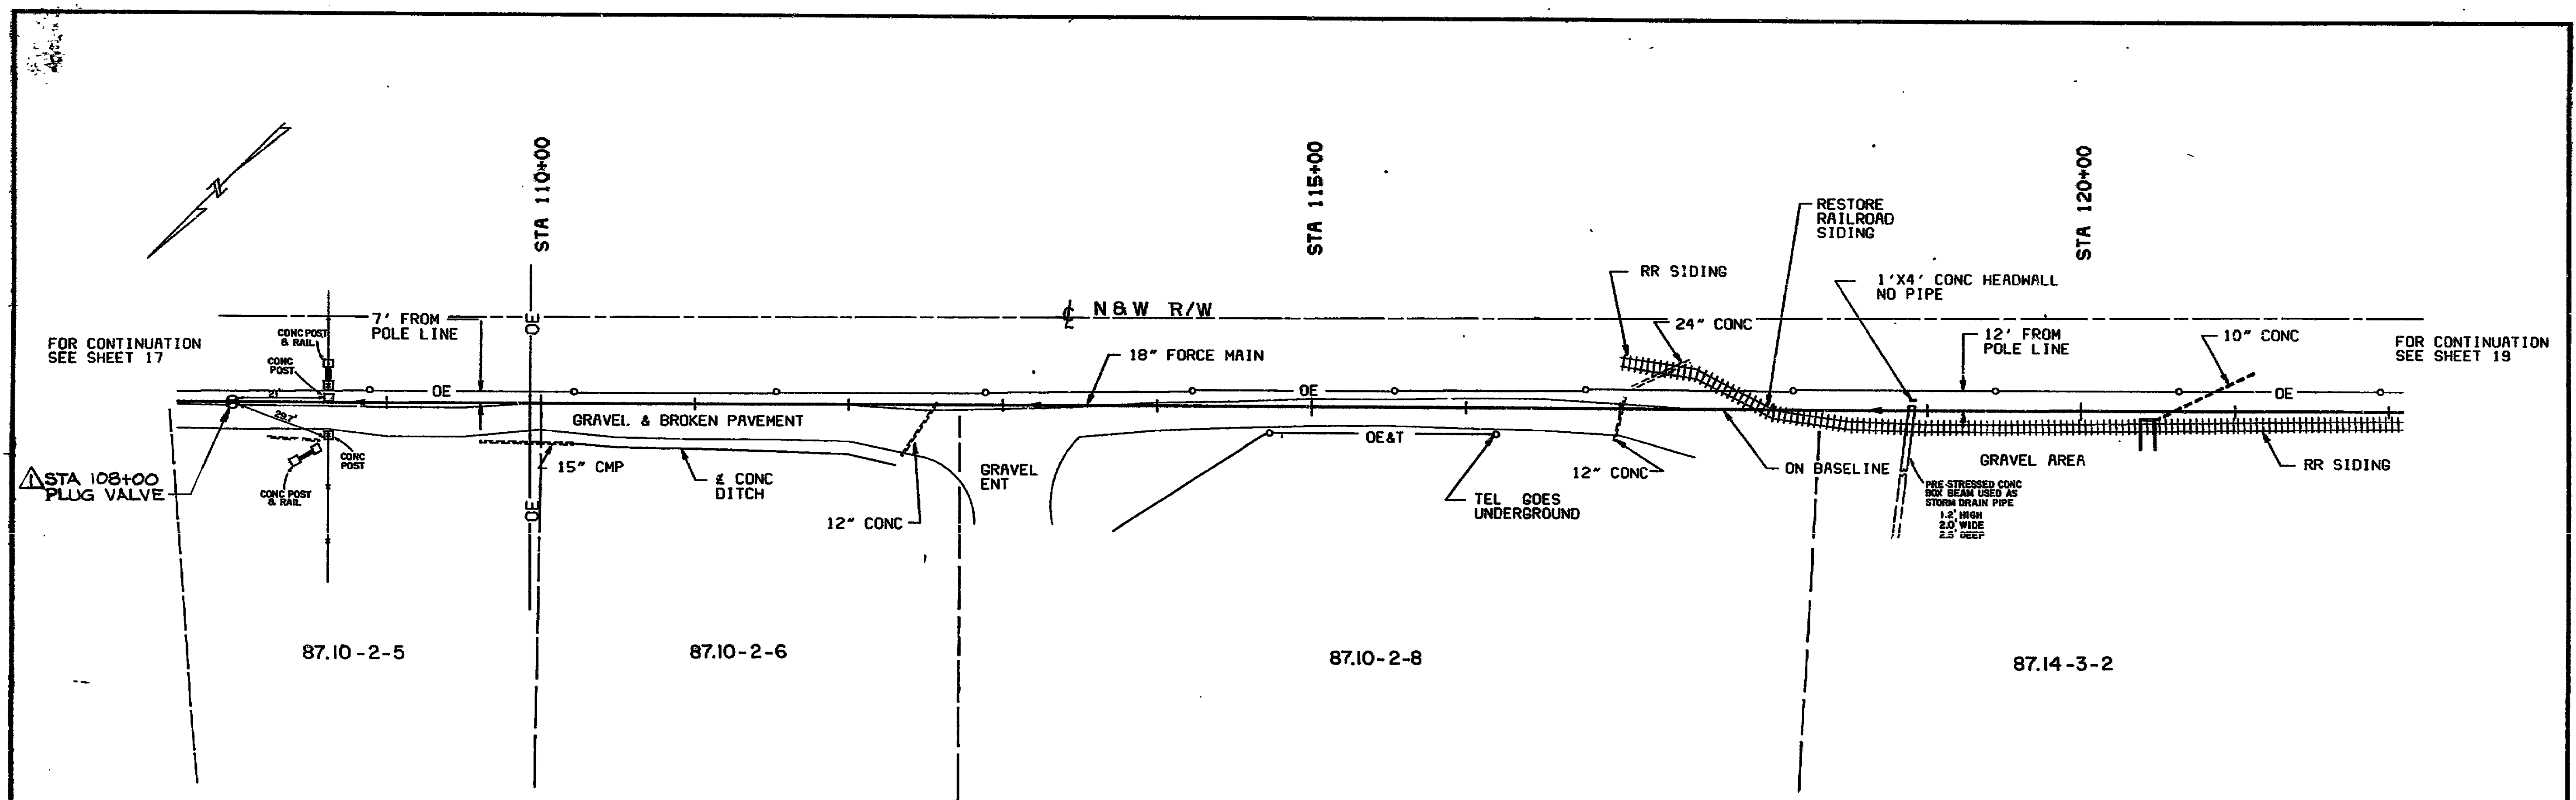

DESIGNED				DATE				BY				REVISIONS				DATE				BY				REVISIONS			
DRAWN				DATE				BY				REVISIONS				DATE				BY				REVISIONS			
CHECKED				DATE				BY				REVISIONS				DATE				BY				REVISIONS			
APPROVED				DATE				BY				REVISIONS				DATE				BY				REVISIONS			

STARKEY SEWAGE PUMP STATION, FORCE MAIN AND GRAVITY SEWER
COUNTY OF ROANOKE, VIRGINIA
11 JANUARY 1985

FORCE MAIN PLAN AND PROFILE
ROUTE 633
STA 107+00 TO STA 122+00

AS BUILT 8/30/89 84-115

