

DEVELOPMENT PLANS  
FOR  
**"STARKEY WATER SYSTEM"**

SITUATED IN  
CAVE SPRING MAGISTERIAL DISTRICT  
ROANOKE COUNTY, VIRGINIA


DATE: 1 NOVEMBER 1990

REVISED: 16 DECEMBER 1993

"AS-BUILT" 20 NOVEMBER 1995

PREPARED FOR

ROANOKE COUNTY UTILITY DEPARTMENT

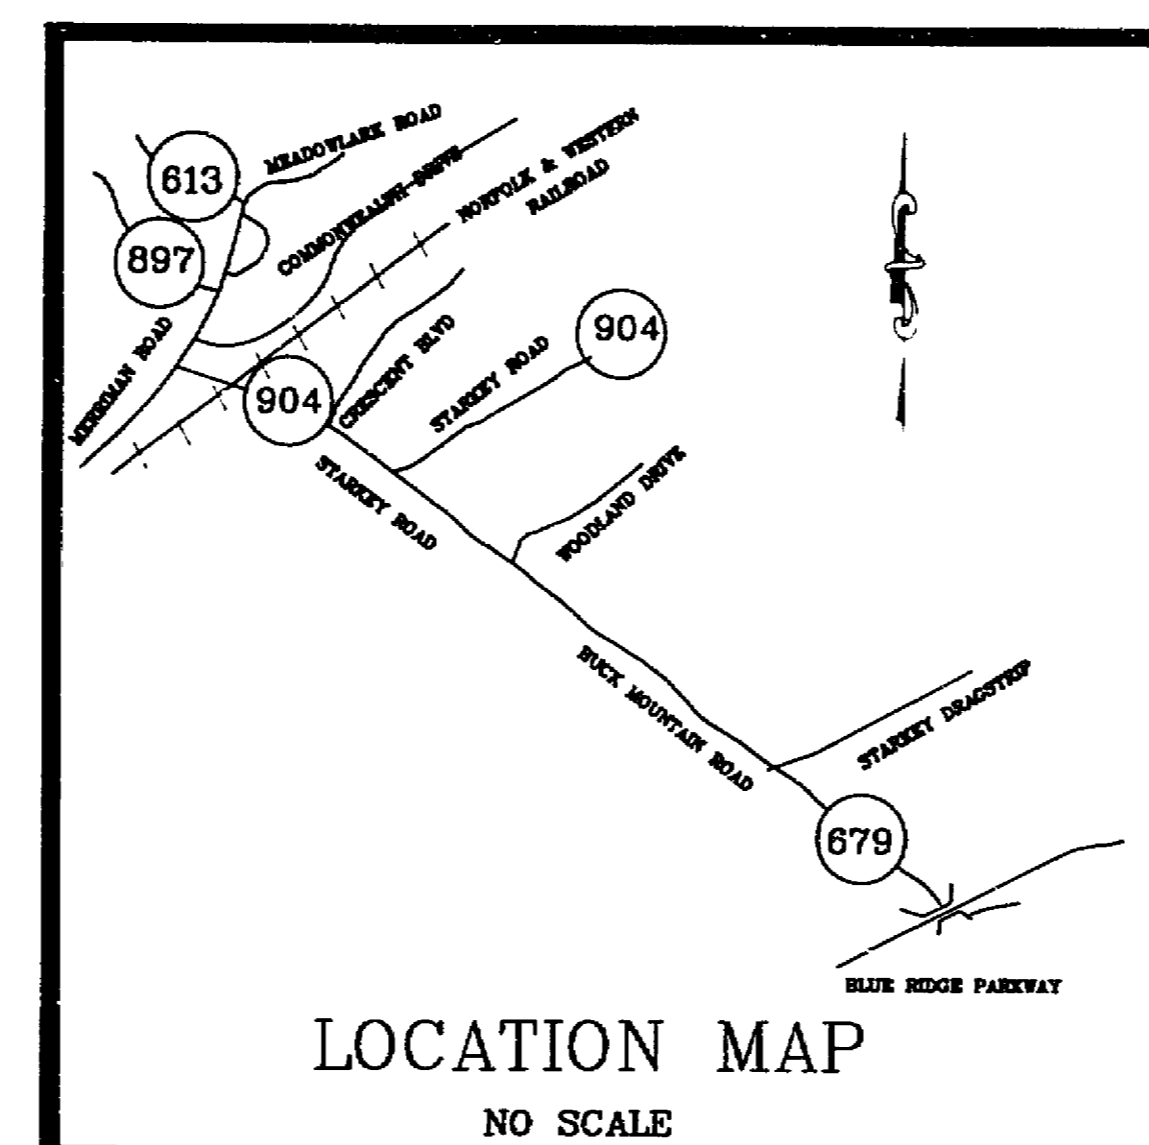

**INDEX OF DRAWINGS**

SHEET No.	DESCRIPTION
-----------	-------------

- |         |                                            |
|---------|--------------------------------------------|
| 1.      | LUMSDEN ASSOCIATES COVER SHEET             |
| 2.      | PLAN & PROFILE SHEET LAYOUT                |
| 3.--10. | PLAN & PROFILES                            |
| 11.     | WATER STORAGE TANK PLAN (NOT USED)         |
| 12.     | ROANOKE COUNTY STANDARD WATER DETAIL SHEET |

LUMSDEN ASSOCIATES, P.C.  
ENGINEERS-SURVEYORS-PLANNERS  
ROANOKE, VIRGINIA

**"AS-BUILT"**

NOTE:

- 1) "AS-BUILT" INFORMATION TAKEN FROM PLANS FURNISHED BY ROANOKE COUNTY UTILITY DEPARTMENT.

15 DEC 1993 - RE-1993 INDEX OF DRAWINGS  
REVISED.  
2 MARCH 1995 COMBINED CONSTRUCTION PHASES

\*90-255