



NOTE:
EXISTING WATER LINES SHOWN THUS
ALL PIPE IS 8" DUCTILE IRON EXCEPT 2" LINE FROM OLD WELL
TO FIRE PLUG ON NICHOLAS AVE.
FITTINGS AS MARKED.
ALL LOCATIONS ARE APPROXIMATE.

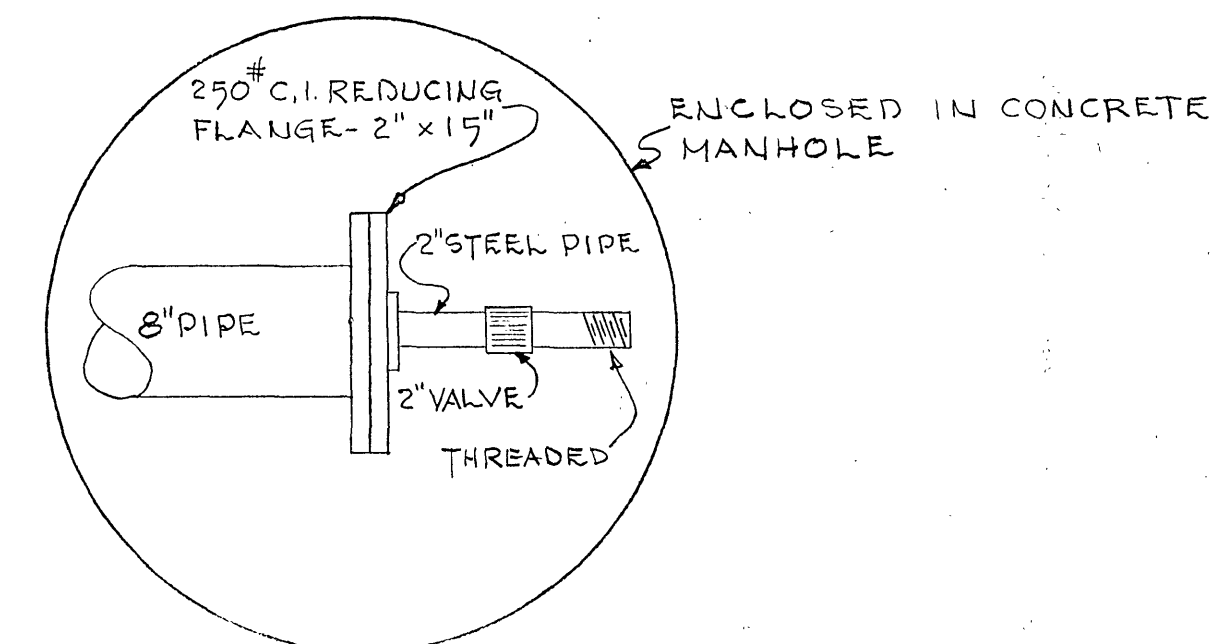


DETAIL
FLUSH VALVE
NO SCALE

MERIDIAN OF VA. DEPT. OF HWYS.

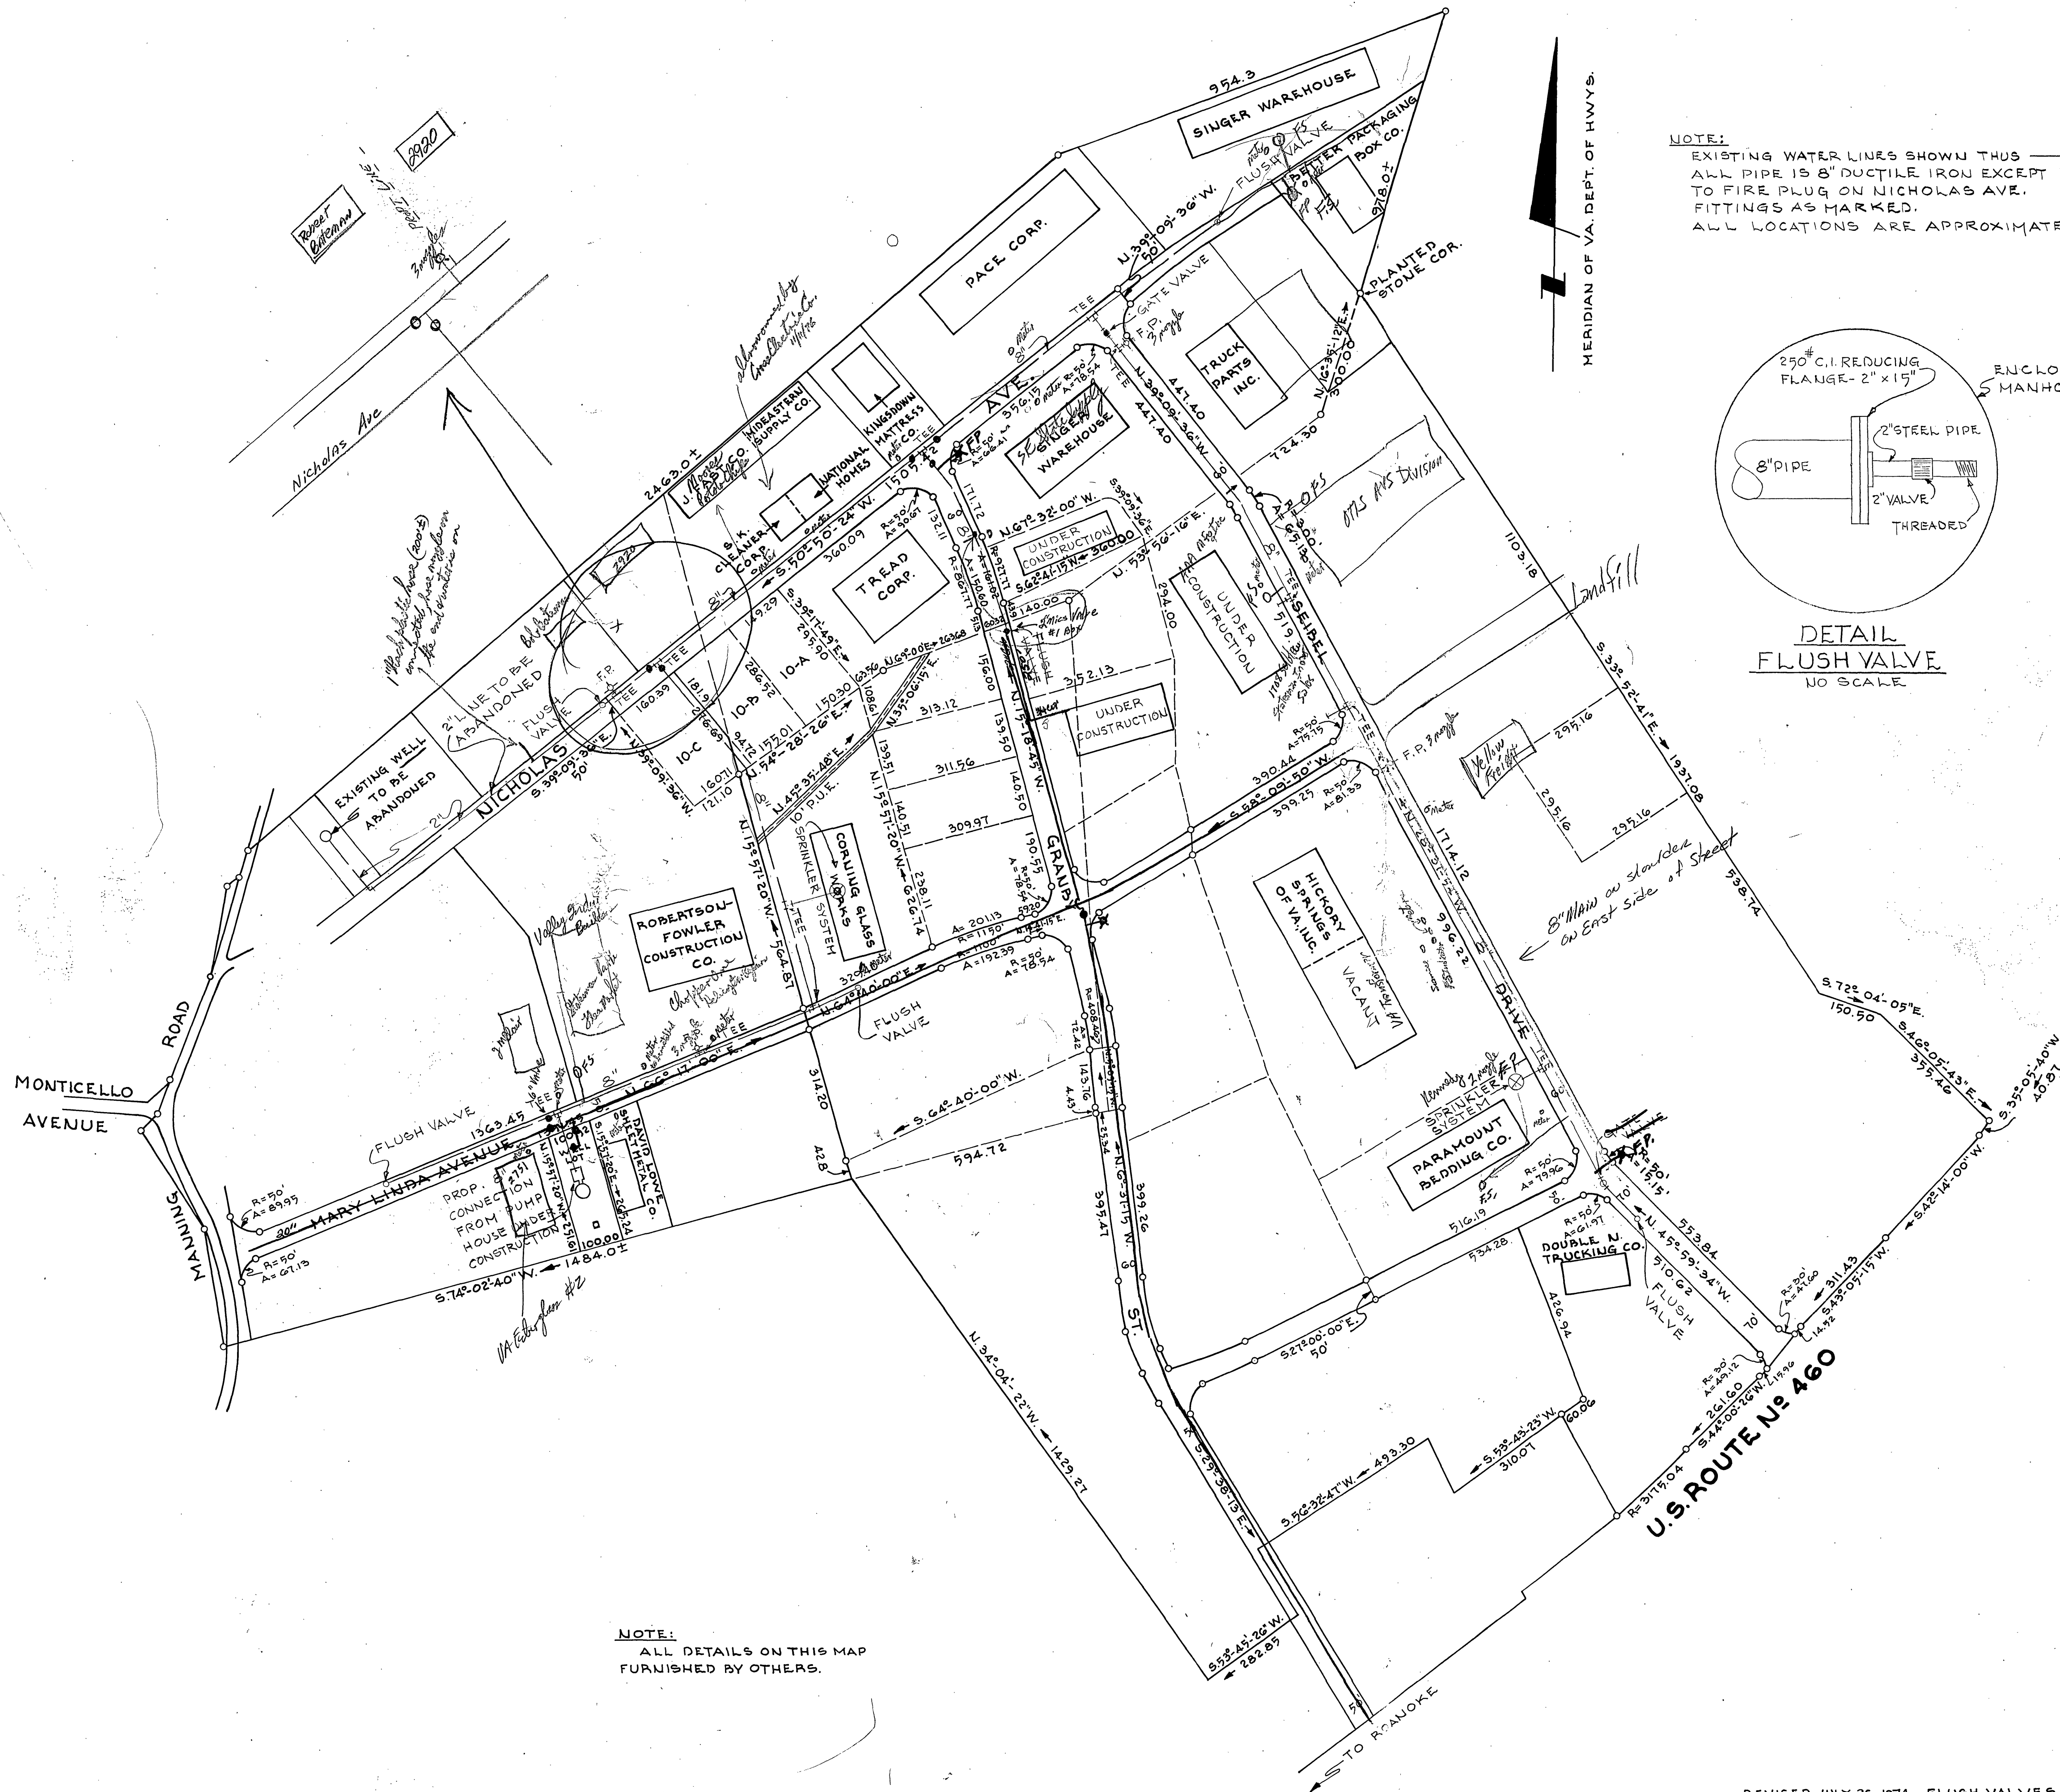

NOTE:
ALL DETAILS ON THIS MAP
FURNISHED BY OTHERS.

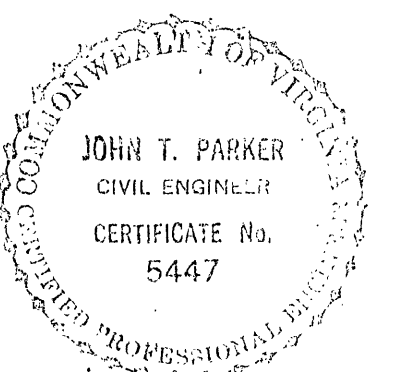

MAP OF
STATESMAN PARK
PROPERTY OF
STATESMAN PARK WATER COMPANY
SITUATE NORTH OF U.S. RTE. NS 460 & EAST OF
CITY OF ROANOKE ROANOKE COUNTY, VA.
DATE: MAY 24, 1974 SCALE: 1"=200'

T. P. PARKER & SON
ENGINEERS & SURVEYORS
SALEM VIRGINIA.

REVISED JULY 26, 1974 - FLUSH VALVES ADDED