


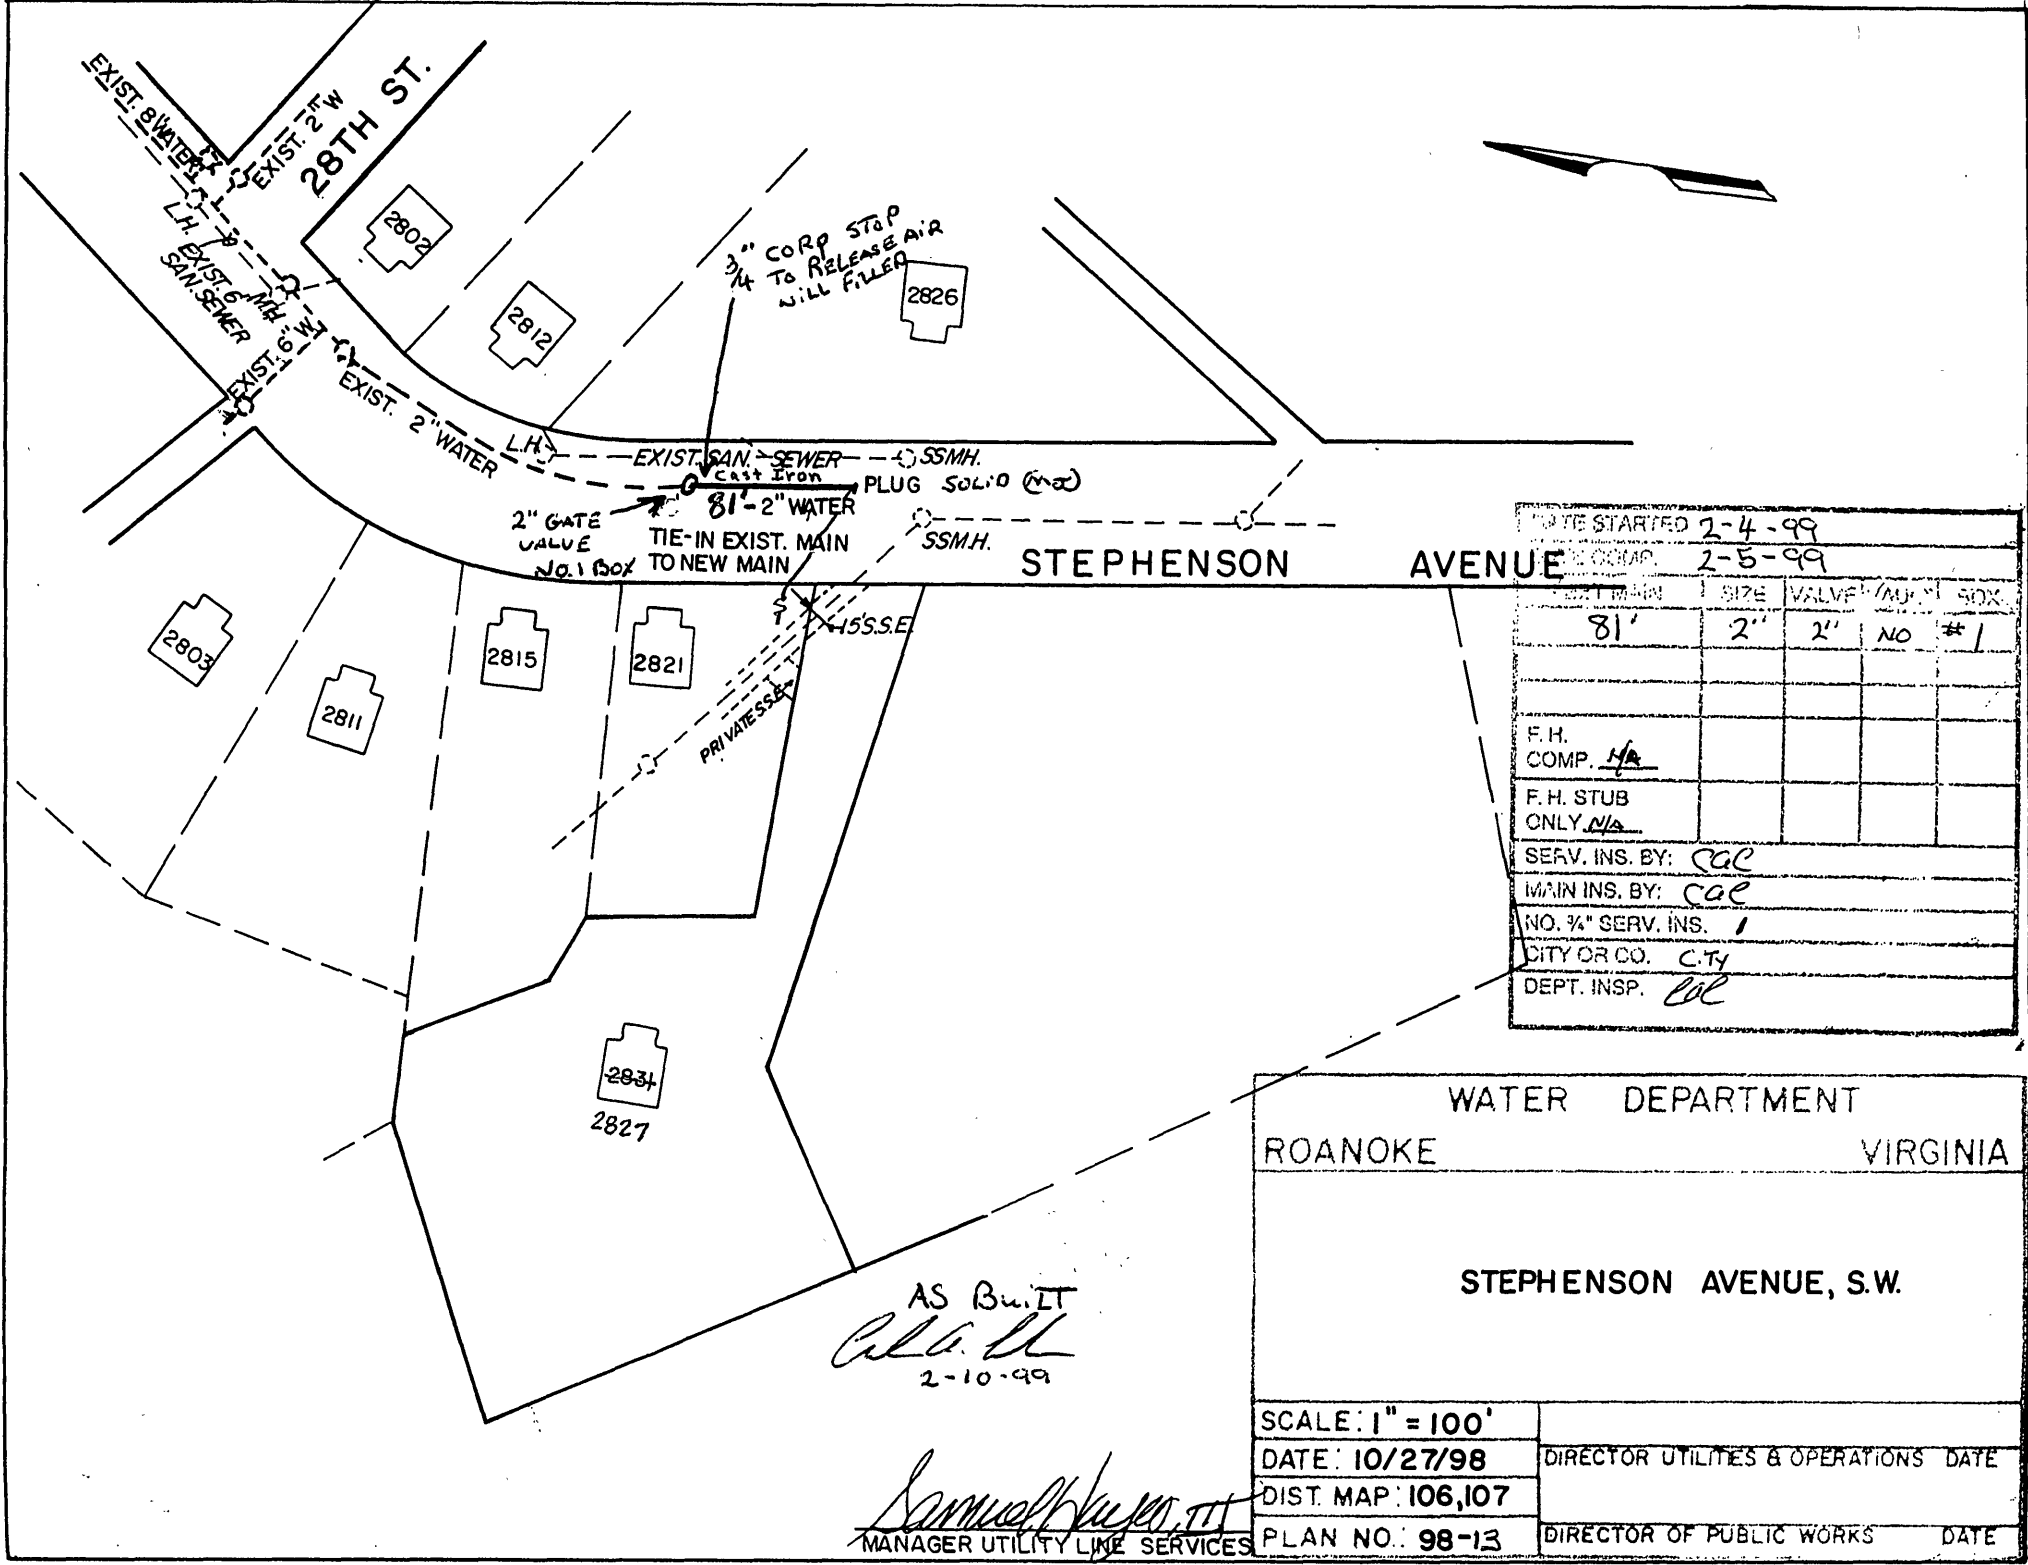

DATE STARTED 2-4-99				
CLOCKED 2-5-99				
EXT. MAIN	SIZE	VALVE	W/VAL	BOX
81'	2"	2"	NO	#1
F.H. COMP. <u>NA</u>				
F.H. STUB ONLY <u>NA</u>				
SERV. INS. BY: <u>CAE</u>				
MAIN INS. BY: <u>CAE</u>				
NO. 1/2" SERV. INS. <u>1</u>				
CITY OR CO. <u>C.TY</u>				
DEPT. INSP. <u>LOE</u>				

AS BUILT
CAE
2-10-99

WATER DEPARTMENT	
ROANOKE	VIRGINIA
STEPHENSON AVENUE, S.W.	
SCALE: 1" = 100'	
DATE: 10/27/98	DIRECTOR UTILITIES & OPERATIONS DATE
DIST. MAP: 106,107	
PLAN NO.: 98-13	DIRECTOR OF PUBLIC WORKS DATE

Samuel W. ...
MANAGER UTILITY LINE SERVICES