


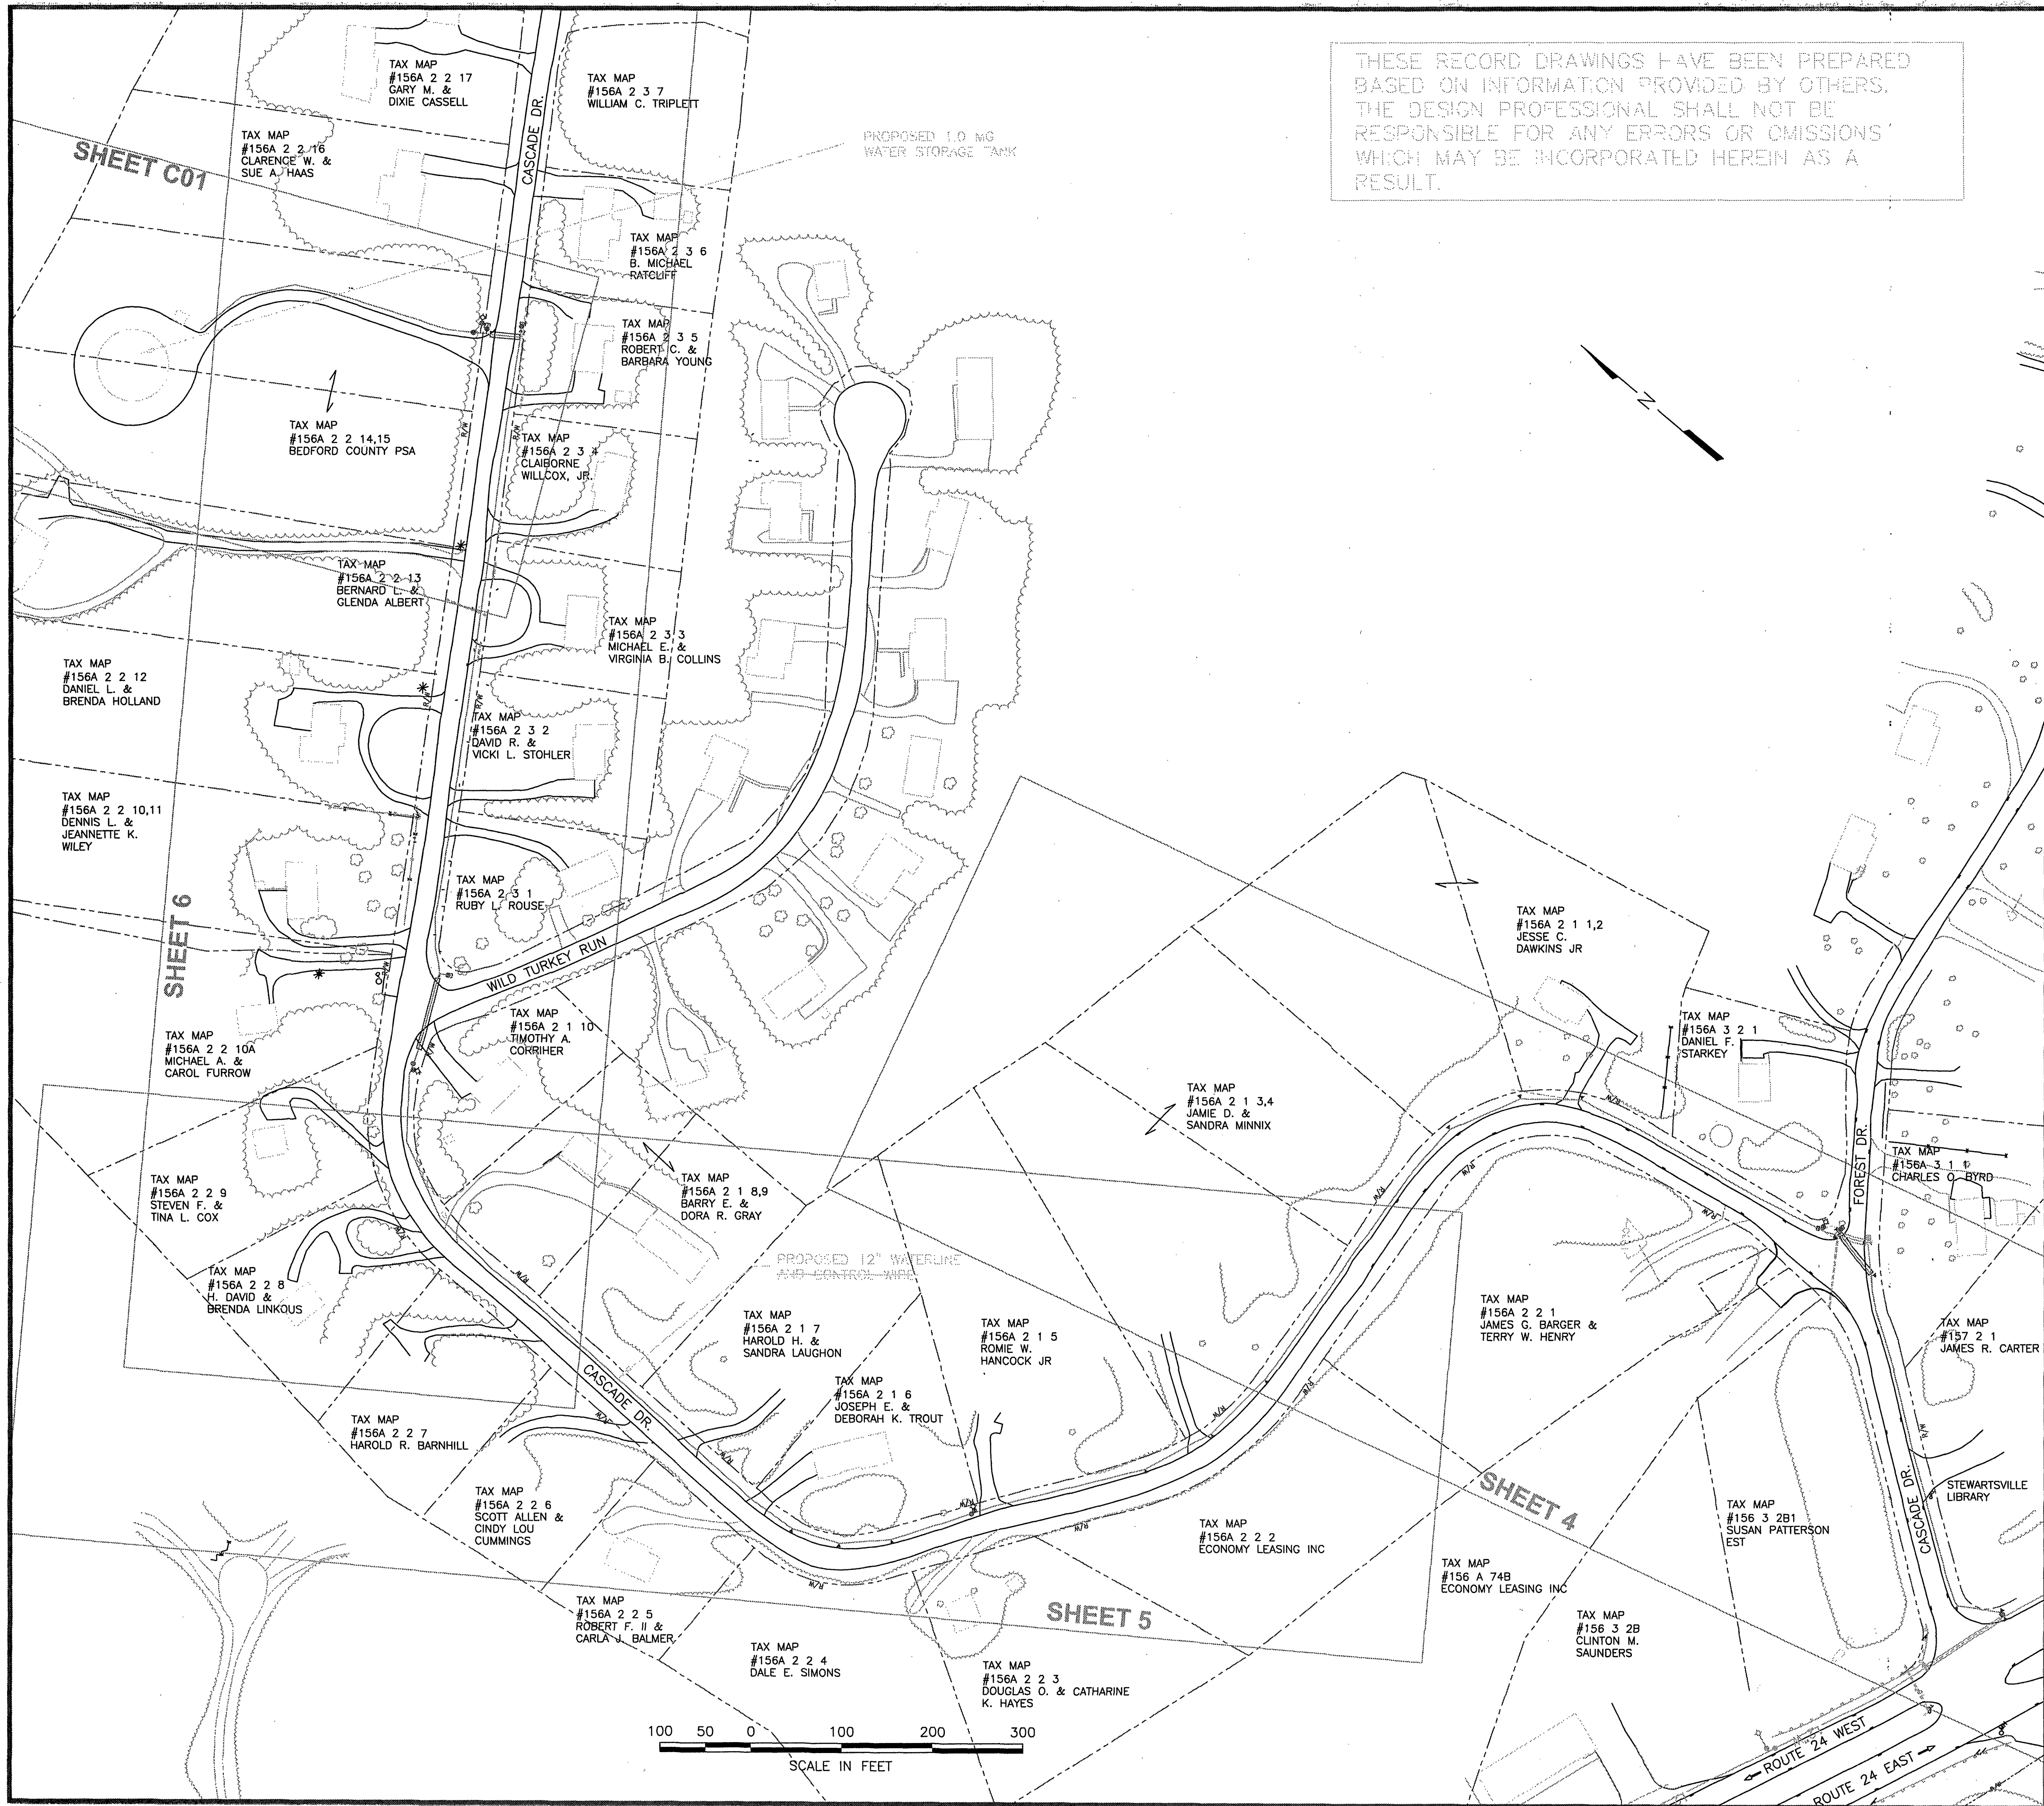

THESE RECORD DRAWINGS HAVE BEEN PREPARED
BASED ON INFORMATION PROVIDED BY OTHERS.
THE DESIGN PROFESSIONAL SHALL NOT BE
RESPONSIBLE FOR ANY ERRORS OR OMISSIONS
WHICH MAY BE INCORPORATED HEREIN AS A
RESULT.

GENERAL LEGEND


6"	PROPOSED WATER LINE	50	PROPOSED CONTOUR LINE
15"	PROPOSED STORM SEWER	2050	EXISTING CONTOUR LINE
---TV---	PROPOSED TELEVISION CABLE	CUT FILL	GRADING LIMITS
---T---	PROPOSED U/G TELEPHONE		CREEK, STREAM, RIVER
---E---	PROPOSED U/G ELECTRIC		EXISTING DITCH
---T---	PROPOSED O/H TELEPHONE		PROPOSED DITCH LINE
---P---	PROPOSED O/H POWER		CONSTRUCTION LIMITS
4"w	EXISTING WATER LINE		EXISTING GUARD RAIL
15g	EXISTING STORM SEWER		PROPOSED GUARD RAIL
2"g	EXISTING GAS LINE		EXISTING FENCE
tv	EXISTING TELEVISION CABLE		PROPOSED FENCE
t	EXISTING U/G TELEPHONE		EQUALITY
e	EXISTING U/G ELECTRIC		BORE HOLE
t	EXISTING O/H TELEPHONE		VDOT MONUMENT
p	EXISTING O/H POWER		VDOT PIN
	VALVE		PROPERTY CORNER
	PROPOSED WATER METER		BENCHMARK
wm	EXISTING WATER METER		HORIZONTAL CONTROL
	FIRE HYDRANT		SHRUB
	REDUCER		TREE
	THRUST BLOCK		WOODS
	BLOW-OFF CHAMBER or AIR RELEASE VALVE (designate with note)		EXISTING GRAVEL ROAD
	POWER POLE		PROPOSED GRAVEL ROAD
	TELEPHONE OR TELEGRAPH POLE		EXISTING PAVEMENT
	GUY WIRE		PROPOSED PAVEMENT
	SIGN		DIRECTION OF TRAFFIC
	LIGHT POLE		PROPOSED WATER LINE NOTE
	MANHOLE		PROP. STORM SEWER STRUCTURE
R/W	RIGHT-OF-WAY LINE		PROPOSED CURVE DESIGNATOR
	PROPERTY LINE		PLAN SHEET NUMBER
	CENTERLINE		

SECTION TITLE A
SCALE 23 24
SECTION OR DETAIL DESIGNATION
SECTION SHOWN AT SHEET ...
SECTION TAKEN FROM SHEET ...

ELEVATION TITLE B
SCALE 23 24
SECTION INDICATORS

DETAIL TITLE 1
SCALE 23 24

1
21 22
DETAIL INDICATOR

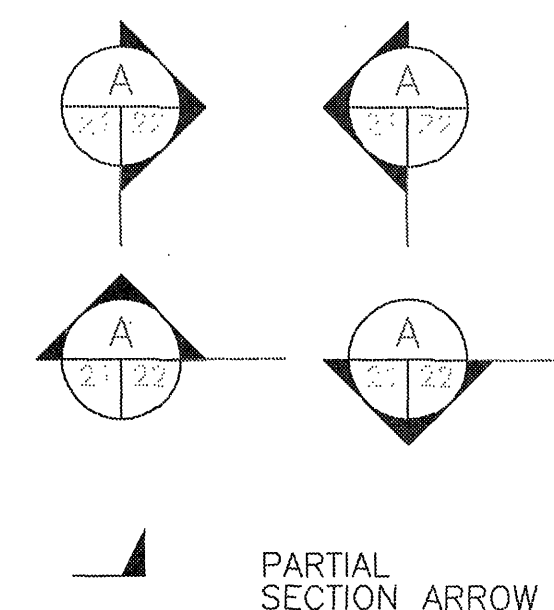

EROSION & SEDIMENT CONTROL LEGEND

SYMBOL	DESCRIPTION	VESCH STANDARD
CE	CONSTRUCTION ENTRANCE	3.02
SF	SILT FENCE	3.05
IP	INLET PROTECTION	3.07
CIP	CULVERT INLET PROTECTION	3.08
OP	OUTLET PROTECTION	3.18
SR	SURFACE ROUGHENING	3.29
TO	TOPSOILING	3.30
TS	TEMPORARY SEEDING	3.31
PS	PERMANENT SEEDING	3.32
EC-2	SOIL STABILIZATION-TRMT 1	3.36
EC-3	SOIL STABILIZATION-TRMT 2	3.36

ANDERSON & ASSOCIATES, INC.
Professional Design Services
www.andassoc.com
Virginia - North Carolina - Tennessee
100 Ardmore St.
Blacksburg, Va. 24060
540-552-5592

DATE : 31 AUG 00	REVISIONS:	RECORD:
DESIGNED: RBE,PJM		29 AUG 01
DRAWN : RBE		
CHECKED : TWD		

STEWARTVILLE
PHASE 2 WATER SYSTEM
BEDFORD COUNTY, VIRGINIA

SHEET LAYOUT

DOCUMENT NO.	16265.5 - 027
SHEET	3
OF	10