
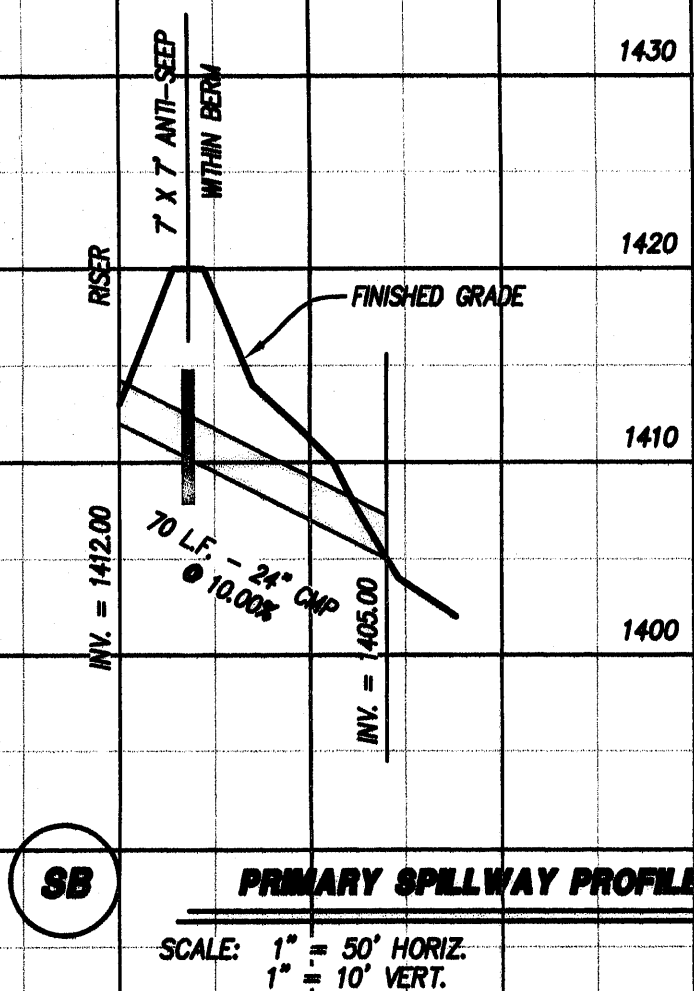
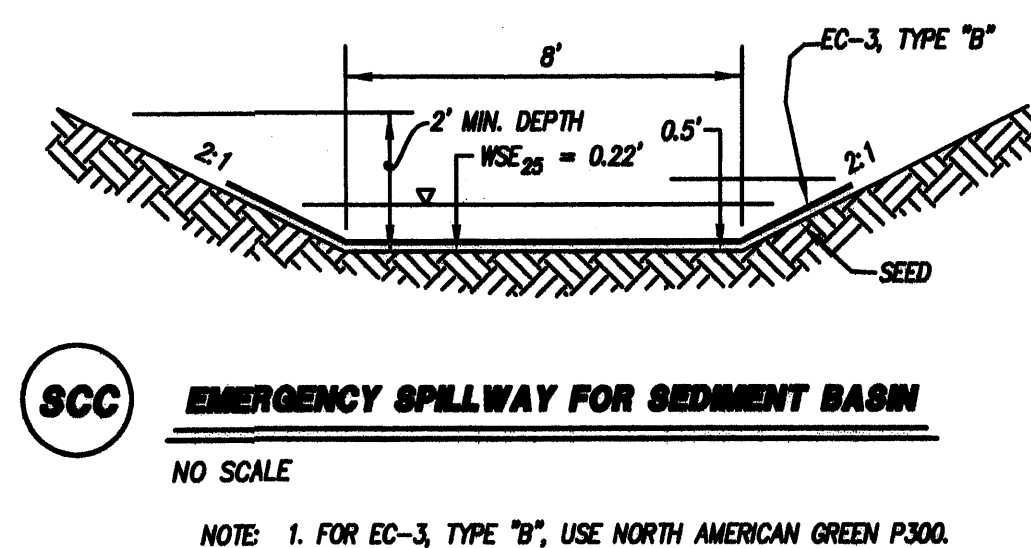
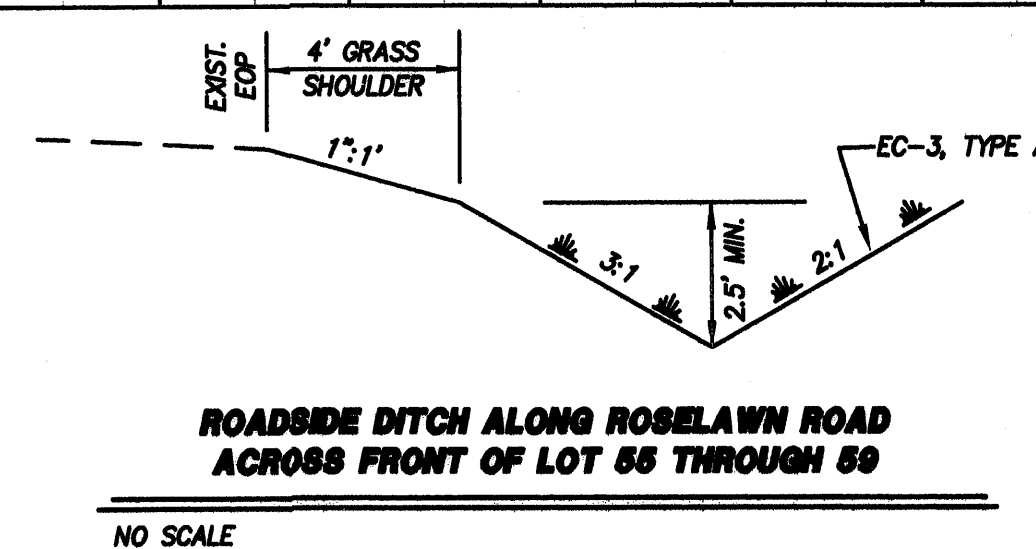
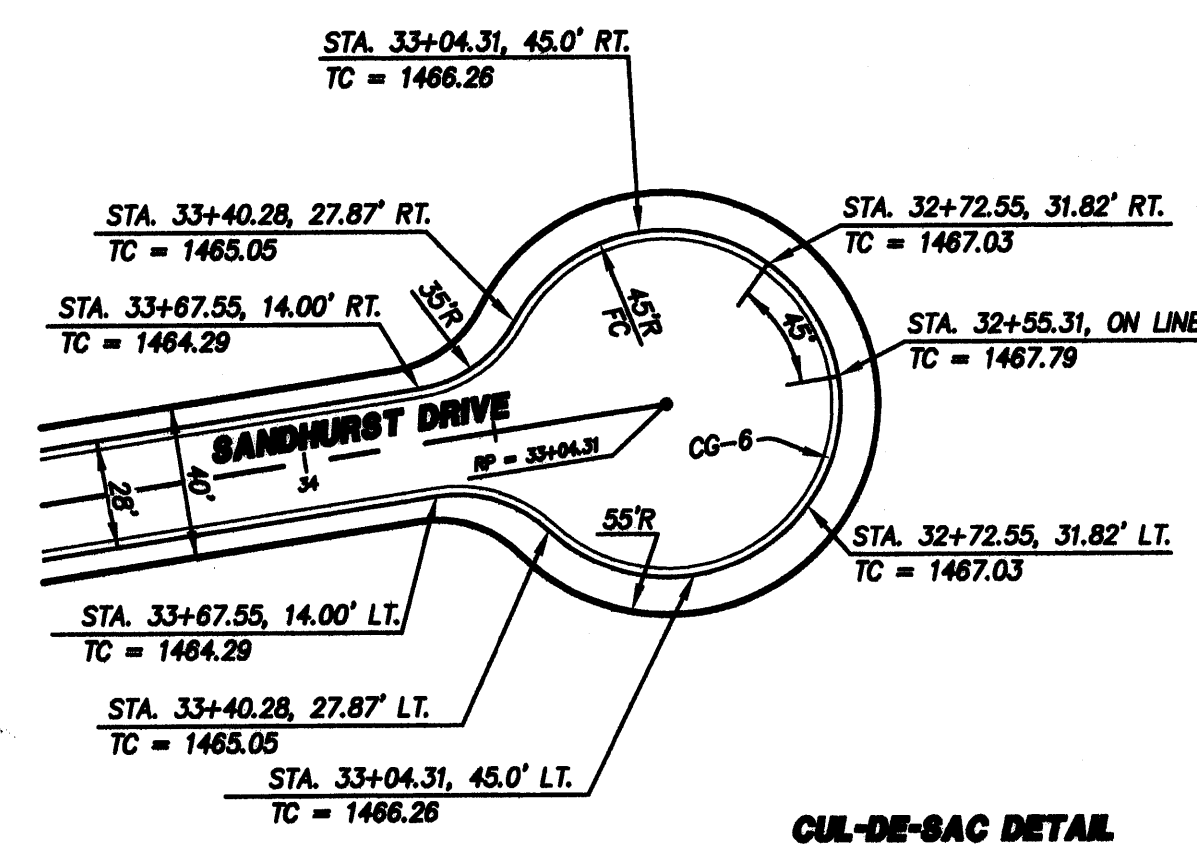


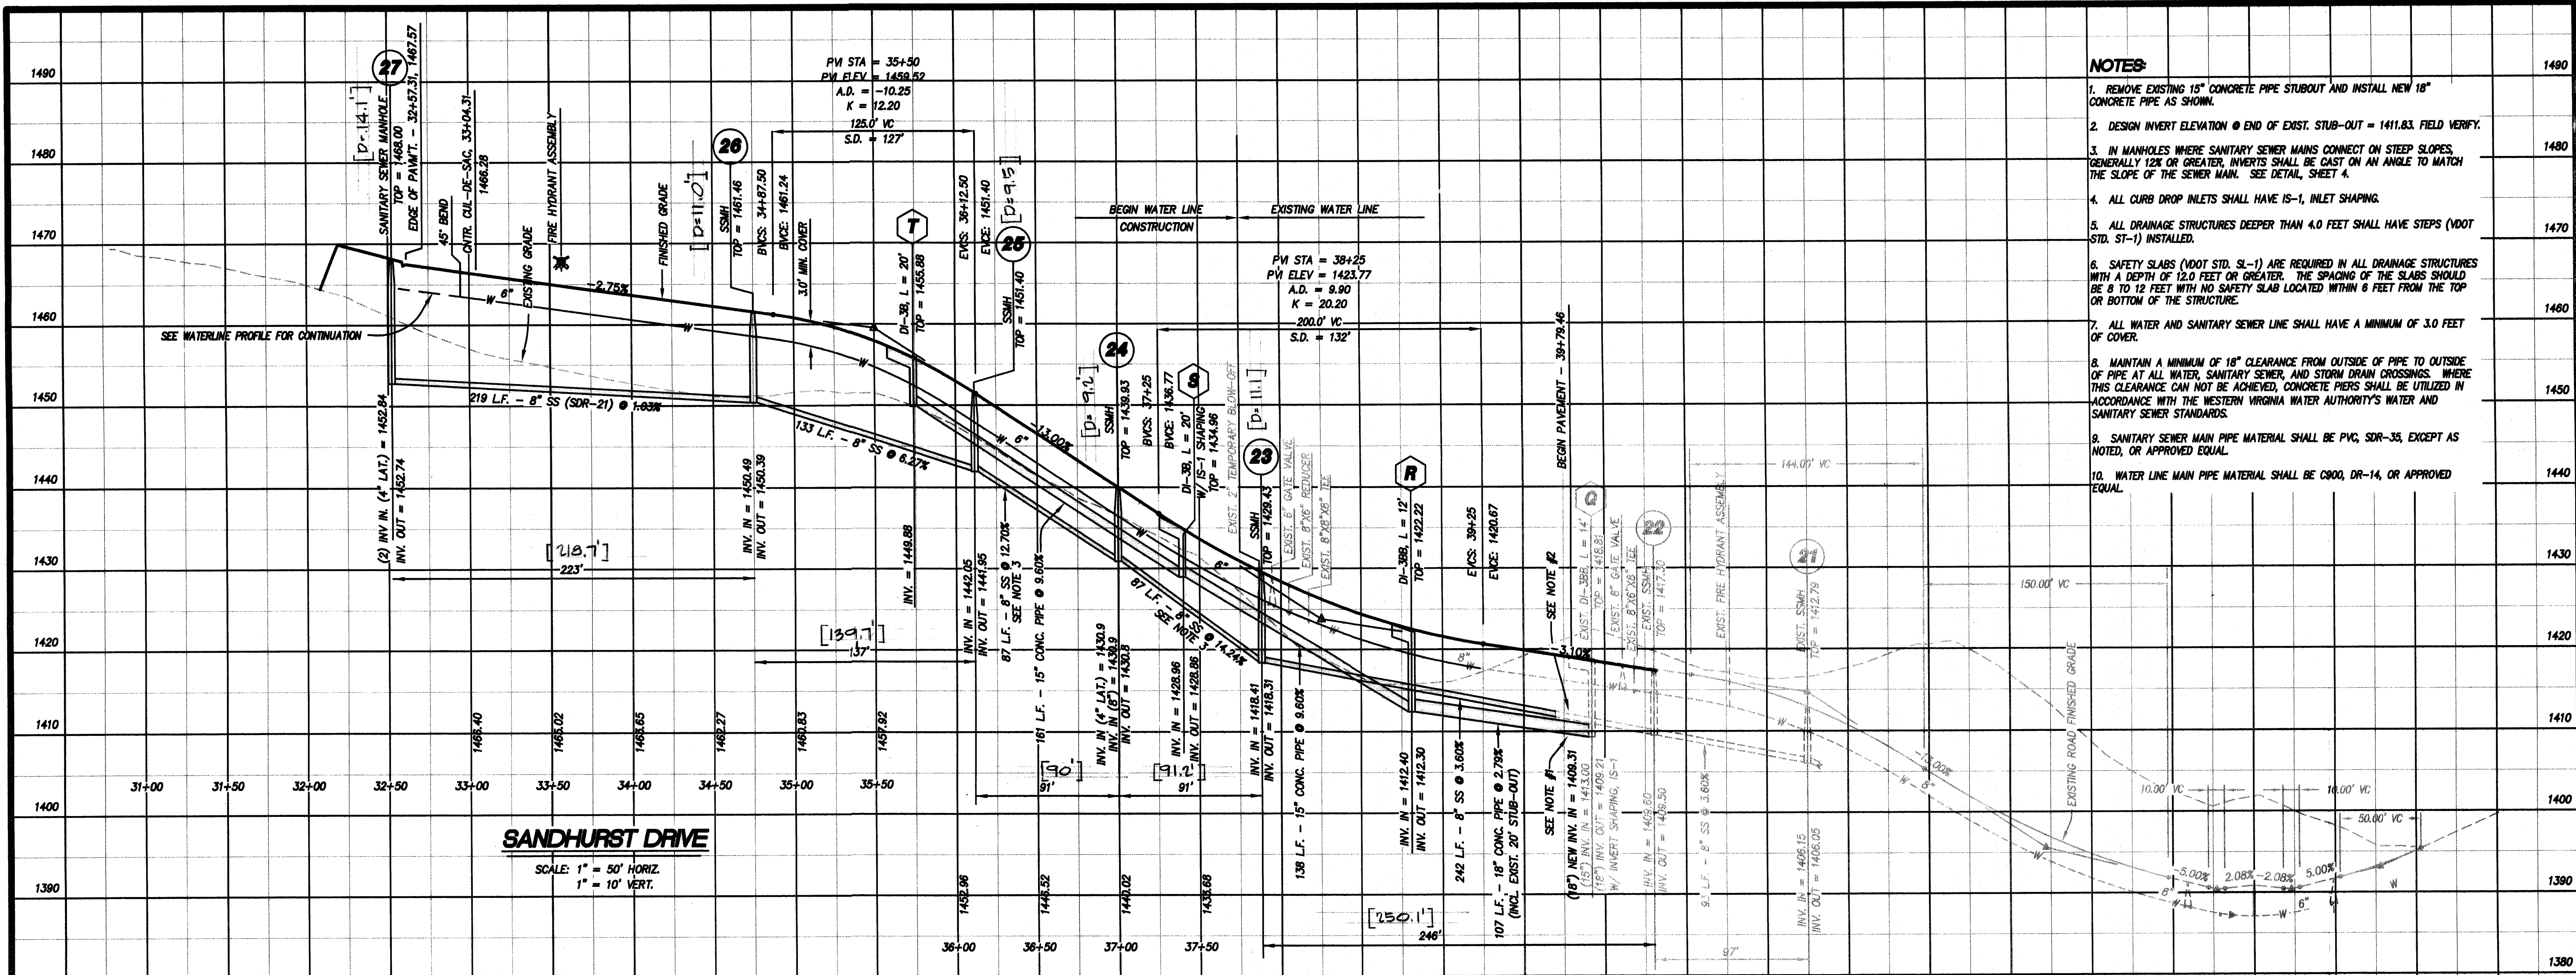

NO.	DATE	DESCRIPTION
1	11/1/05	REVISED SEDIMENT BASIN PRIMARY SPILLWAY WATER & SLOPE CALC.
2	5/1/14	AS-BUILT
3		
4		
5		

DATE: August 23, 2005

SCALE: 1" = 50' (H) 1" = 10' (V)

COMMISSION NO. 01-409

SHEET 7 OF 12