


PLAN	SURVEYED	DATE
NO.	BY	
NOTE BOOK	ALIGNED	CHECKED
	RT. OF WAY	CHECKED

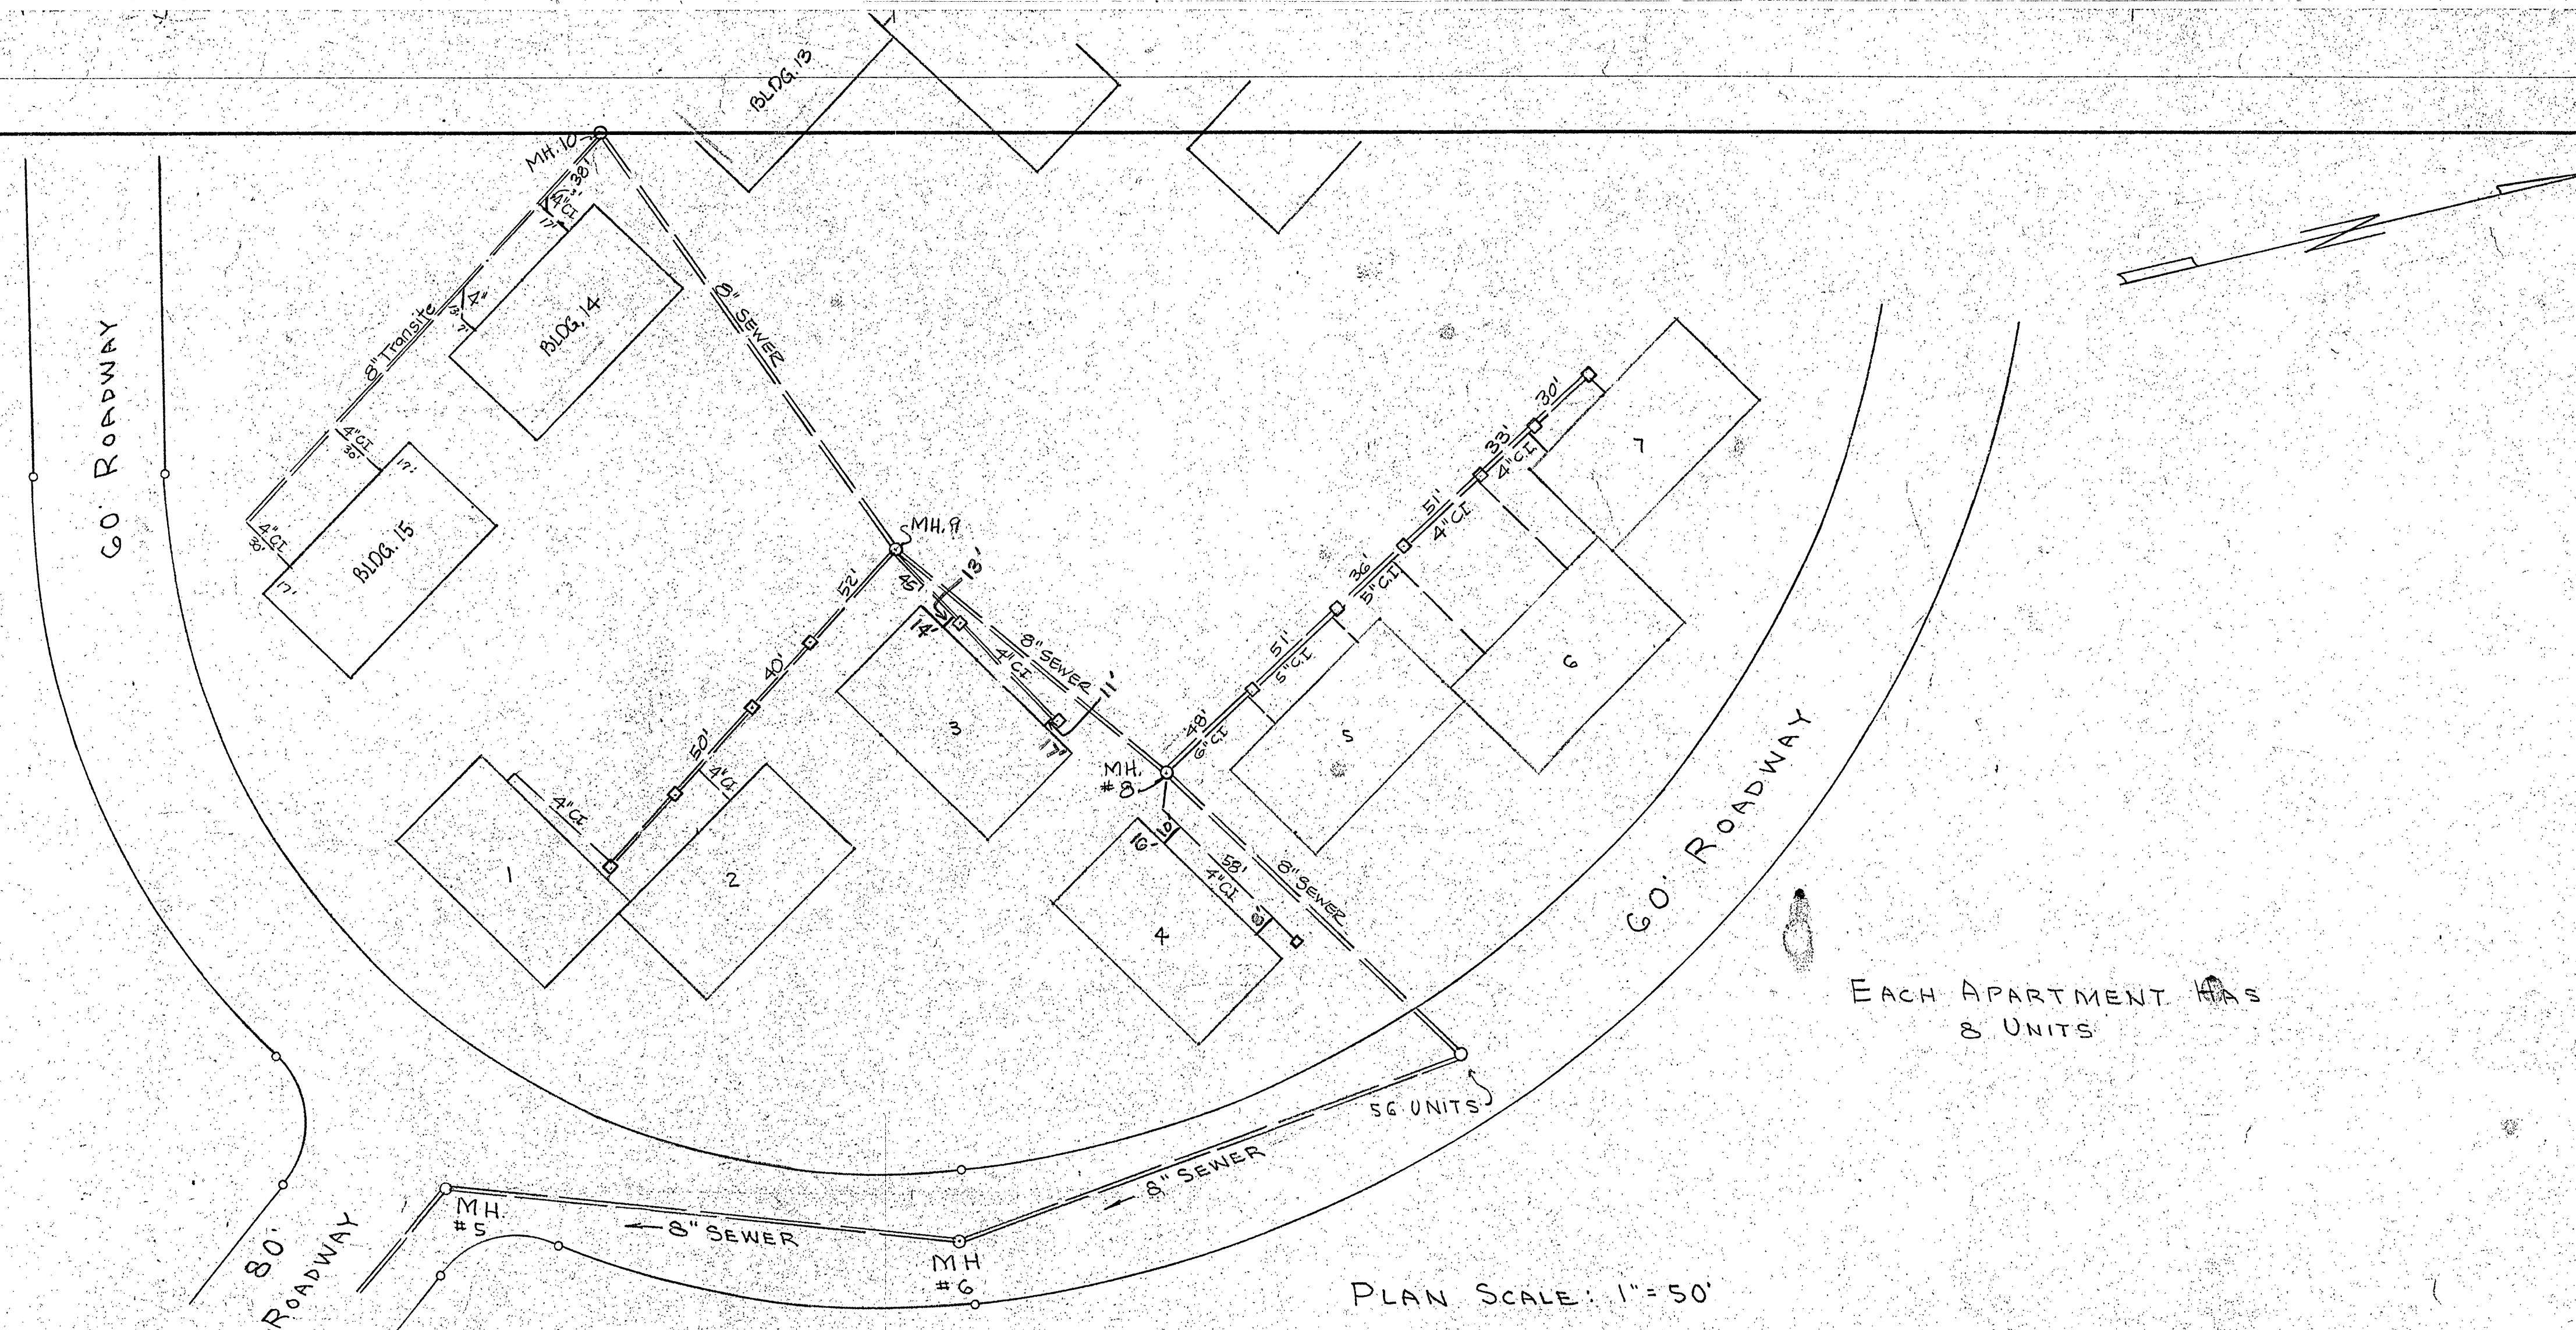

PLAN SCALE: 1" = 50'

EACH APARTMENT HAS 8 UNITS

AS BUILT PLAN ONLY

PLAN AND PROFILE
OF PROPOSED SANITARY SEWER FOR
STRATFORD PARK APARTMENT SITE
ALONG U.S. RT. 11- LEE HIGHWAY & THRU
PROPERTY OF STRATFORD PARK CORP.
ROANOKE CO., VIRGINIA
SCALE: AS NOTED JUNE 3, 1972

BY: T. P. PARKER & SON
ENGRS & SURVEYORS

PROFILE	SURVEYED	DATE
NO.	BY	
NOTE BOOK	GRADES	CHECKED
	STRUCTURE	NOTATIONS

PROFILE OF SANITARY SEWER IN PROPOSED APARTMENT SITE

SCALE: 1" = 50' HORIZONTAL
1" = 10' VERTICAL

PROFILE NOT AS BUILT

