


AS-BUILT SEWER LATERAL TABLE

MANHOLE	ORIGINAL	LOC. STATION	DEPTH	VERTICAL CURVATURE	NO. OF STATIONS	NO. OF STATIONS
27	10-38.15	1+00	TOP ELEV = 1143.82			
28	10-38.15	1+10	TOP ELEV = 1143.84			
29	10-38.15	1+20	TOP ELEV = 1143.84			
30	10-38.15	1+30	TOP ELEV = 1143.84			
218	10-38.15	1+1910	TOP ELEV = 1143.84			
219	10-38.15					

MANAGER ID	NAME	DATE LAST 29	TIME SITUATION	OFFICE SITUATION	MANAGER ID	NAME	DATE LAST 29	TIME SITUATION
MAN0001	MAN0001	1971 09	10:00	10:00	MAN0001	MAN0001	1971 09	10:00
MAN0002	MAN0002	1971 09	10:00	10:00	MAN0002	MAN0002	1971 09	10:00
MAN0003	MAN0003	1971 09	10:00	10:00	MAN0003	MAN0003	1971 09	10:00
MAN0037	MAN0037	1971 09	10:00	10:00	MAN0037	MAN0037	1971 09	10:00

DATE: AUGUST 15, 1992	SCALE: 1" = 50'																																																																																																																																																																																																																																																																																																					
JOB NO. 920406	CIRCU: 3 C.L.																																																																																																																																																																																																																																																																																																					
REVISIONS: <table border="1"> <tr> <td>1</td> <td>ADD 1" R/W</td> <td>08/22/92</td> </tr> <tr> <td>2</td> <td>ADD 1" R/W</td> <td>08/22/92</td> </tr> <tr> <td>3</td> <td>ADD 1" R/W</td> <td>08/22/92</td> </tr> <tr> <td>4</td> <td>ADD 1" R/W</td> <td>08/22/92</td> </tr> <tr> <td>5</td> <td>ADD 1" R/W</td> <td>08/22/92</td> </tr> <tr> <td>6</td> <td>ADD 1" R/W</td> <td>08/22/92</td> </tr> <tr> <td>7</td> <td>ADD 1" R/W</td> <td>08/22/92</td> </tr> <tr> <td>8</td> <td>ADD 1" R/W</td> <td>08/22/92</td> </tr> <tr> <td>9</td> <td>ADD 1" R/W</td> <td>08/22/92</td> </tr> <tr> <td>10</td> <td>ADD 1" R/W</td> <td>08/22/92</td> </tr> <tr> <td>11</td> <td>ADD 1" R/W</td> <td>08/22/92</td> </tr> <tr> <td>12</td> <td>ADD 1" R/W</td> <td>08/22/92</td> </tr> <tr> <td>13</td> <td>ADD 1" R/W</td> <td>08/22/92</td> </tr> <tr> <td>14</td> <td>ADD 1" R/W</td> <td>08/22/92</td> </tr> <tr> <td>15</td> <td>ADD 1" R/W</td> <td>08/22/92</td> </tr> <tr> <td>16</td> <td>ADD 1" R/W</td> <td>08/22/92</td> </tr> <tr> <td>17</td> <td>ADD 1" R/W</td> <td>08/22/92</td> </tr> <tr> <td>18</td> <td>ADD 1" R/W</td> <td>08/22/92</td> </tr> <tr> <td>19</td> <td>ADD 1" R/W</td> <td>08/22/92</td> </tr> <tr> <td>20</td> <td>ADD 1" R/W</td> <td>08/22/92</td> </tr> <tr> <td>21</td> <td>ADD 1" R/W</td> <td>08/22/92</td> 3	ADD 1" R/W	08/22/92																																																																																																																																																																																																																																																																																																				
98																																																																																																																																																																																																																																																																																																						

MULHOLLAND CIRCLE
(CATEGORY I PAVEMENT)

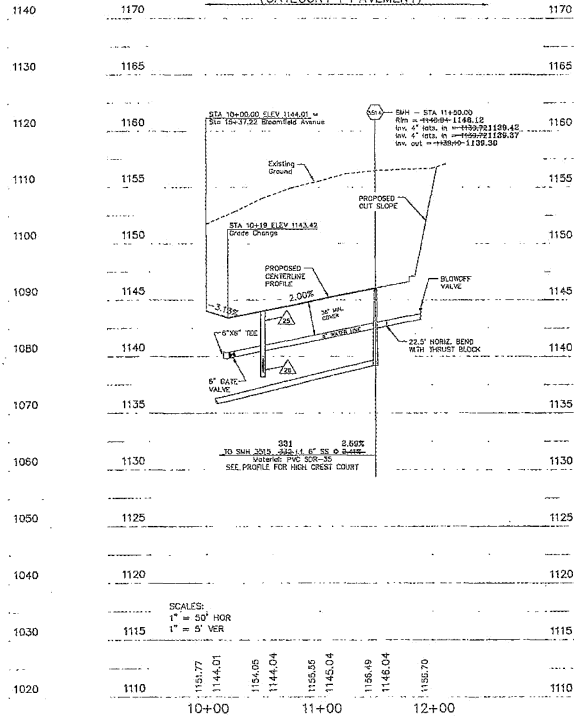

SHEET NO. 13
25
OF