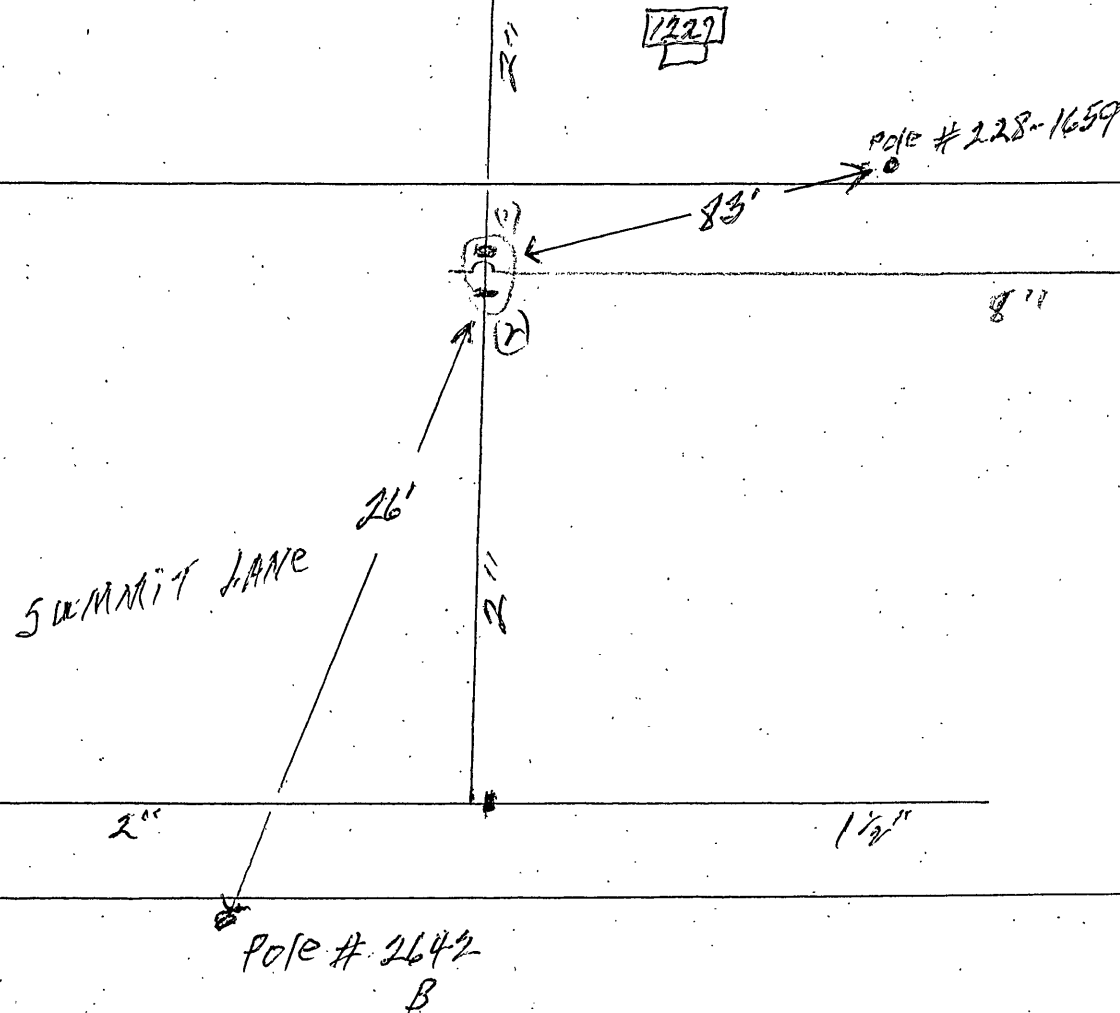


Edgewood
corner

[illegible]

ATTN. MR. HARLOW

CITY OF ROANOKE—WATER DEPT
VALVE DIAGRAM
1227 SUMMIT
LANE N.W.
SEC. MAP 609
DATE 5-1-01 PAGE NO.