



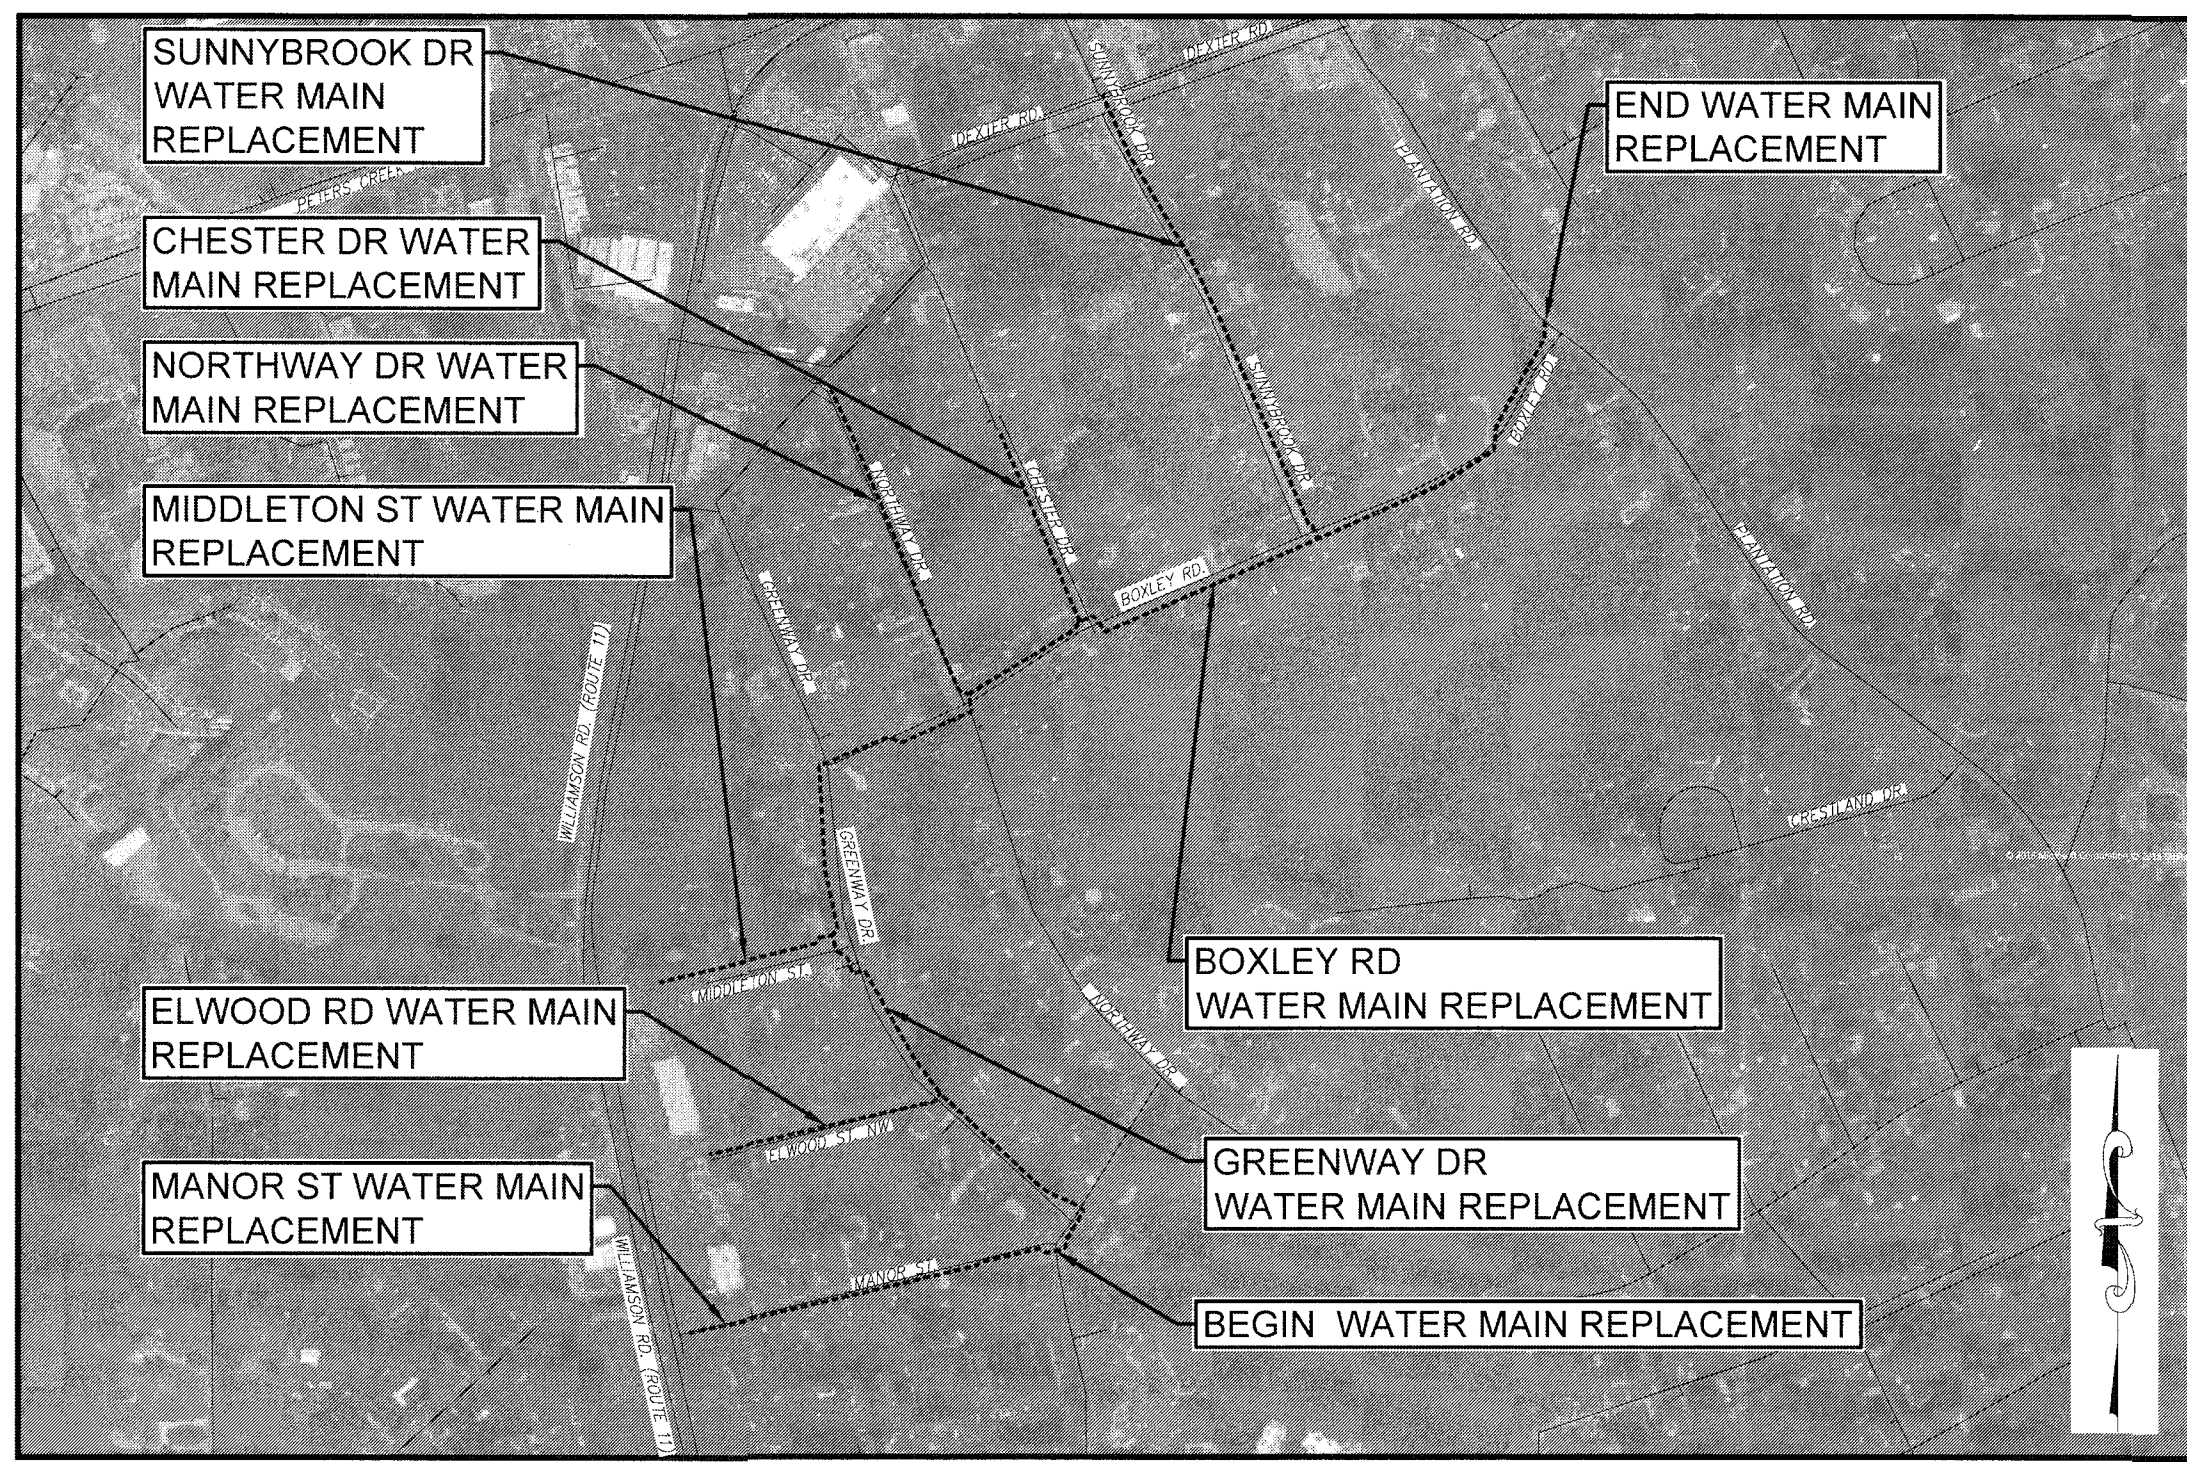

LOCATION MAP
SCALE: 1"=500'

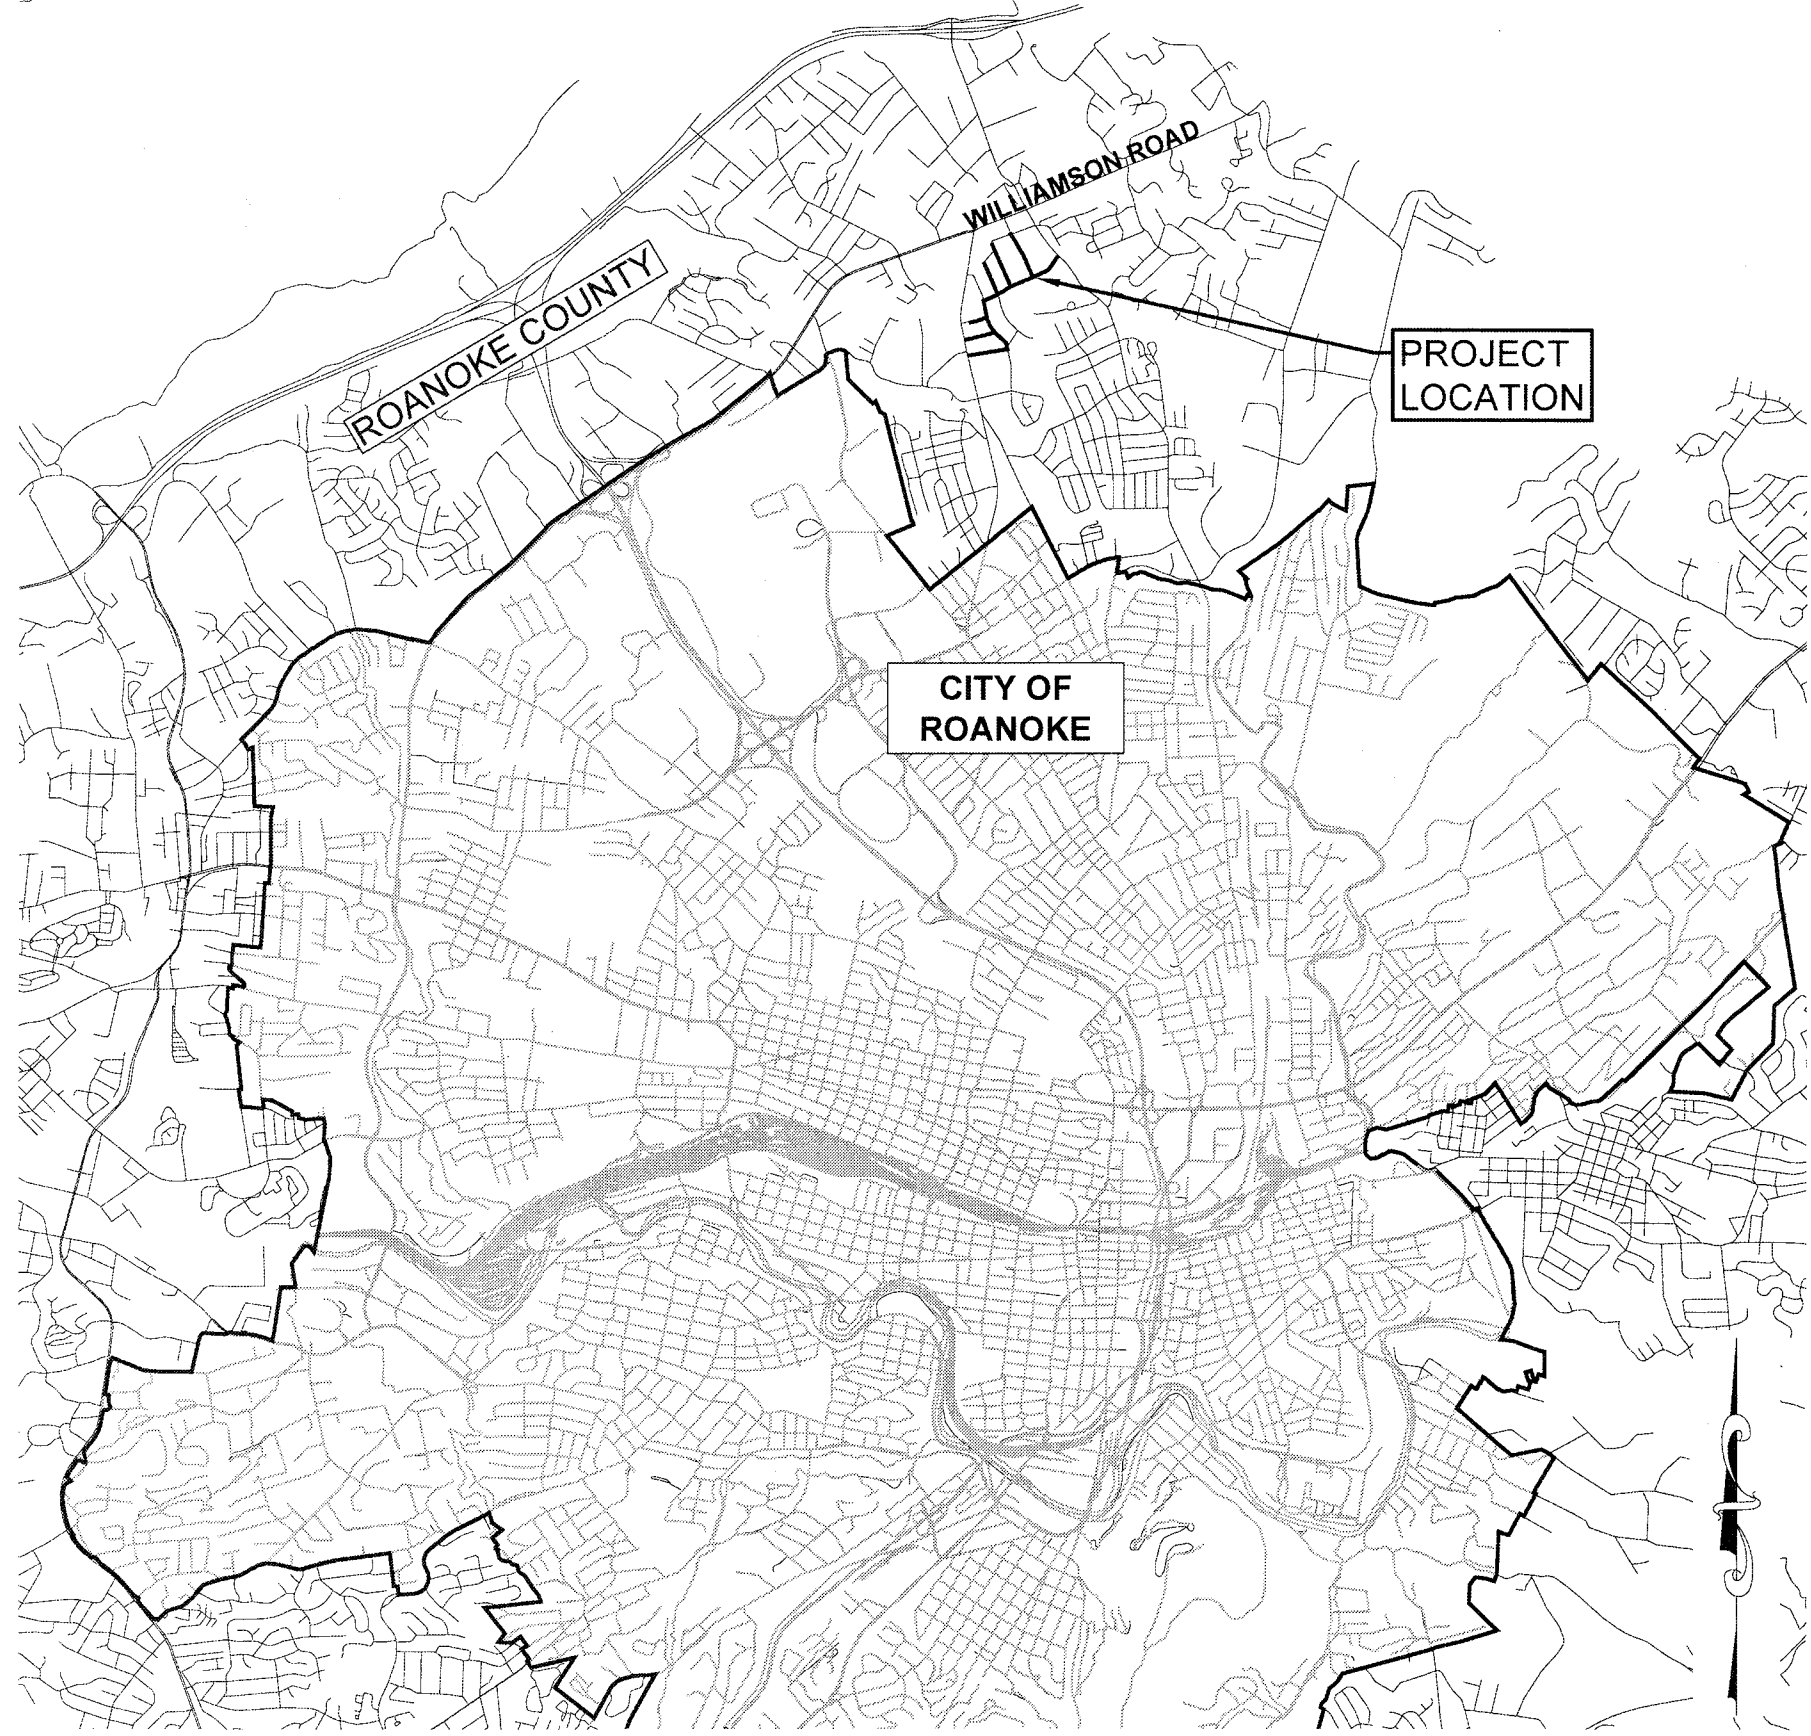

VICINITY MAP
1" = 5000'

Materials: Water line
Main: 12" DIPS CL350 U.S. Pipe / 8" DEECL350 U.S. Pipe / 6" DIPS
Hydrants: A.D. 2018
Services: 1" Polyflex Endot

WESTERN VIRGINIA WATER AUTHORITY


SUNNYBROOK DRIVE WATER MAIN REPLACEMENT

Contractor: S.C. Rossi
Inspector: Justin Filcher / Brian Whiterack
PM: Nick Robertson / Scott Kroll


PREPARED FOR:
WESTERN VIRGINIA WATER AUTHORITY
601 SOUTH JEFFERSON STREET
ROANOKE, VA 24011
TELEPHONE: 540-853-5700
FAX: 540-283-8212

Hydrant #	Pressure	MAHC / Year
20407	87	A.D. 2018
20301	83	A.D. 2018
20938	96	A.D. 2018
22237	75	A.D. 2018
20302	100	A.D. 2018
21293	83	A.D. 2018
20303	100	A.D. 2018
21292	79	A.D. 2018
21295	92	A.D. 2018
20939	92	American Ducting 2018


PREPARED BY:
CHA CONSULTING
1341 RESEARCH CENTER DRIVE
SUITE 2100
BLACKSBURG, VIRGINIA 24060
TELEPHONE: 540-552-5548
FAX: 540-552-5577

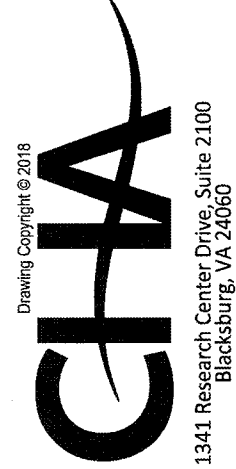

1341 Research Center Drive, Suite 2100
Blacksburg, VA 24060
540.552.5548 • www.chaconsulting.com

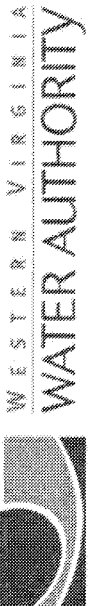

WESTERN VIRGINIA WATER AUTHORITY
ROANOKE, VIRGINIA

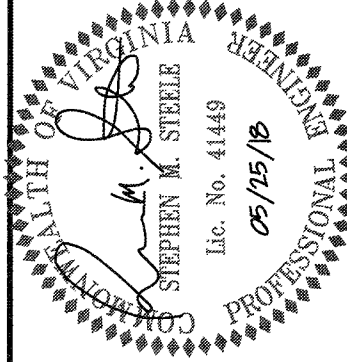

IT IS A VIOLATION OF LAW FOR ANY PERSON, FIRM OR INDIVIDUAL, UNLESS THEY ARE ACTING UNDER THE AUTHORITY OF A LICENSED PROFESSIONAL ENGINEER, TO PREPARE, SEAL OR SIGN ANY ENGINEERING DRAWING OR SPECIFICATION FOR CONSTRUCTION OF ANY PUBLIC WORKS PROJECT WITHOUT BEING A LICENSED PROFESSIONAL ENGINEER. ANY PERSON, FIRM OR INDIVIDUAL WHOSE NAME IS PLACED ON ANY SUCH DRAWING OR SPECIFICATION WITHOUT BEING A LICENSED PROFESSIONAL ENGINEER SHALL BE CONSIDERED TO BE IN VIOLATION OF THE LAW.

WESTERN VIRGINIA WATER AUTHORITY
SUNNYBROOK DRIVE
WATER MAIN REPLACEMENT
ROANOKE COUNTY, VIRGINIA

No.	Submit / Revision	App'd By	Date
1	90% SUBMITTAL	SMS/MBH	5-18-18
2	CLIENT REVIEW	SMS/MBH	5-25-18

TITLE SHEET

Designed By:	Drawn By:	Checked By:
MBH	RAS	LES

Issue Date:	Project No:	Scale:
05/18/18	33834	AS SHOWN

Drawing No.:
G-001

APPROVED FOR CONSTRUCTION

AS-built 08/26/2019