


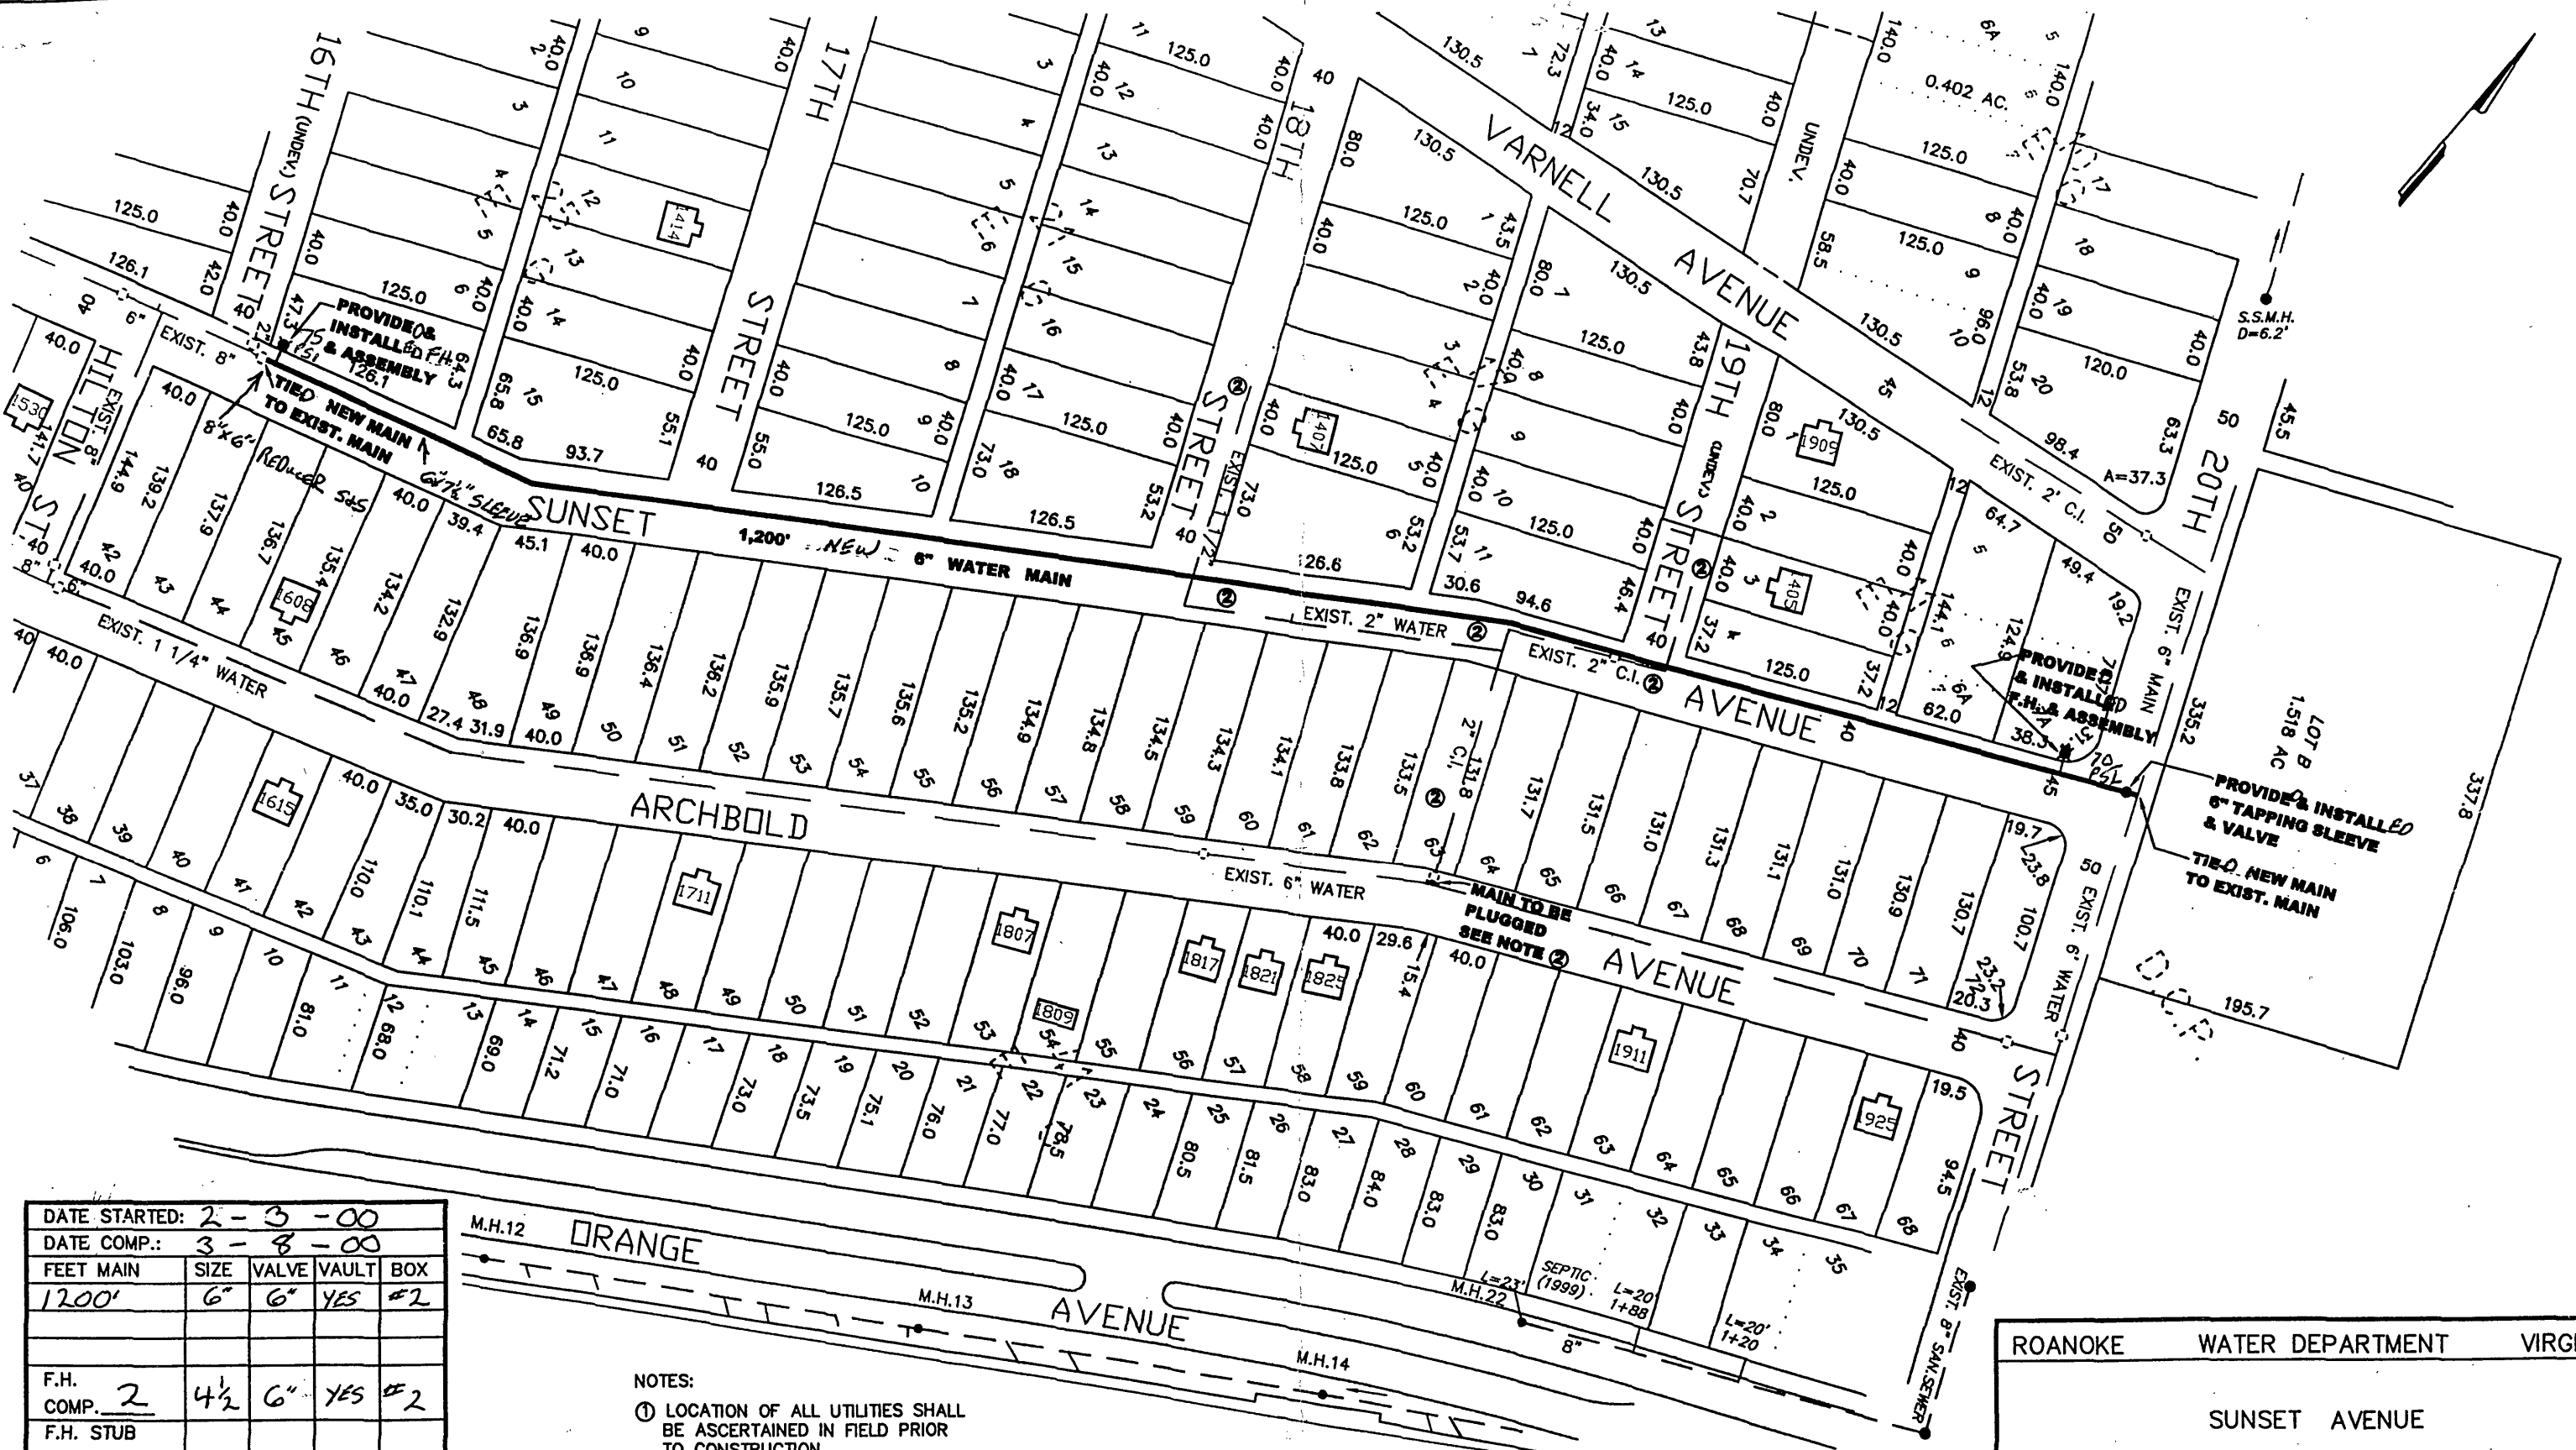

DATE STARTED:	2-3-00			
DATE COMP.:	3-8-00			
FEET MAIN	SIZE	VALVE	VAULT	BOX
1200'	6"	6"	YES	#2
F.H. COMP.	2	4 1/2	6"	YES #2
F.H. STUB ONLY				
SERV.INS.BY:				
MAIN INS.BY:	CLC			
NO. 3/4" SERV.INS.:				
CITY OR CO.:	CITY			
DEPT. INSP.	CLC			

- NOTES:
- LOCATION OF ALL UTILITIES SHALL BE ASCERTAINED IN FIELD PRIOR TO CONSTRUCTION.
 - 1 1/2" & 2" MAINS TO BE ABANDONED AFTER SERVICES ARE TIED OVER TO NEW 6" MAIN.

1195' 6" DUCTILE IRON SJ
 1 - 6" x 8" REDUCER S+S
 1 - 6" x 7 1/2" SLEEVE M+S
 AS BUILT
 CLC 3-9-00

ROANOKE	WATER DEPARTMENT	VIRGINIA
SUNSET AVENUE		
20TH STREET, N.E.		
SCALE:	1"=100'	DIRECTOR OF UTILITIES & OPERATIONS DATE
DATE:	2/11/2000	DIRECTOR OF PUBLIC WORKS DATE
CAD MAP:	0673	MANAGER OF WATER DEPARTMENT DATE
DIST. MAP:	322	MANAGER OF UTILITY LINE SERVICES DATE
PLAN NO.:	20-02	2/25/00