


16th Street

Sunset Avenue

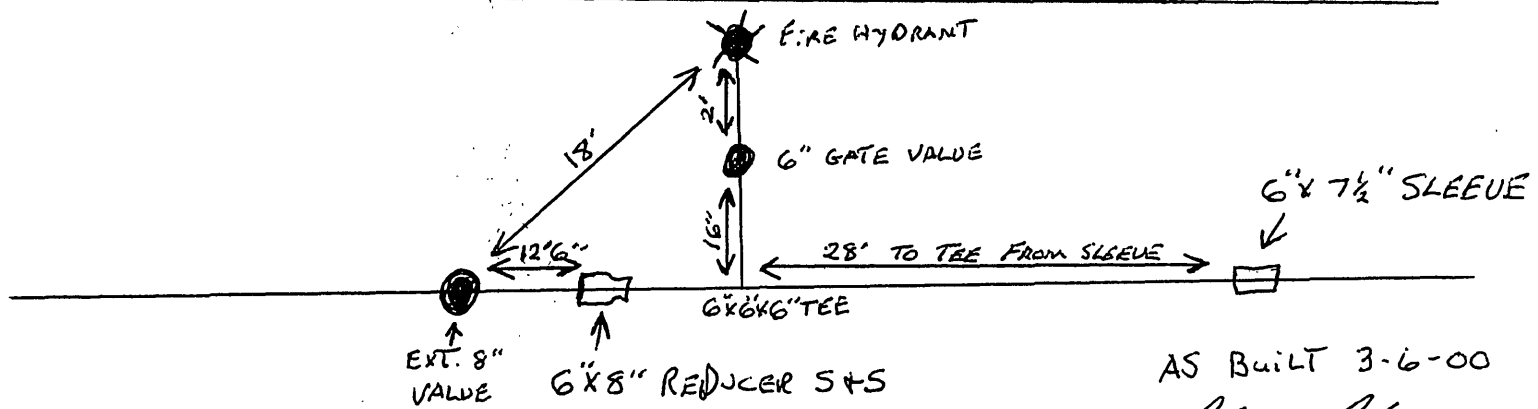

AS BUILT 3-6-00

Handwritten signature

SUNSET & 16TH ST. NE