


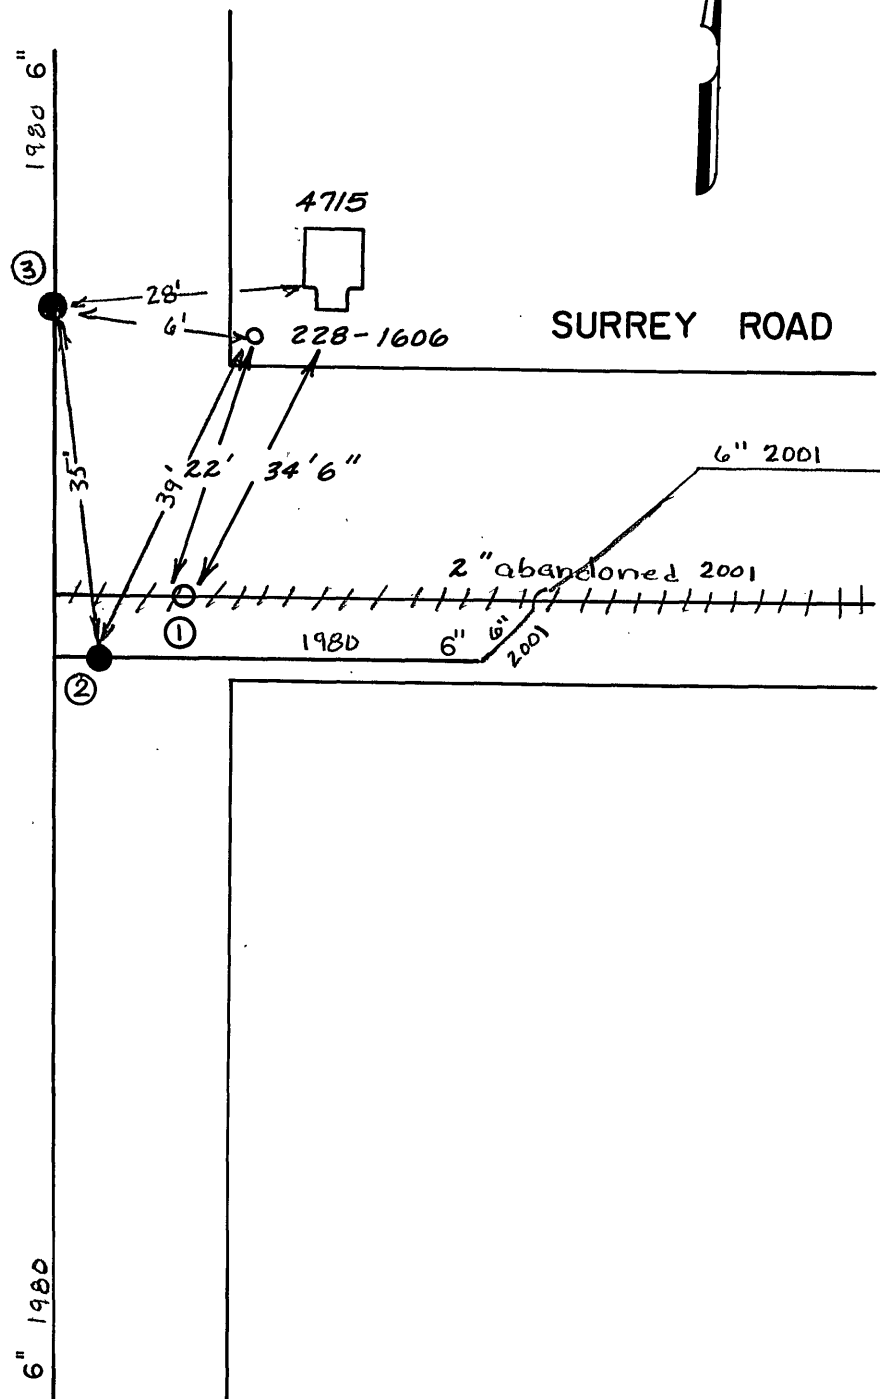

CITY OF HOANOSKE--WATER DEPT
VALVE DIAGRAM
GUN CLUB ROAD &
SURREY ROAD
REC. MAP 610, 611 N.W.
DATE PAGE NO.