


HERSHBERGER ROAD TACO BELL RENOVATIONS

1406 HERSHBERGER ROAD, N.W.
CITY OF ROANOKE, VIRGINIA
TAX NUMBER: 2280606

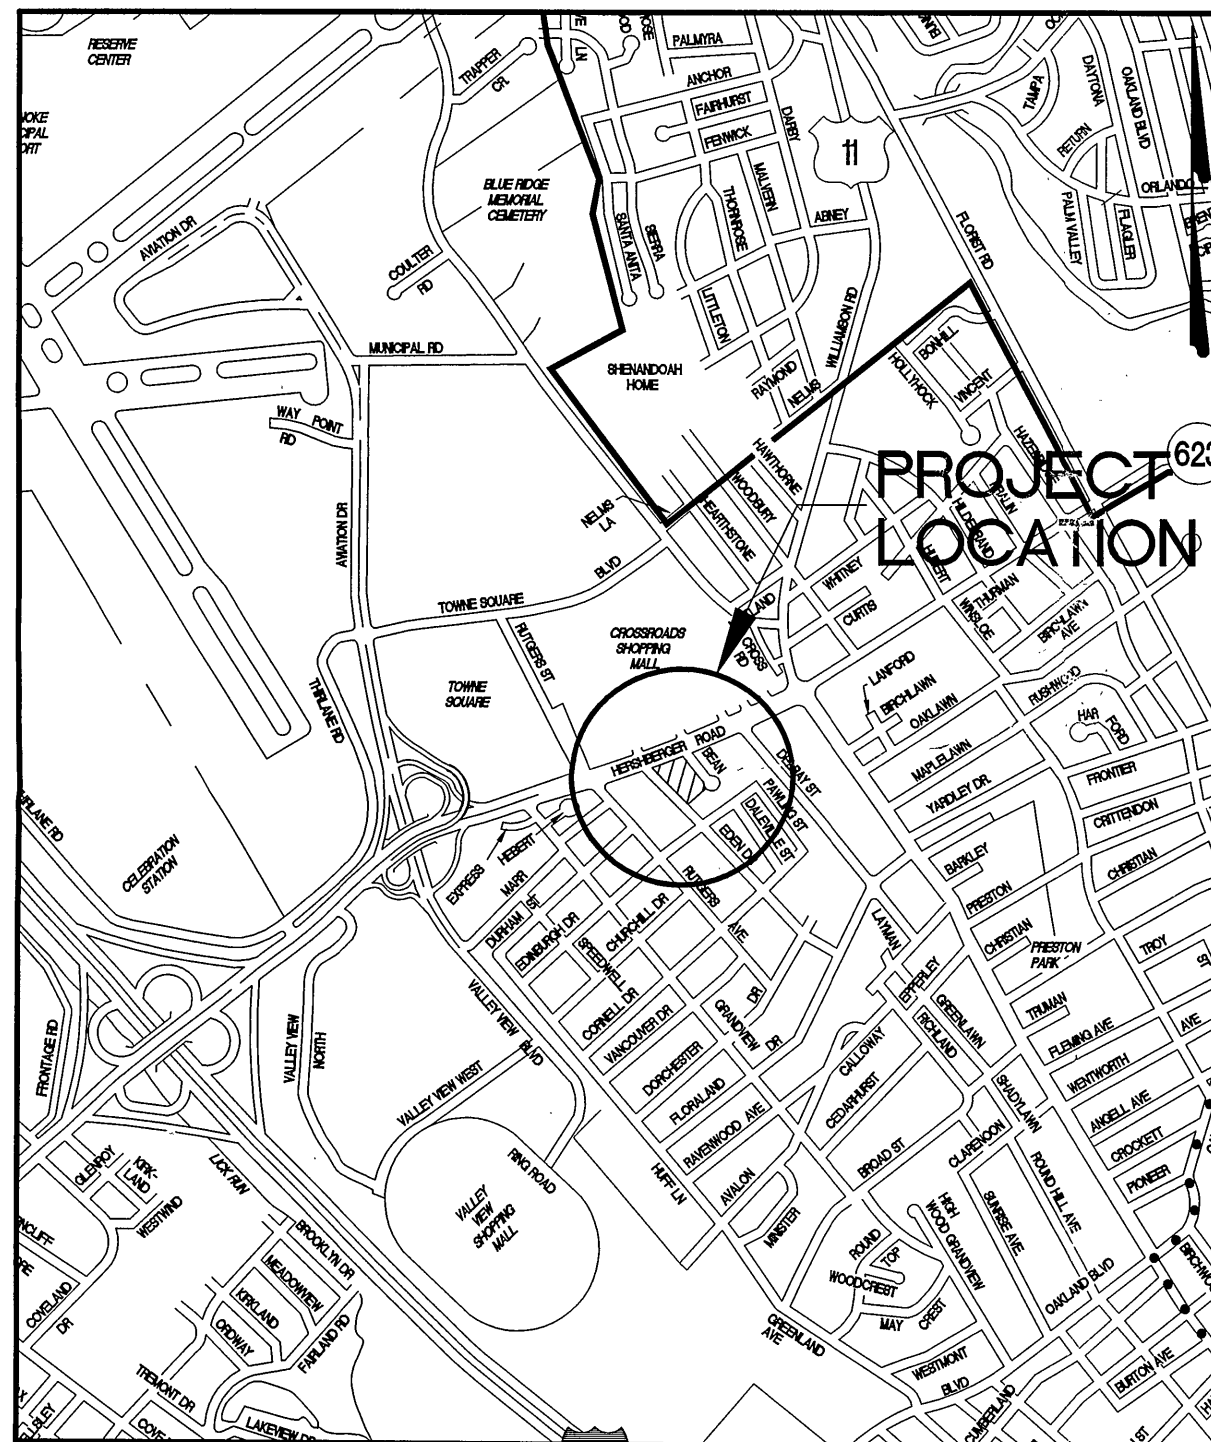

LOCATION MAP
NO SCALE

Construction Procedure Requirements:

1. Right-of-Way Excavation Permit – Prior to the commencement of any digging, alteration or construction within the public right-of-way (streets, alleys, public easements), a right-of-way excavation permit shall be applied for and obtained by the contractor from the City of Roanoke.
2. Land Disturbance Permit – An approved erosion and sediment control plan for any borrow/fill sites associated with the project must be submitted prior to the issuance of a land disturbance permit.
3. Plans and Permits – A copy of the plans as approved by the City (signed by the proper City officials) and all permits issued by the City shall be available at the construction site at all times of ongoing construction.
4. Location of Utilities – The contractor shall verify the location of all existing utilities prior to the commencement of any construction.
5. Construction Entrance – The contractor shall install an adequate construction entrance for all construction related egress from the site. Size and composition of construction entrance shall be as shown on the plans.
6. Streets to Remain Clean – It shall be the responsibility of the contractor to insure that the public street adjacent to the construction entrance remains free of mud, dirt, dust, and/or any type of construction materials or litter at all times.
7. Barricades/Ditches – The contractor shall maintain the integrity of all excavated ditches and shall furnish and ensure that all barricades proper and necessary for the safety of the public are in place.
8. Sewer and Pavement Replacement – Construction of sanitary sewers and the replacement of pavement shall be in accordance with approved standards and specifications of the City of Roanoke and the Western Virginia Water Authority.
9. Approved Plans/Construction Changes – Any change or variation from construction design as shown on the officially approved plans shall be approved by the erosion and sediment control agent prior to said changes or variation in construction being made.
10. Final Acceptance/City – The owner or developer shall furnish the City of Roanoke's Planning Building and Development Department with a field surveyed final/correct set of as-built plans of the newly constructed storm rain and/or stormwater management facilities prior to final acceptance and issuance of a certificate of occupancy by the City. As-built plans shall be provided in the State Plane Virginia South Coordinate System, NAD 1983, FIPS 4502 Feet, US Survey Feet, Datum NA 83, in the form of 1 paper copy and 1 digital AUTOCAD file.

SHEET LIST:

- C-1 COVER SHEET
- C-2 LEGEND AND ABBREVIATIONS
- C-3 EXISTING CONDITIONS/DEMOLITION PLAN
- C-4 SITE/UTILITIES PLAN
- C-5 GRADING/EROSION AND SEDIMENT CONTROL PLAN
- C-6 EROSION AND SEDIMENT CONTROL NARRATIVE
- C-7 CONSTRUCTION DETAILS
- C-8 EROSION AND SEDIMENT CONTROL DETAILS

OWNER:

TACOMA MANAGEMENT, INC.
328 E. CHURCH STREET
MARTINSVILLE, VA 24112
PHONE: (540) 314-9008
CONTACT: TIM REITH, PRESIDENT
E-MAIL: TREITH@AOL.COM

ENGINEER:


MATTERN & CRAIG, INC.
701 1 ST STREET, S.W.
ROANOKE, VA 24016
PHONE: (540) 345-9342
FAX: (540) 345-7691
CONTACT: TOM AUSTIN, P.E.
E-MAIL: WTAUSTIN@MATTERNANDCRAIG.COM

ARCHITECT:


THOMAS KOONTZ • ARCHITECT, PC
300 CHURCH STREET
BLACKSBURG, VA 24060
PHONE: (540) 951-4925
FAX: (540) 951-4950
CONTACT: THOMAS KOONTZ
E-MAIL: TOM@TKAPC.COM

CITY PLAN NO.: CP100029

Mattern & Craig, Inc.
CONSULTING ENGINEERS • SURVEYORS
701 FIRST STREET, S.W.
ROANOKE, VIRGINIA 24016
(540) 345-9342
(540) 345-7691 FAX

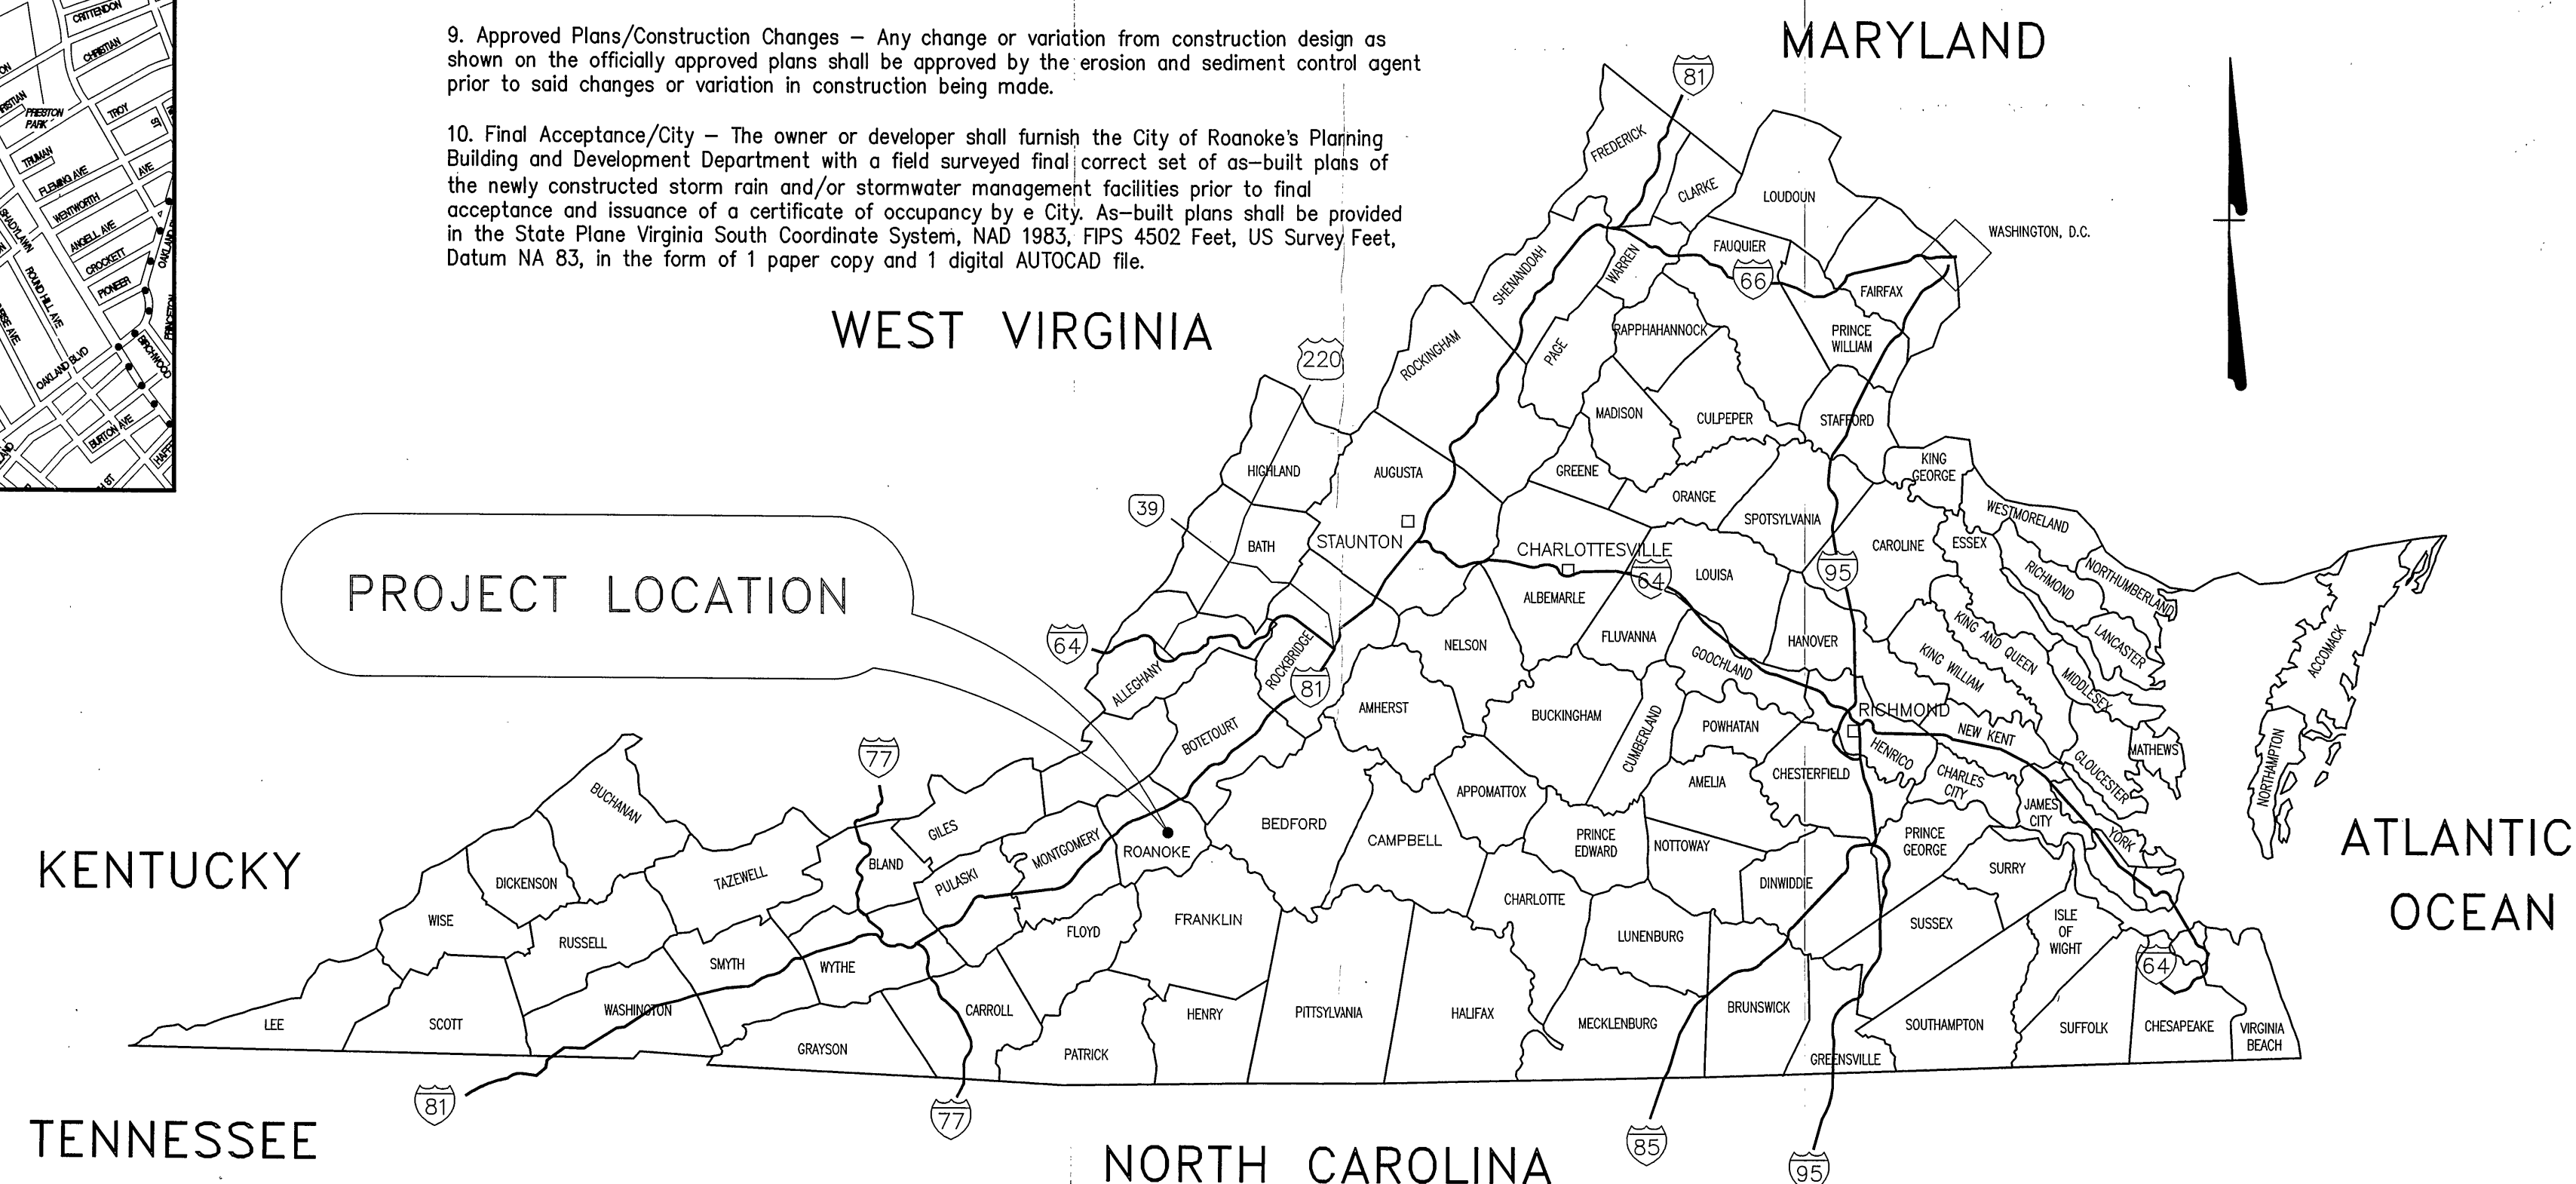

City of Roanoke
Planning Building and Development
DEVELOPMENT PLAN APPROVED
Agent, Planning Commission *[Signature]* Date *9/3/2010*
Development Engineer *[Signature]* *9-3-2010*
Zoning Administrator *[Signature]* *9/3/2010*
Any changes to this approved plan must be coordinated with the Agent to the Planning Commission and revisions approved prior to construction.

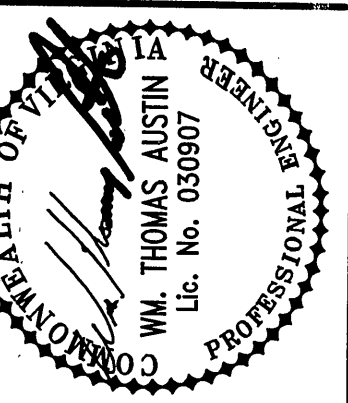

Revisions	Issue	Date
0 ORIGINAL ISSUE	8/15/10	
1 CITY OF ROANOKE COMMENTS	8/19/10	

Issue Date:	June 15, 2010
Drawn By:	ARB
Designed By:	ARB
Checked By:	WTA
Date:	06-15-10

Mattern & Craig
CONSULTING ENGINEERS • SURVEYORS
701 FIRST STREET, S.W.
ROANOKE, VIRGINIA 24016
(540) 345-9342
(540) 345-7691 FAX

HERSHBERGER ROAD TACO BELL RENOVATIONS
COVER SHEET
CITY OF ROANOKE, VIRGINIA

Vertical Scale:	N/A
Horizontal Scale:	N/A
Commission Number:	3059
Sheet No.:	C-1

As-Built

11.19.10 K. Winslow