


422

as Built
5-11-07

sanitary sewer map #423
Contractor: Economy Plumbing

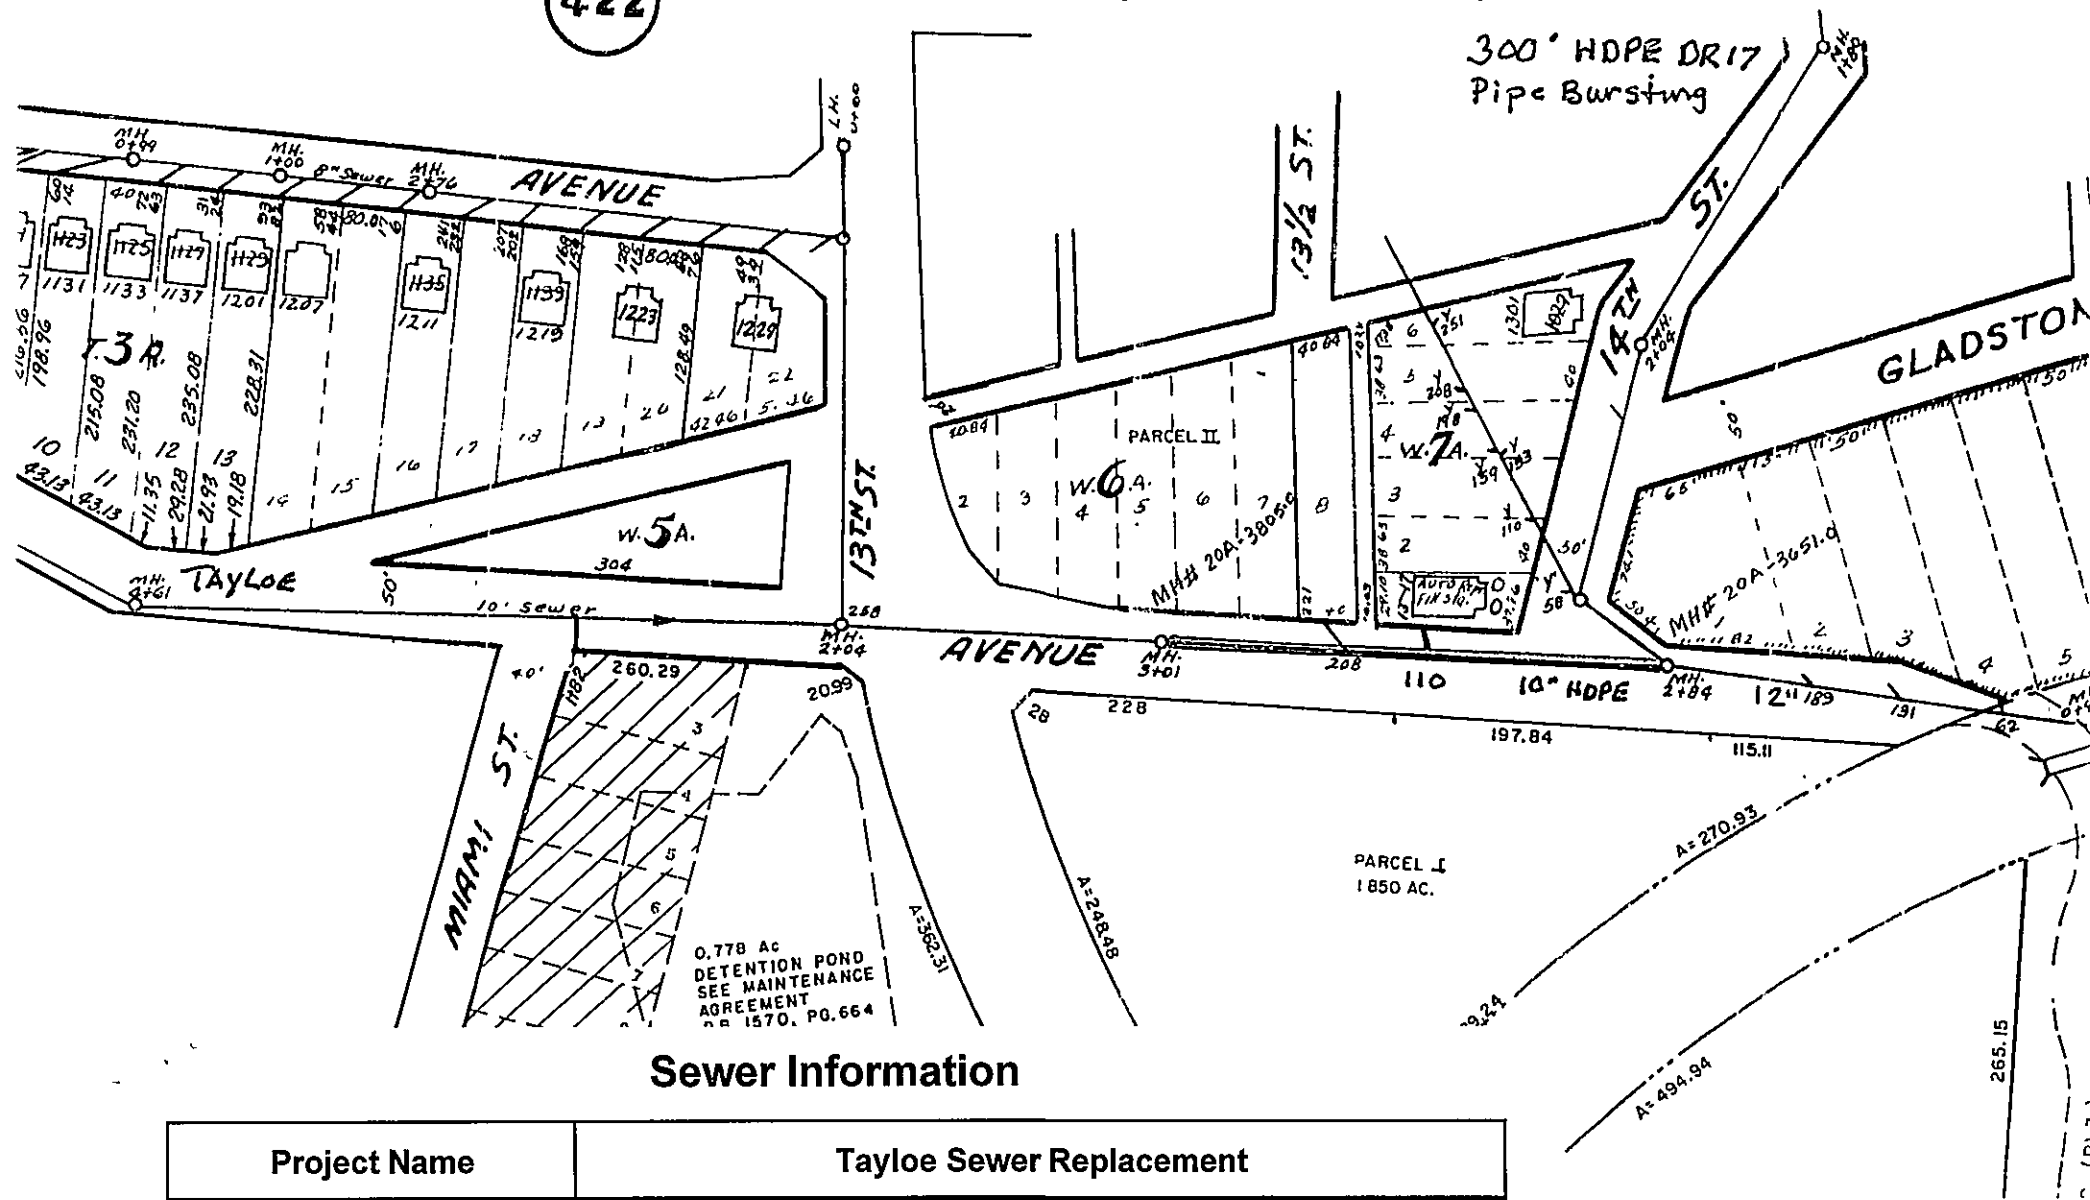

Sewer Information

Project Name	Taylor Sewer Replacement
Install Contractor	Economy Plumbing
Install Date	5/11/2007
Sewer Gravity Main(s)	
Manufacturer	Driscopex
Diameter / Pipe Class / Material	10"-DR17-HDPE
Comments	300'
Sewer Force Main(s)	
Manufacturer	
Diameter / Pipe Class / Material	
Comments	
Sewer Gravity Lateral(s)	
Manufacturer	National
Diameter / Pipe Class / Material	6"-SDR35-PVC
Comments	6'
Sewer Pressure Lateral(s)	
Manufacturer	
Diameter / Pipe Class / Material	
Comments	
Sewer Manhole(s)	
Manufacturer	
Material	
Ring & Cover Manuf. & Type	
Comments	

WVWA ID# 7C7K8X