

"AS-BUILT" 12 JUNE 1997
DEVELOPMENT PLANS

FOR

"THE ORCHARDS" APPLEWOOD, SECTION No. 10

SITUATED IN

HOLLINS MAGISTERIAL DISTRICT
ROANOKE COUNTY, VIRGINIA


DATE: JULY 6, 1994

PROPERTY OF
F & W COMMUNITY DEVELOPMENT CORP.

"AS-BUILT"

NOTE:

1. "AS-BUILT" INFORMATION TAKEN FROM PLANS FURNISHED BY J.P. TURNER & BROTHERS, INC., CONTRACTOR.
2. "AS-BUILT" DIMENSIONS SHOWN IN BRACKETS.

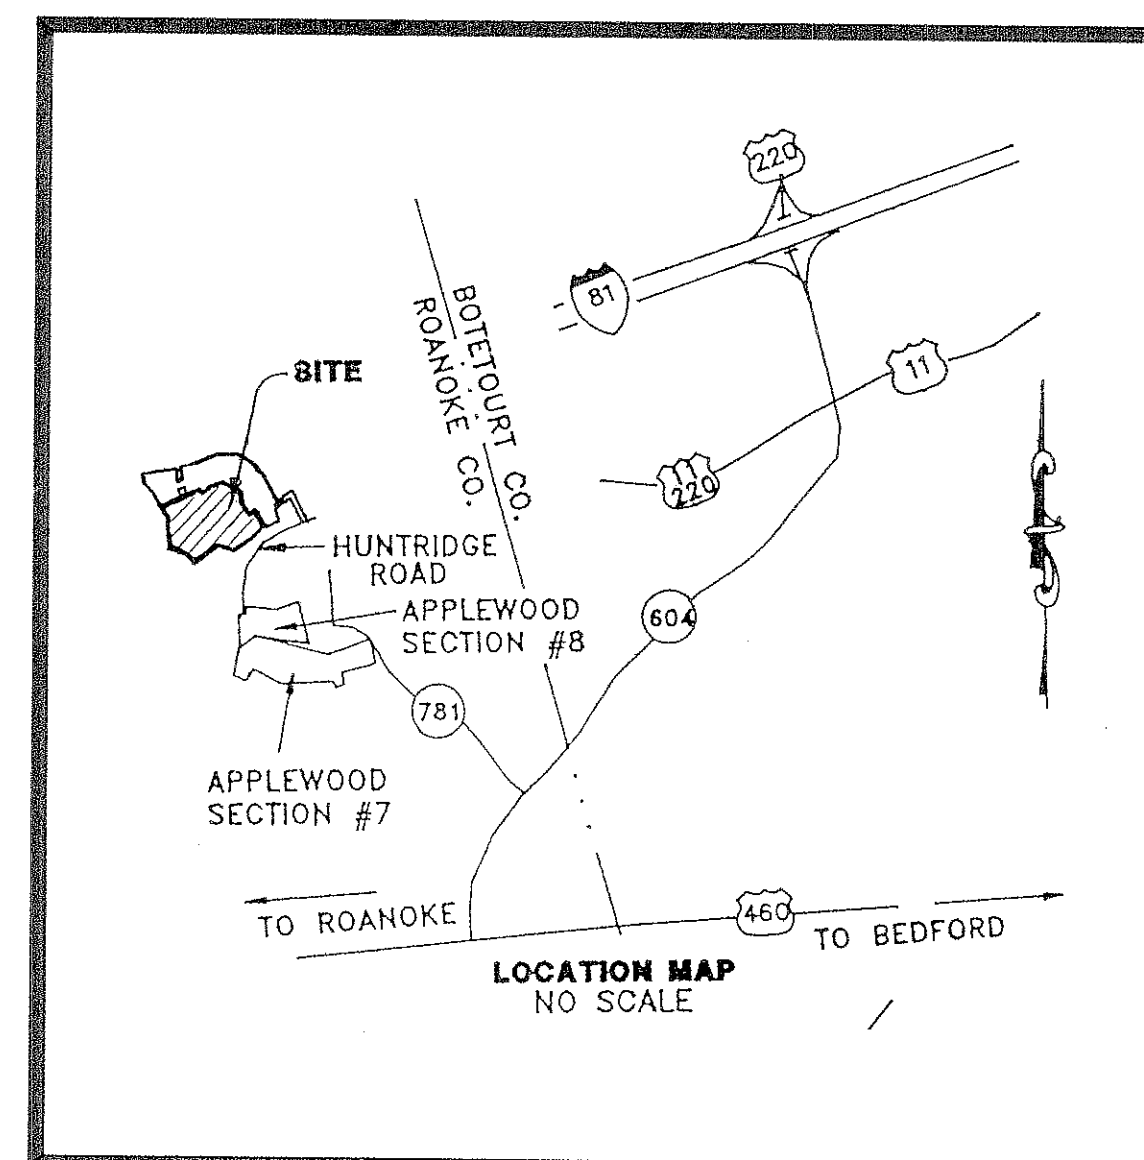

INDEX OF DRAWINGS

SHEET No.	DESCRIPTION
-----------	-------------

- | | |
|-----|--|
| 1. | LUMSDEN ASSOCIATES COVER SHEET |
| 2. | ROANOKE COUNTY STD. COVER SHEET |
| 3. | RECORD MAP |
| 4. | NOTES & DETAILS |
| 5. | PLAN & PROFILE |
| 6. | PLAN & PROFILE |
| 7. | DRAINAGE DIVIDE MASTER PLAN |
| 8. | EROSION CONTROL PLAN |
| 9. | EROSION CONTROL PLAN |
| 10. | EROSION CONTROL DETAIL SHEET |
| 11. | ROANOKE CO. STD. WATER DETAIL SHEET |
| 12. | ROANOKE CO. STD. SAN. SEWER DETAIL SHEET |

LUMSDEN ASSOCIATES, P.C.
ENGINEERS—SURVEYORS—PLANNERS
ROANOKE, VIRGINIA