

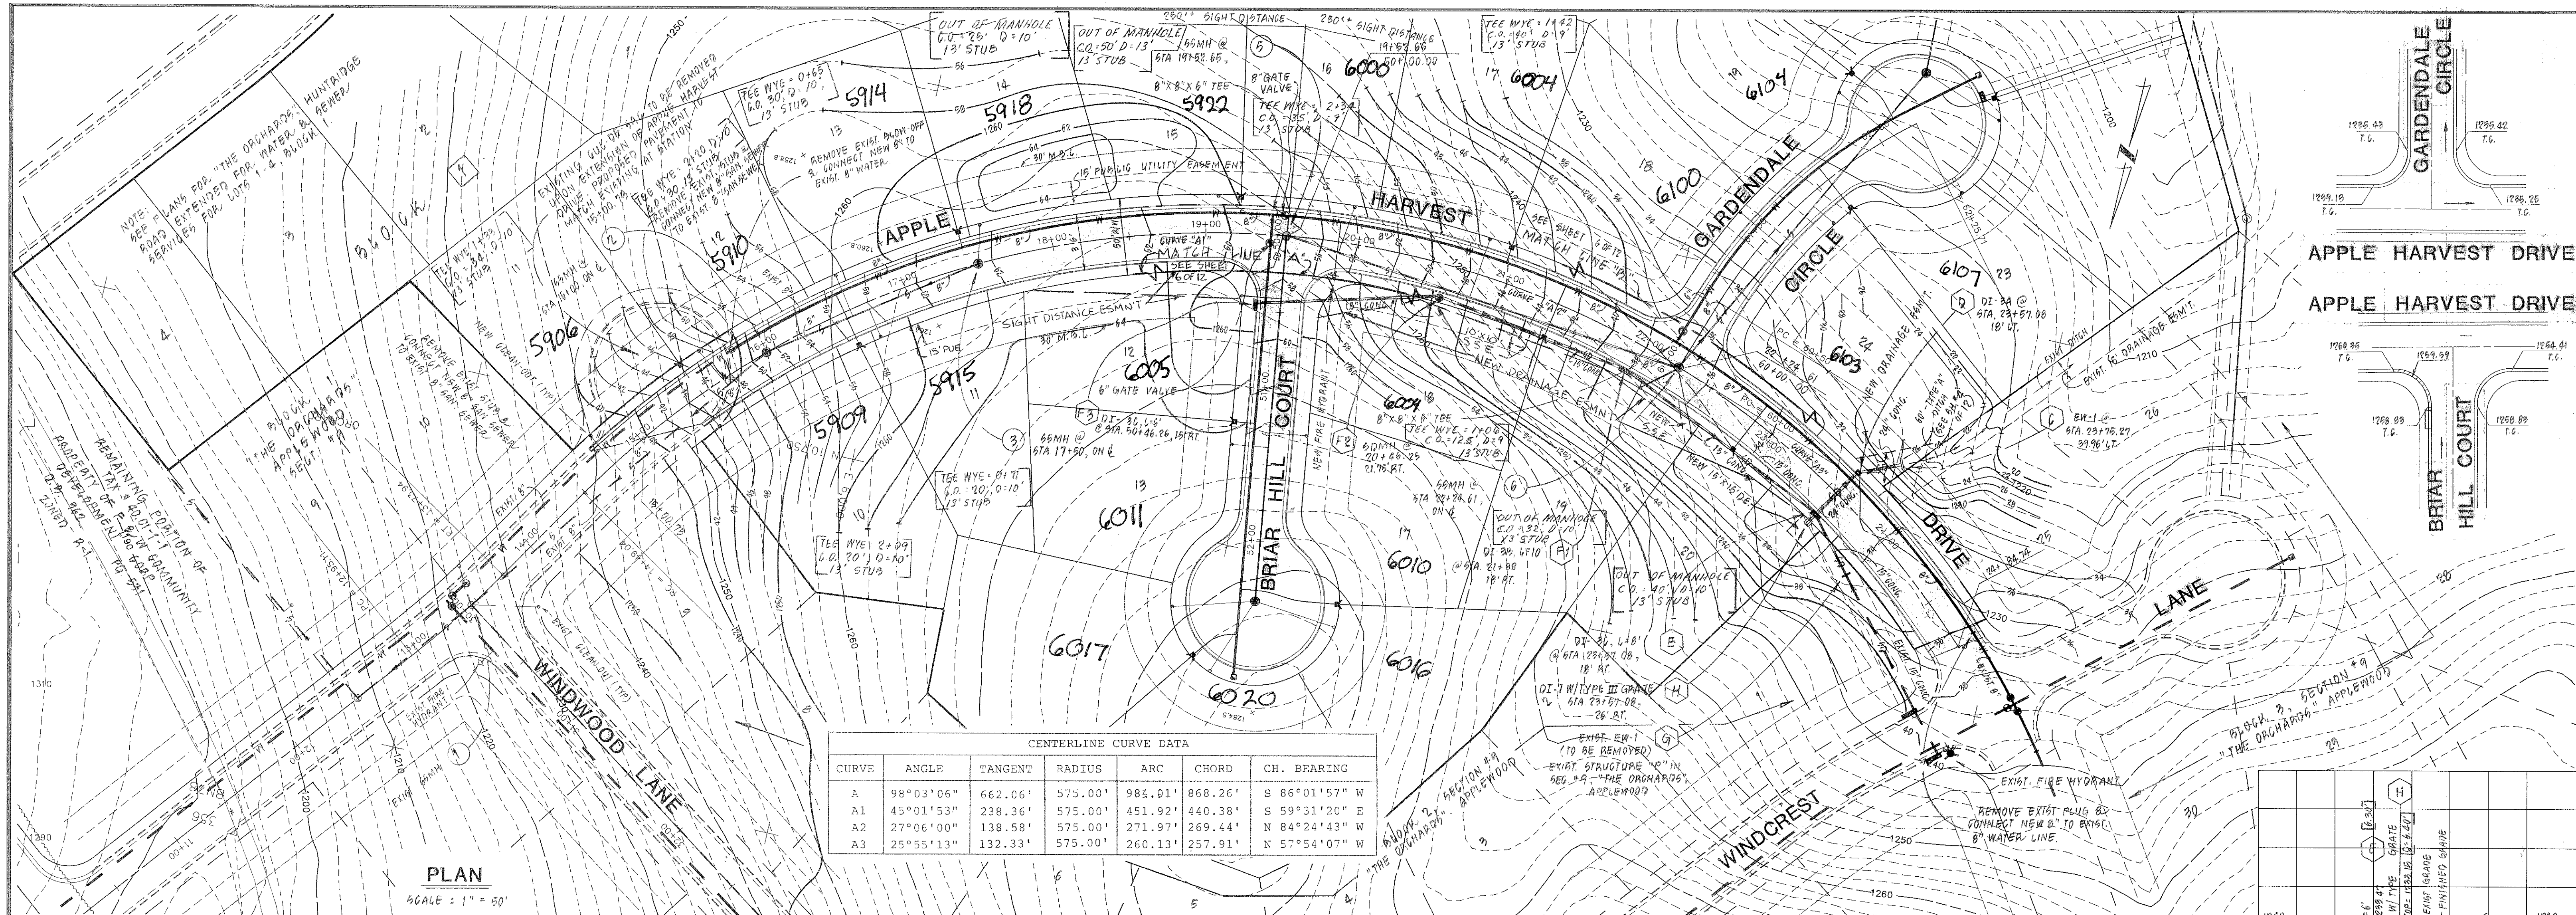


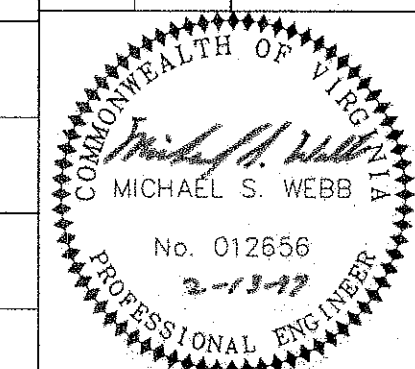

CURVE	ANGLE	TANGENT	RADIUS	ARC CHORD	CH. BEARING
A	98°03'06"	662.06'	575.00'	984.01'	S 86°01'57" W
A1	45°01'53"	238.36'	575.00'	451.92'	S 59°31'20" E
A2	27°06'00"	138.58'	575.00'	271.97'	N 84°24'43" W
A3	25°55'13"	132.33'	575.00'	260.13'	N 57°54'07" W

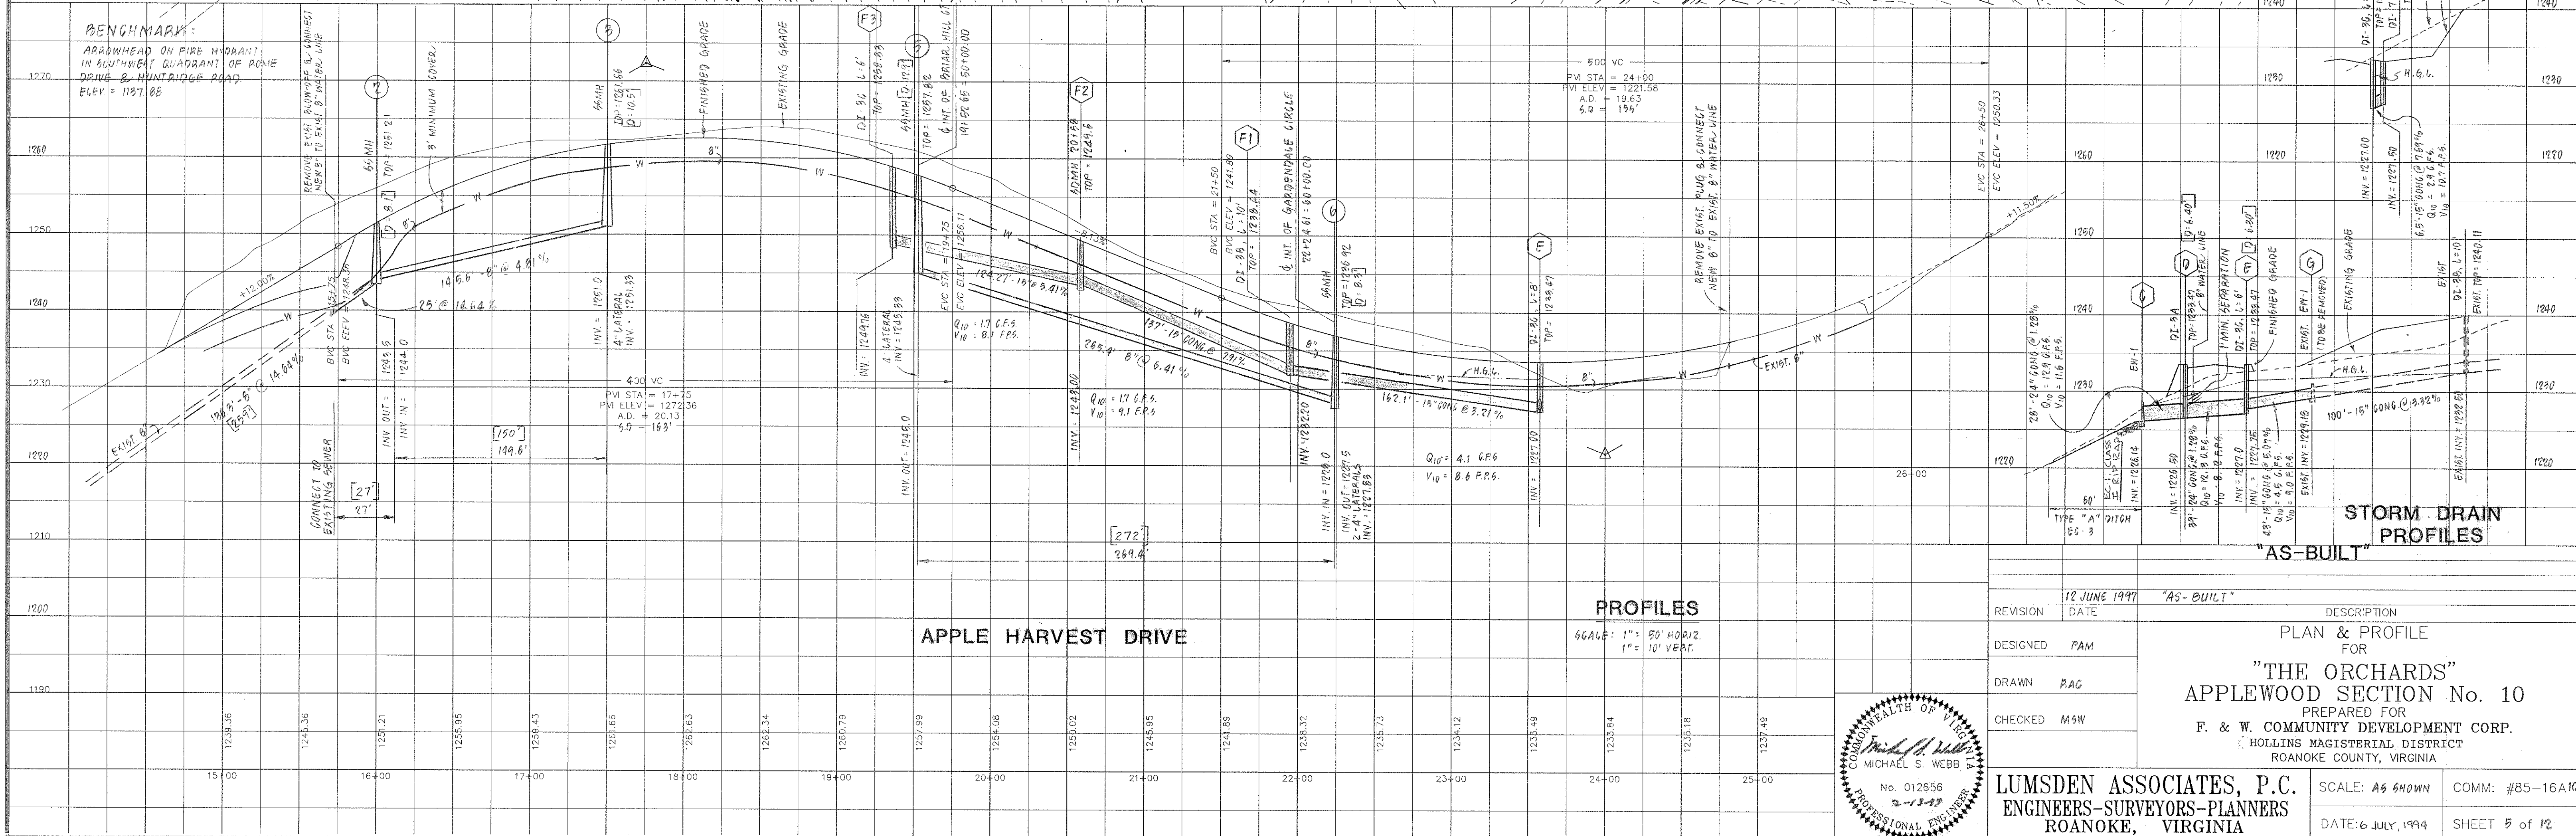

REVISION	12 JUNE 1997	DATE	"AS-BUILT"
DESIGNED	PAM	DESCRIPTION	
DRAWN	PAG	PLAN & PROFILE FOR	
CHECKED	MHW	"THE ORCHARDS" APPLEWOOD SECTION No. 10	
PREPARED FOR F. & W. COMMUNITY DEVELOPMENT CORP.			
HOLLINS MAGISTERIAL DISTRICT ROANOKE COUNTY, VIRGINIA			
LUMSDEN ASSOCIATES, P.C.		SCALE: AS SHOWN	COMM: #85-16A10
ENGINEERS-SURVEYORS-PLANNERS		DATE: 6 JULY, 1994	SHEET 5 of 12
ROANOKE, VIRGINIA			

RC-7254