


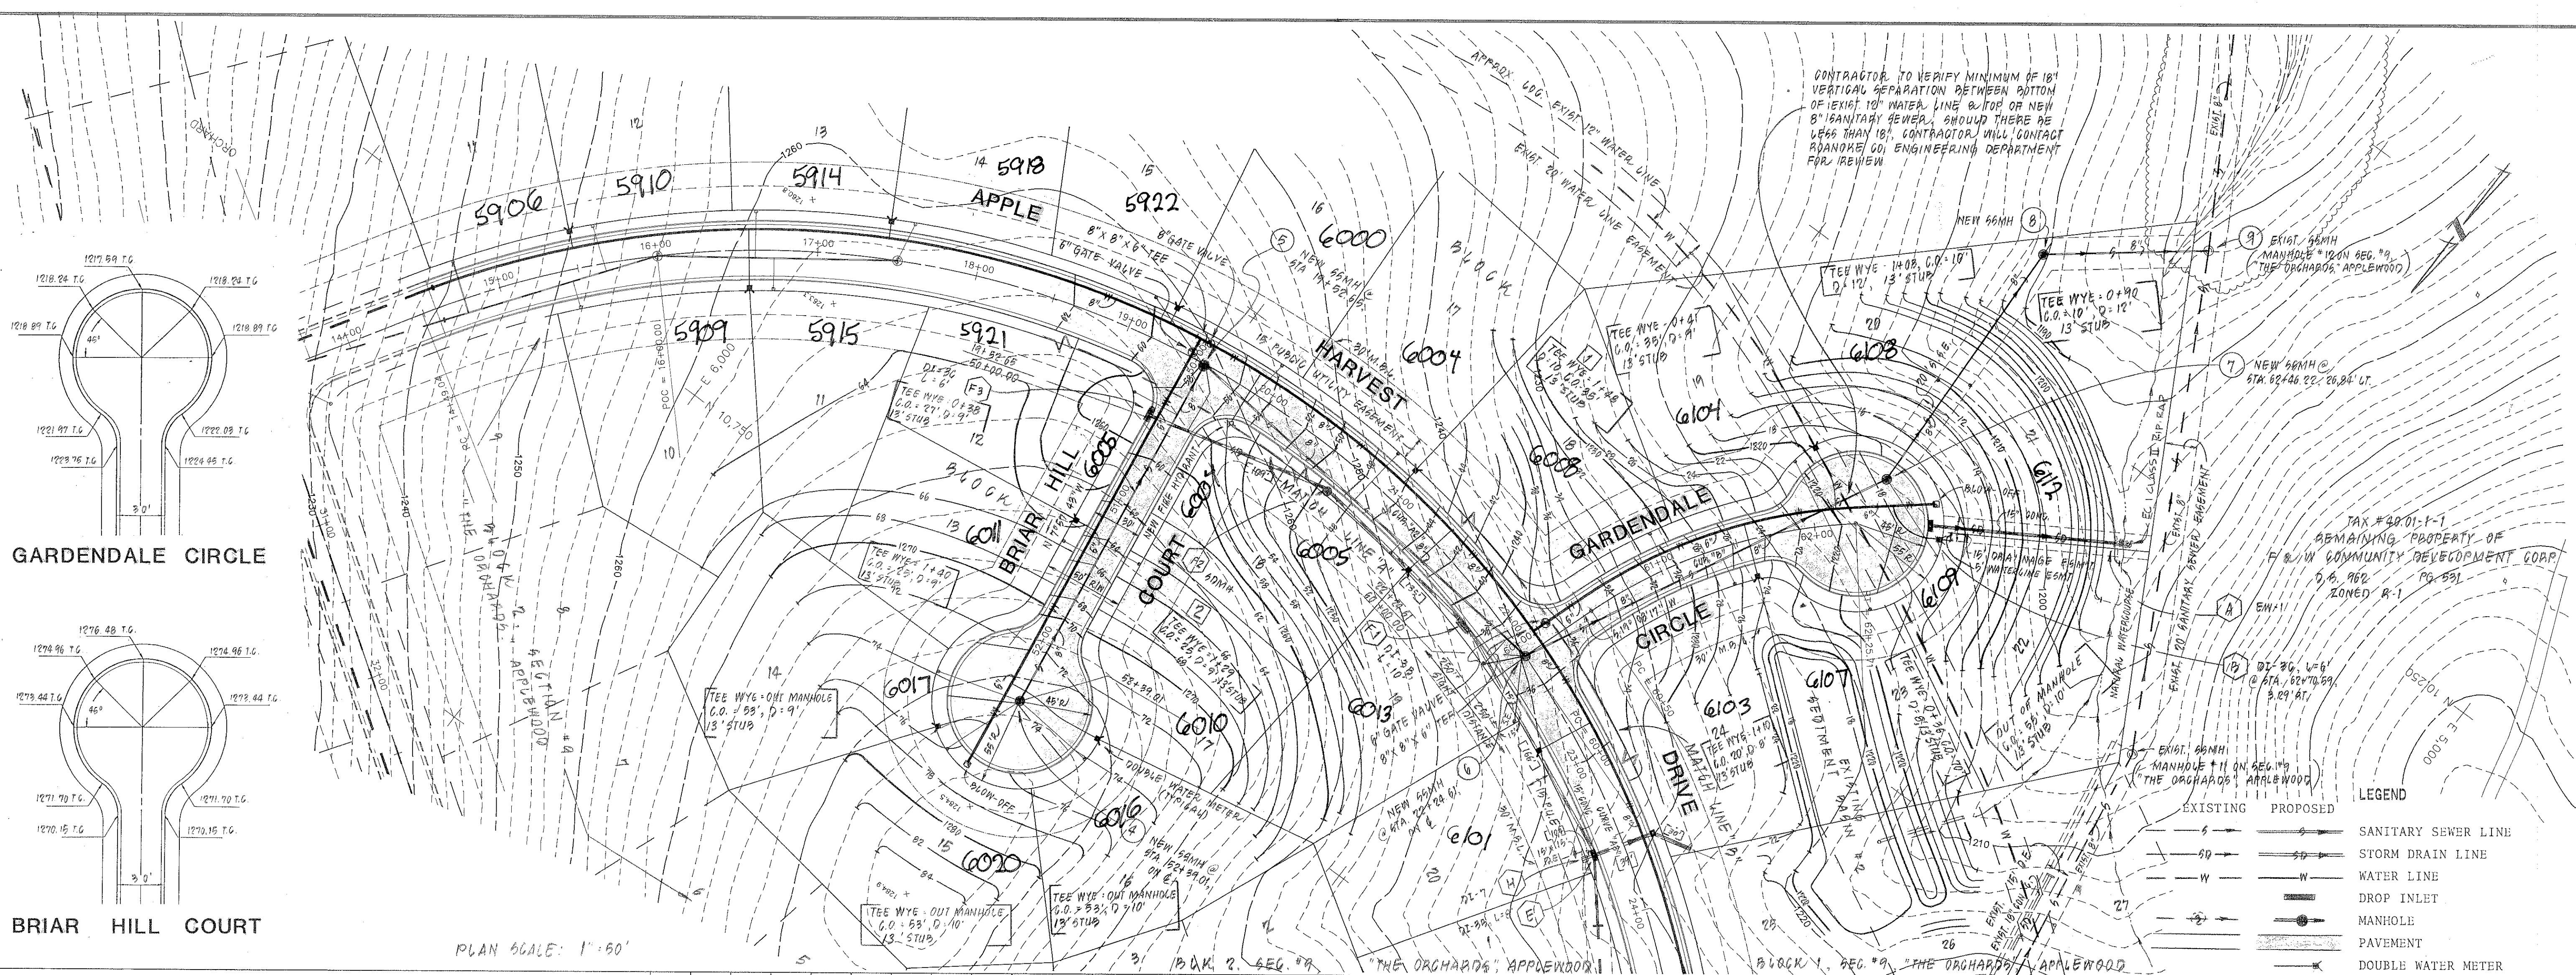

GARDENDALE CIRCLE

BRIAR HILL COURT

CENTERLINE CURVE DATA						
CURVE	ANGLE	TANGENT	RADIUS	ARC	CHORD	CB BEARING
A2	27°06'00"	138.58'	575.00'	271.97'	263.44'	N 84°24'43" E
B	31°40'20"	90.16'	317.86'	175.71'	173.48'	S 34°58'26" E

SANITARY SEWER LATERAL TABLE			
LOT & LATERAL #	GRADE	MINIMUM FINISHED FLOOR ELEVATION	
BLOCK 1			
1	2.08%	1186.0'	
2	"	1188.0'	
3	"	1188.5'	
4	"	1189.0'	
11	"	1233.0'	
12	"	1244.0'	
13	"	1251.0'	
14	"	1255.0'	
15	"	1254.0'	
16	"	1247.0'	
17	"	1241.0'	
18	"	1224.0'	
19	"	1218.0'	
20	"	1213.0'	
21	"	1210.0'	
22	"	1210.0'	
23	"	1216.0'	
24	"	1224.0'	
BLOCK 2			
10	"	1246.0'	
11	"	1252.0'	
12	"	1253.0'	
13	"	1263.0'	
14	"	1268.0'	
15	"	1270.0'	
16	"	1268.0'	
17	"	1263.0'	
18	"	1245.0'	
19	"	1239.0'	
20	"	1233.0'	


SANITARY SEWER PROFILE

GARDENDALE CIRCLE

PROFILES

SCALE: 1" = 50' HORIZ
1" = 10' VERT.

BRIAR HILL COURT

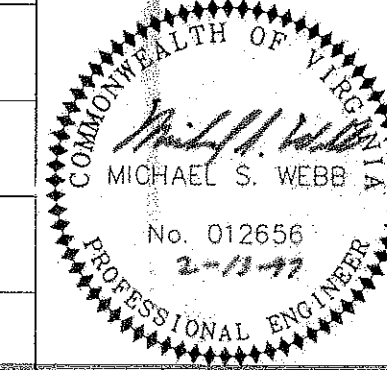

LUMSDEN ASSOCIATES, P.C.
ENGINEERS-SURVEYORS-PLANNERS
ROANOKE, VIRGINIA

"AS-BUILT"

REVISION	DATE	DESCRIPTION
1	12 JUNE 1997	"AS-BUILT"

DESIGNED: PAM
DRAWN: RAG
CHECKED: MSW

PLAN & PROFILE FOR
"THE ORCHARDS"
APPLEWOOD SECTION No. 10
PREPARED FOR
F. & W. COMMUNITY DEVELOPMENT CORP.
HOLLINS MAGISTERIAL DISTRICT
ROANOKE COUNTY, VIRGINIA

SCALE: AS SHOWN
DATE: 6 July 1999
COMM: #85-16A10
SHEET 6 of 12