



This document, together with the concepts and designs presented herein, is an instrument of service, and shall be without liability to Engineering Concepts, Inc. Reuse of and improper reliance on this document without written authorization and adaptation by Engineering Concepts, Inc. shall be without liability to Engineering Concepts, Inc.

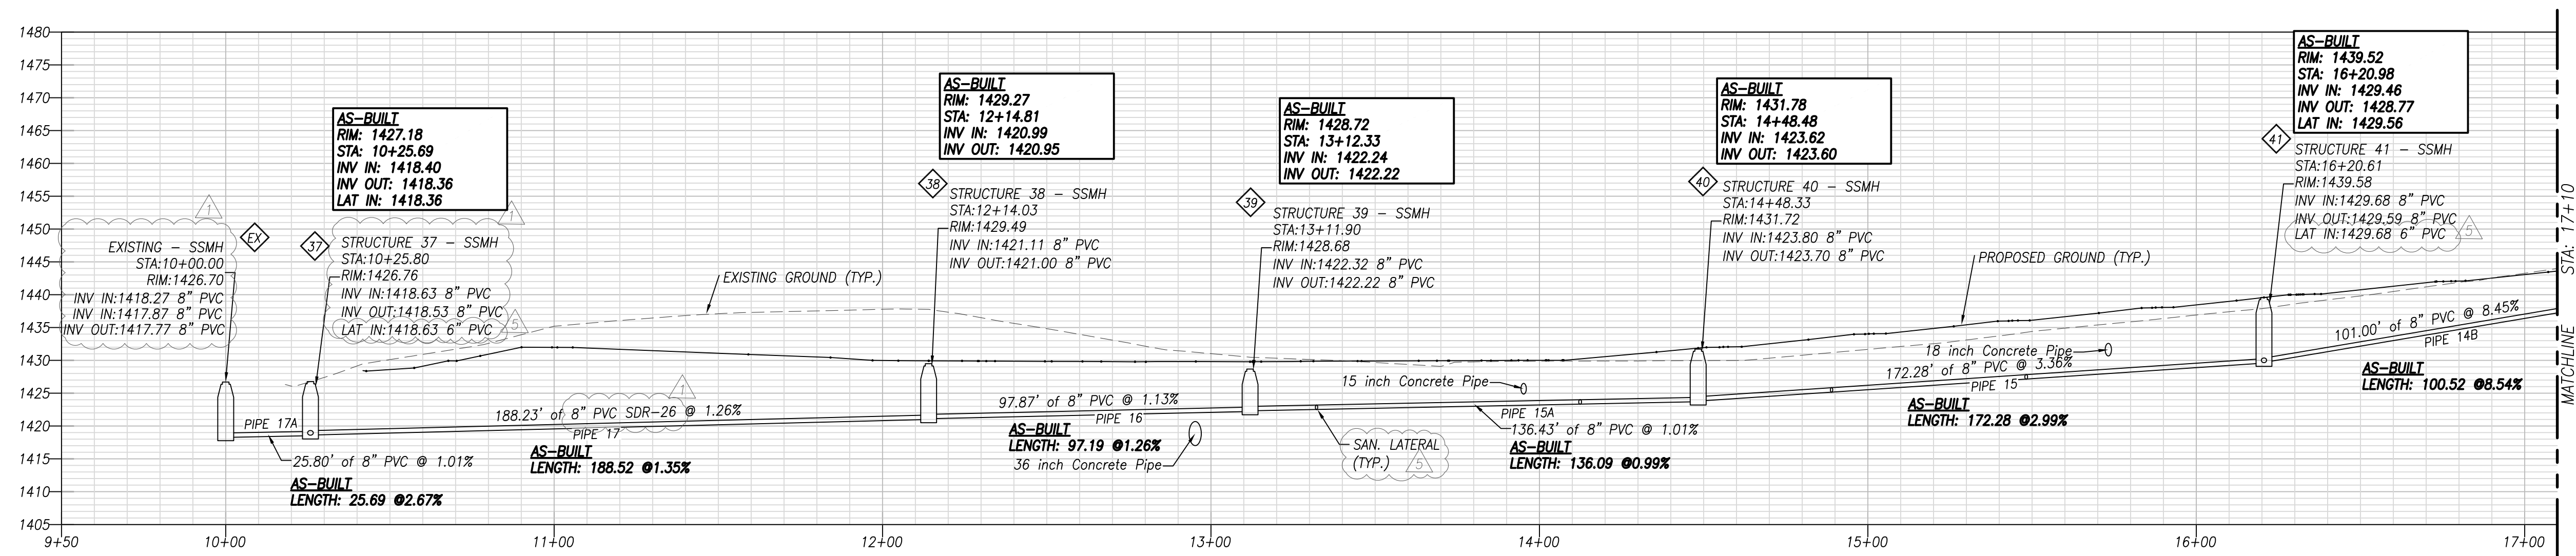


SANITARY SEWER B PROFILE
VERTICAL SCALE: 1" = 15'
HORIZONTAL SCALE: 1" = 30'

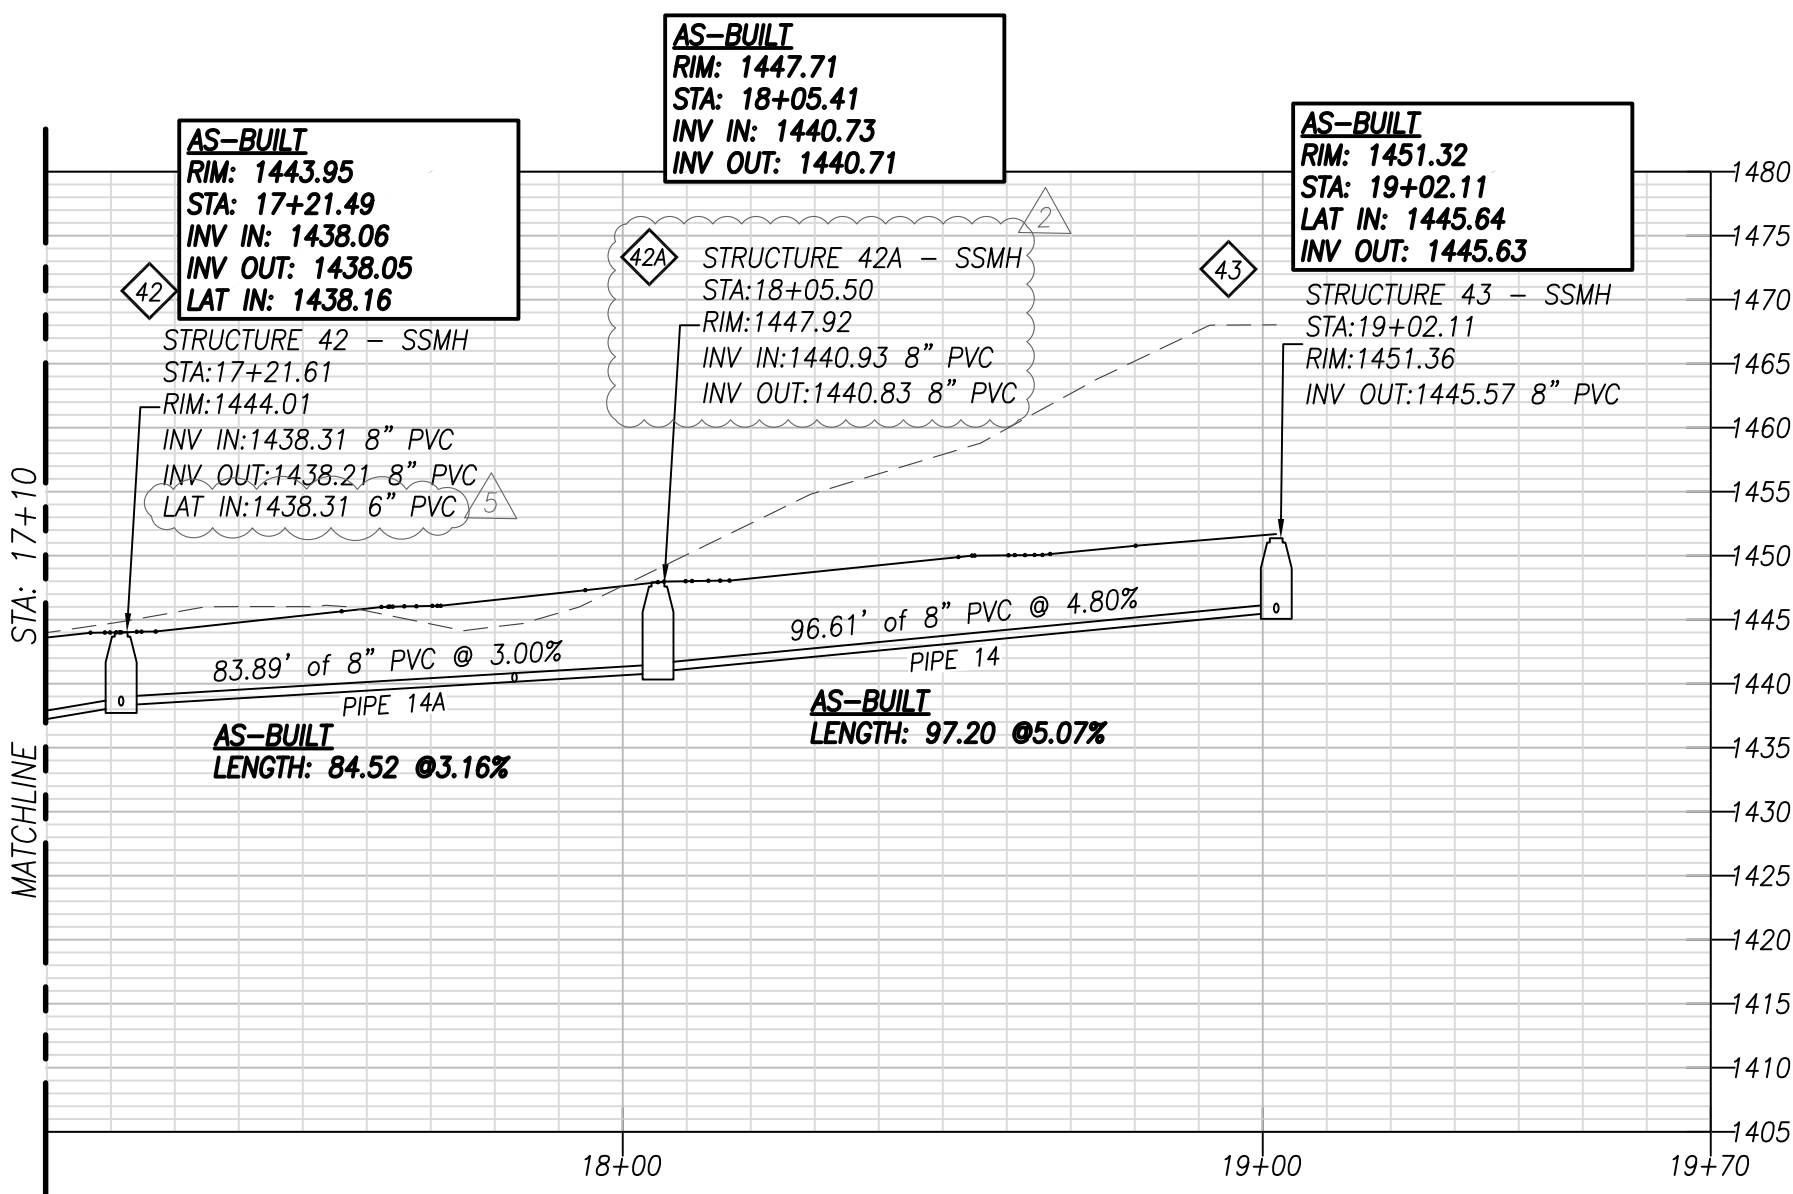

SANITARY SEWER B PROFILE
VERTICAL SCALE: 1" = 15'
HORIZONTAL SCALE: 1" = 30'

Pipe Table						
NAME	SIZE	LENGTH	SLOPE	MATERIAL	MIN. COVER	MAX COVER
Pipe - (14)	8"	96.61'	4.80%	PVC	5'	6'
Pipe - (14A)	8"	83.89'	3.00%	PVC	5'	6'
Pipe - (14B)	8"	101.00'	8.45%	PVC	5'	9'
Pipe - (15)	8"	172.28'	3.36%	PVC	7'	9'
Pipe - (15A)	8"	136.43'	1.01%	PVC	6'	7'
Pipe - (16)	8"	97.87'	1.13%	PVCSDR-26	7'	8'
Pipe - (17)	8"	188.23'	1.26%	PVC	8'	12'
Pipe - (17A)	8"	25.80'	1.01%	PVC	7'	8'
Pipe - (79)	8"	18.74'	20.65%	PVC	0'	0'
Pipe - (80)	8"	25.80'	12.33%	PVC	0'	0'
Pipe - (81)	8"	22.97'	17.16%	PVC	0'	0'
Pipe - (82)	8"	35.69'	15.86%	PVC	0'	0'
Pipe - (83)	8"	19.15'	25.22%	PVC	0'	0'
Pipe - (84)	8"	36.11'	21.74%	PVC	0'	0'
Pipe - (85)	8"	33.54'	21.83%	PVC	0'	0'
Pipe - (86)	8"	32.82'	11.24%	PVC	0'	0'
Pipe - (87)	8"	22.47'	12.64%	PVC	0'	0'
Pipe - (88)	8"	19.00'	10.32%	PVC	0'	0'

STRUCTURE TABLE			
STRUCTURE NAME:	DETAILS:	PIPES IN:	PIPES OUT
Existing - SSMH	STA: 10+00.00 RIM = 1426.70' INV IN = 1418.27'	Pipe - (17A), 8" PVC INV IN =1418.27'	
Structure 37 - SSMH	STA: 10+25.80 RIM = 1426.76' INV IN = 1418.63' INV OUT = 1418.53'	Pipe - (17), 8" PVC INV IN =1418.63'	Pipe - (17A), 8" PVC INV OUT =1418.53'
Structure 38 - SSMH	STA: 12+14.03 RIM = 1429.49' INV IN = 1421.11' INV OUT = 1421.00'	Pipe - (16), 8" PVC INV IN =1421.11'	Pipe - (17), 8" PVC INV OUT =1421.00'
Structure 39 - SSMH	STA: 13+11.90 RIM = 1428.68' INV IN = 1422.32' INV OUT = 1422.22'	Pipe - (15A), 8" PVC INV IN =1422.32'	Pipe - (16), 8" PVC INV OUT =1422.22'
Structure 40 - SSMH	STA: 14+48.33 RIM = 1431.72' INV IN = 1423.80' INV OUT = 1423.70'	Pipe - (15), 8" PVC INV IN =1423.80'	Pipe - (15A), 8" PVC INV OUT =1423.70'
Structure 41 - SSMH	STA: 16+20.61 RIM = 1439.58' INV IN = 1429.68' INV OUT = 1429.59'	Pipe - (14B), 8" PVC INV IN =1429.68'	Pipe - (15), 8" PVC INV OUT =1429.59'
Structure 42 - SSMH	STA: 17+21.61 RIM = 1444.01' INV IN = 1438.31' INV OUT = 1438.21'	Pipe - (14A), 8" PVC INV IN =1438.31'	Pipe - (14B), 8" PVC INV OUT =1438.21'
Structure 42A - SSMH	STA: 18+05.50 RIM = 1447.92' INV IN = 1440.93' INV OUT = 1440.83'	Pipe - (14), 8" PVC INV IN =1440.93'	Pipe - (14A), 8" PVC INV OUT =1440.83'
Structure 43 - SSMH	STA: 19+02.11 RIM = 1451.36' INV IN = 1445.57'		Pipe - (14), 8" PVC INV OUT =1445.57'

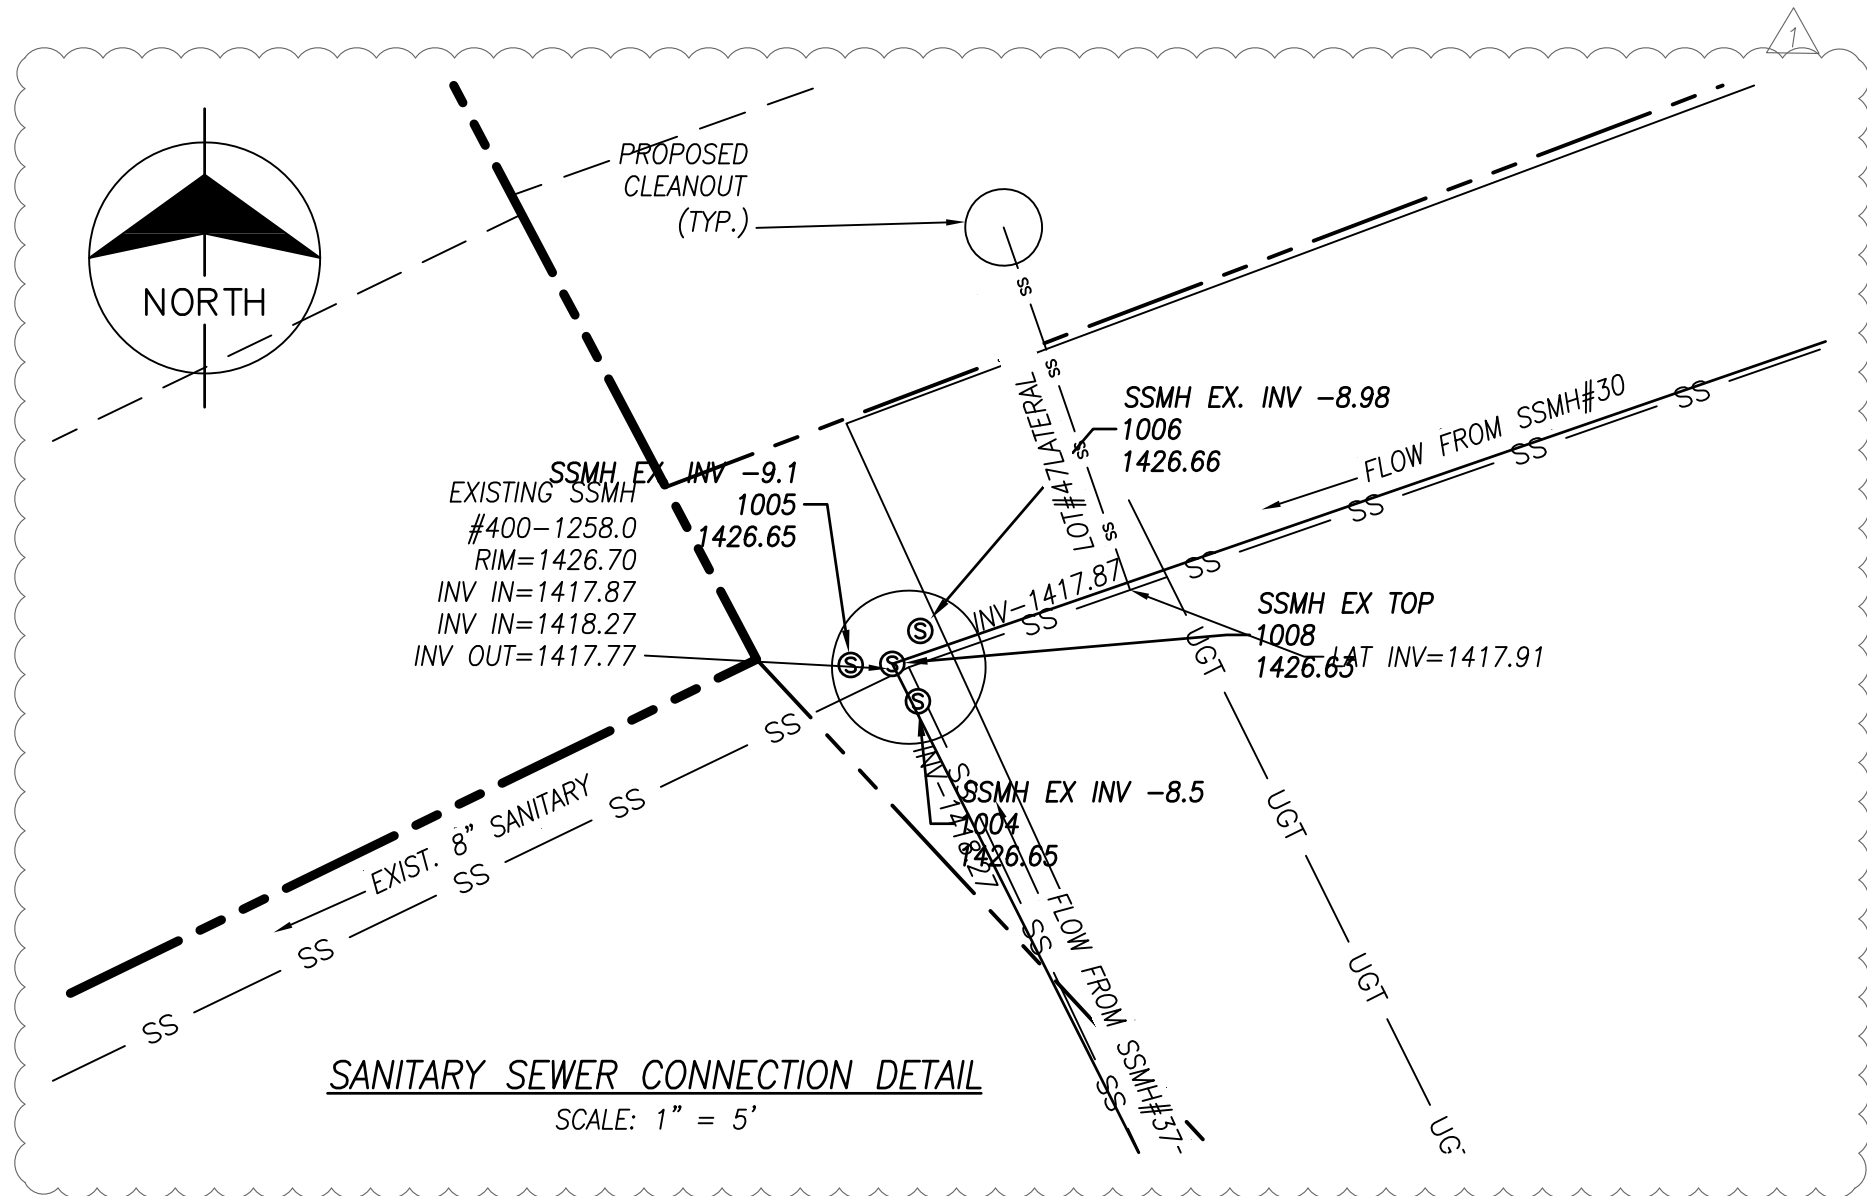


AS-BUILT



No.	Description	1ST REVIEW	2ND REVIEW	FIELD REVISIONS	Date
1					01/20/21
2					05/04/21
5					09/30/21

PRESERVE AT ASHLEY
BOTETOURT COUNTY

FRONT LOTS DEVELOPMENT
SANITARY SEWER PROFILES

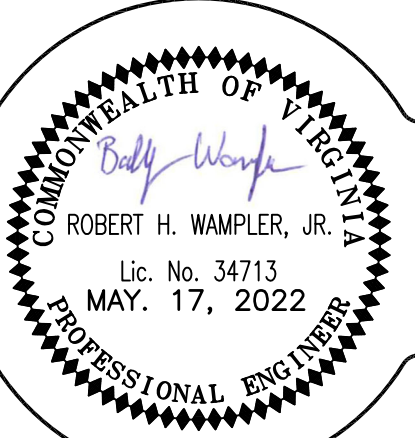

0 30 60
GRAPHIC SCALE
PROJECT: 20004
C11