


↙

- NATIONAL 6" x 4" C900 DR 14 PVC
- AMERICAN FLOW CONTROL 6" x 4" GATE VALVES
- ENDOT 1" PE 4710 HDPE

* WATER BAG. T	SAMPLES "	TAKEN FROM TEMP. END OF LINE BLOW-OFF "
11-07-16 1000	C ₂ : 0.65	" FAILED "
11-08-16 1115	C ₂ : 0.71	" PASSED "
11-09-16 1115	C ₂ : 0.66	" PASSED "


* TRACER WIRE CONTINUITY TEST 12-02-16

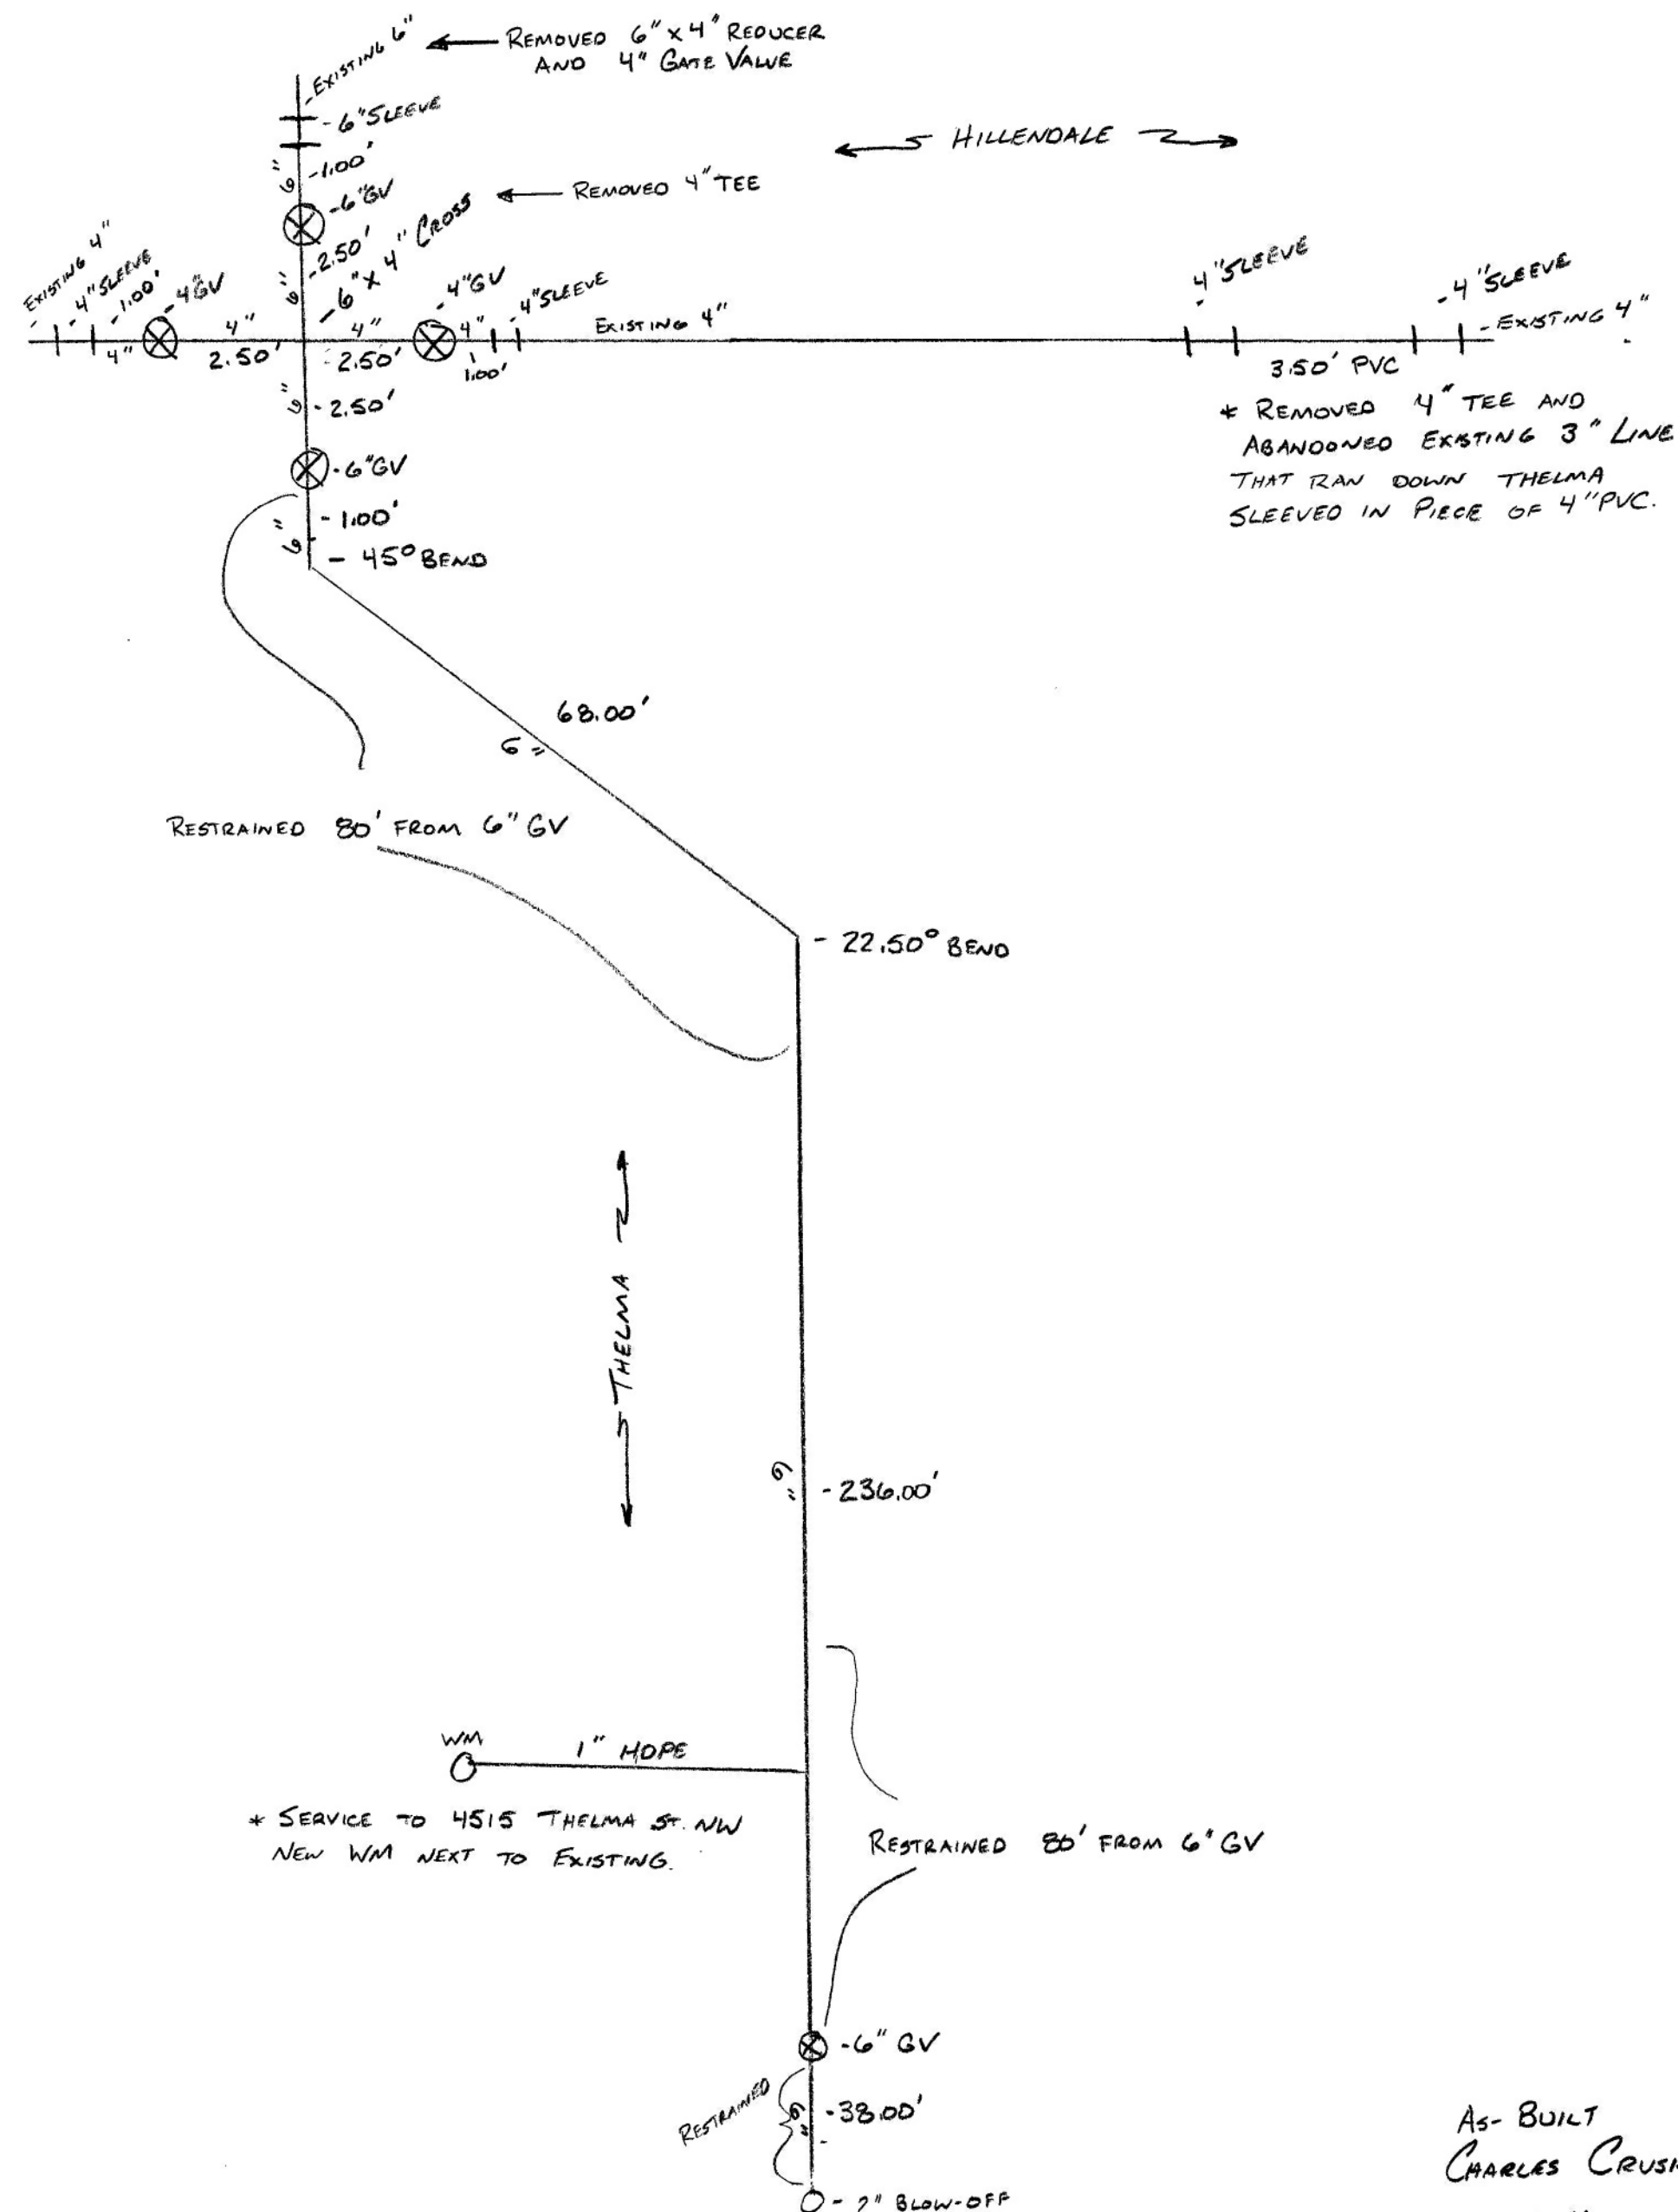

AS-BUILT
CHARLES CRUSH
12-06-16

* WORK DONE BY JACK ST. CLAIR, INC. AS PART OF THE ANNUAL CONTRACT THELMA ST. WATER REPLACEMENT. SECTION OF EXISTING LINE HAD LESS THAN 2.00' OF COVER, DISCOVERED BY CONTRACTOR DOING THE OLEVA AND THELMA ST. IMPROVEMENTS "ROANOKE CITY" PROJECT.

- NATIONAL 4" C900 DR14 PVC
- ENDOT 1" PE 4710 HDPE

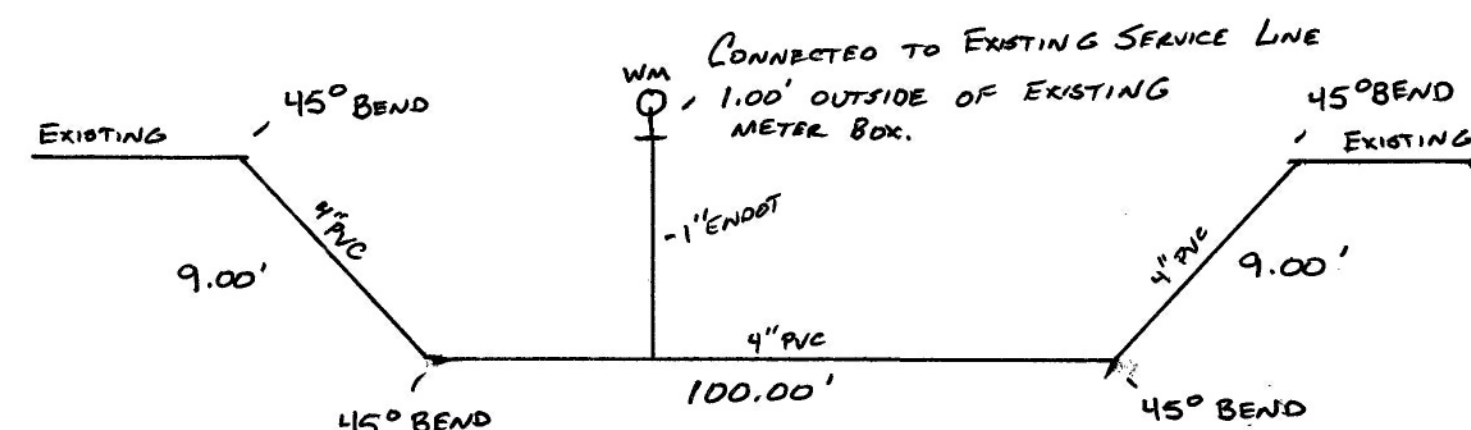

CHARLES CRUSH
AS-BUILT
12-07-16