

NOTE: SEE SHEET 2A FOR NOTES & DETAILS.

CONST. CL
Δ = 38°37'43"
D = 10°00'00"
R = 572.96'
T = 200.81'
L = 386.29'
P.I. = 96+22.24
LS = 200'
E = 0.0400
V = 40 M.P.H.

Sheet 8B

[92+60.69, LT 15']
FIRE HYDRANT
[92+51.48, LT 15']
12" GATE VALVE
[92+68.61, LT 15']
12" TEE & CAP

TRACT #2
MATILDA H. BRADSHAW
TRUSTEE ET ALS &
MARGARET J. MORRIS
ET ALS
M.B. 1, PG. 879

NOTE: WATERLINE IS BASELINE
10+00 LOCATED 10' LT.
OF PROPERTY LINE.

TAX #6530102
PROPERTY OF
W. & S. CORPORATION
D.B. 1588, PG. 761


RECORD DRAWINGS

THESE DRAWINGS RECORDED ON THE BASIS OF
INFORMATION FURNISHED BY THE CONTRACTOR.
NO REPRESENTATIONS ARE MADE OR IMPLIED
DATE: NOV. 22, 1990

NOTE: CONTRACTOR TO
REPAIR FENCE TO
PRE-CONSTRUCTION
CONDITION.

SCALE
0 50' 100'

LEGEND	
DESCRIPTION	SYMBOL
PROP. WATER	— W —
EXIST. WATER	- - W - -
FIRE HYD.	⊕
GATE VALVE	⊙
AIR RELEASE VALVE ASSEMBLY	○
BLOW-OFF ASSEMBLY	⊠
PROPOSED SAN. SEWER	— SS —
EXIST. SAN. SEWER	- - SS - -
EXIST. MANHOLE	⊙
PROP. MANHOLE	●

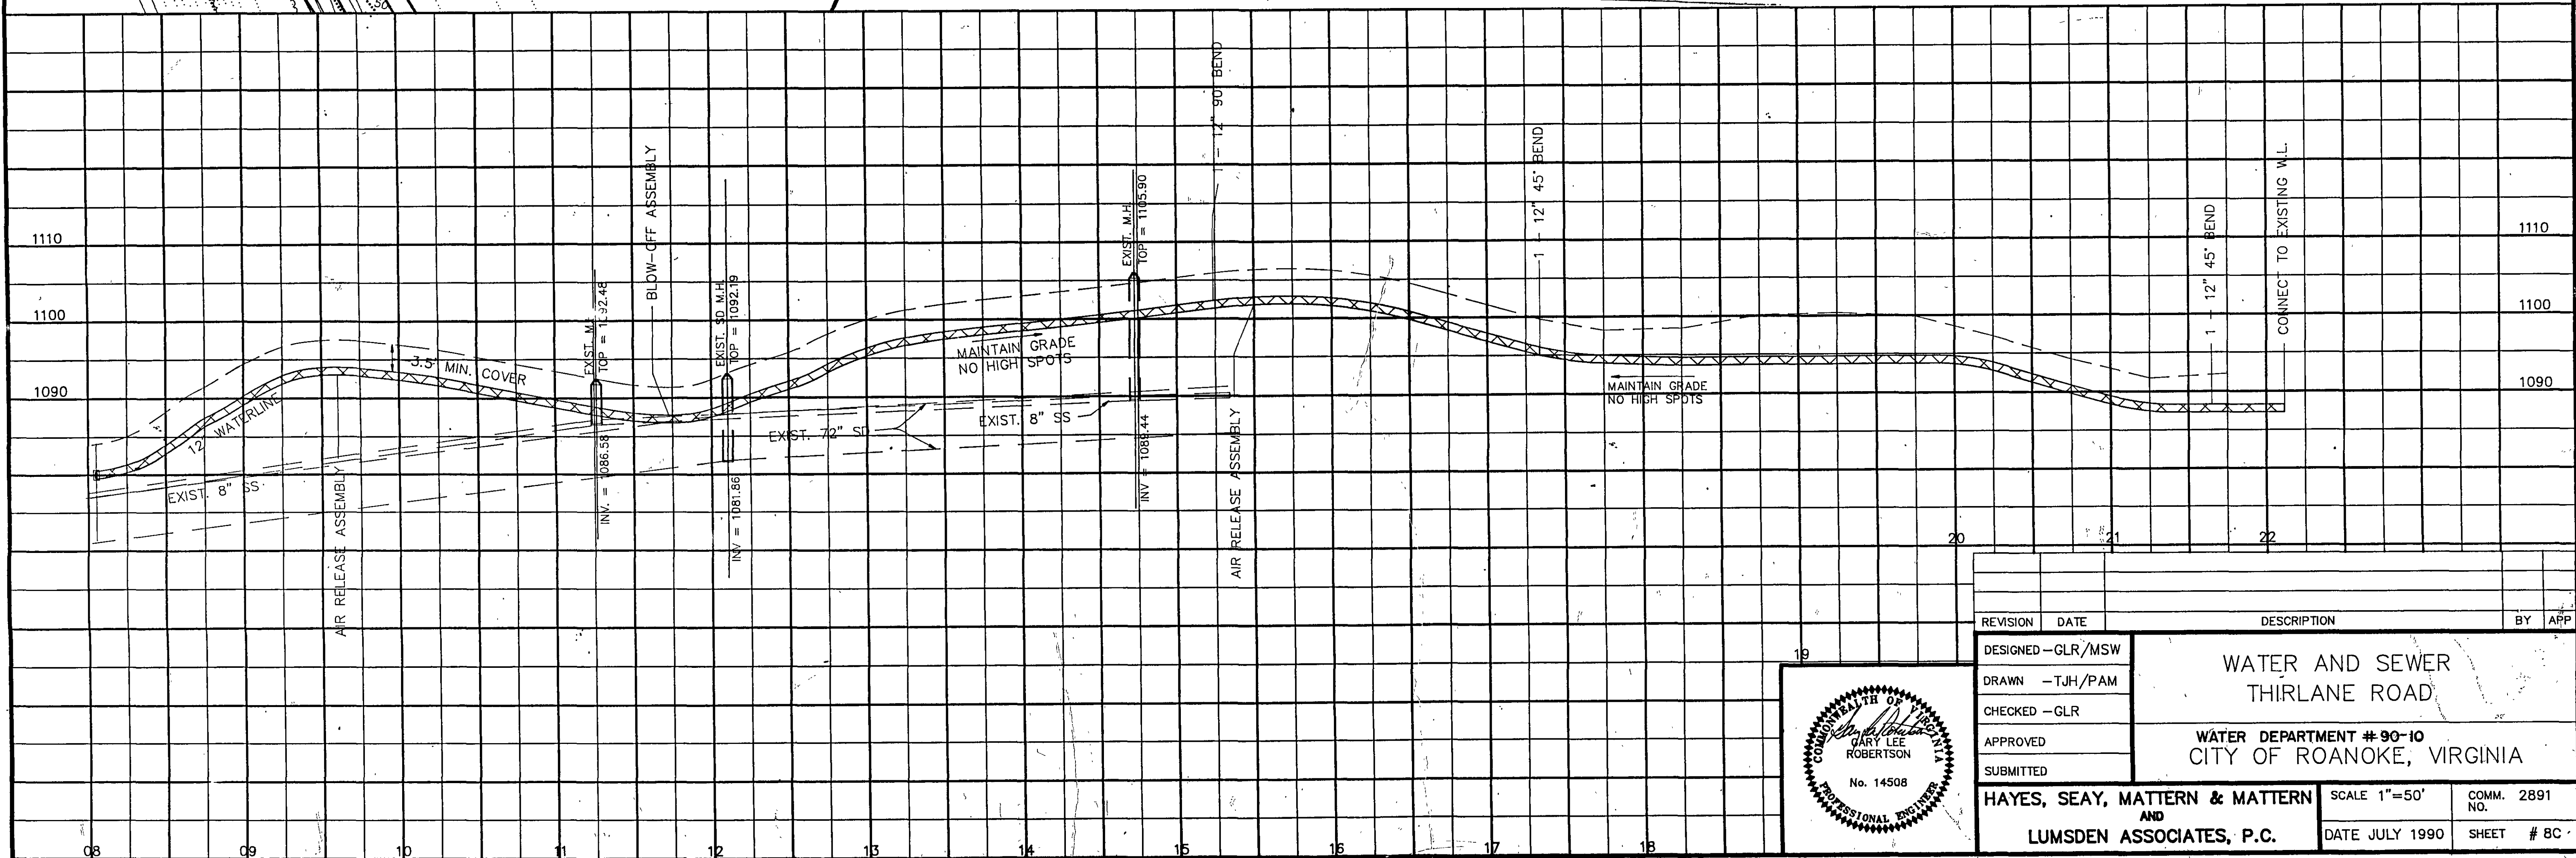

REVISION	DATE	DESCRIPTION	BY	APP
DESIGNED - GLR/MSW				
DRAWN - TJH/PAM				
CHECKED - GLR				
APPROVED				
SUBMITTED				
WATER AND SEWER THIRLANE ROAD				
WATER DEPARTMENT #90-10 CITY OF ROANOKE, VIRGINIA				
HAYES, SEAY, MATTERN & MATTERN AND LUMSDEN ASSOCIATES, P.C.			SCALE 1"=50'	COMM. 2891 NO.
			DATE JULY 1990	SHEET # 8C

