



WESTERN VIRGINIA WATER AUTHORITY NORTH LOOP WATER MAIN EXTENSION THOMPSON MEMORIAL DRIVE TO KESSLER MILL ROAD

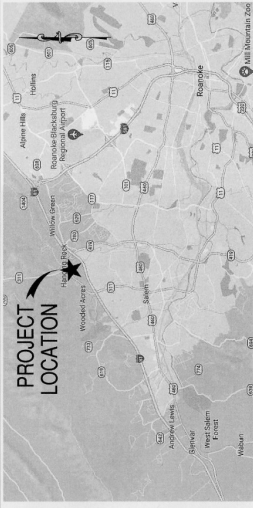

LOCATION MAP
NO SCALE

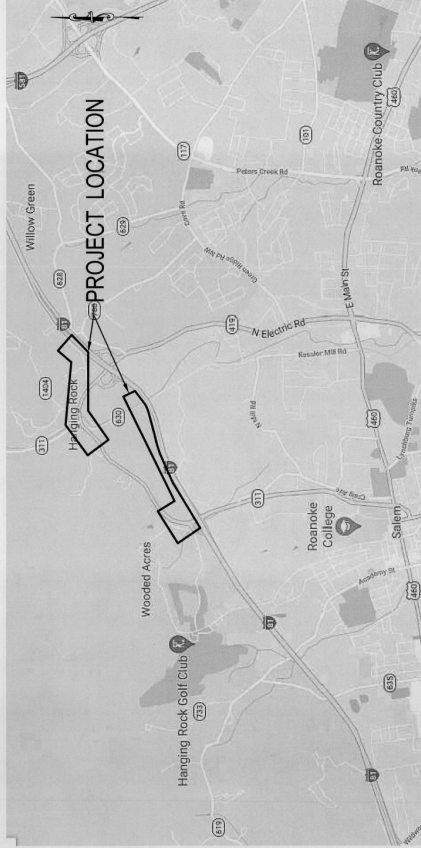

VICINITY MAP
NO SCALE

JUNE 2022

WVA Inspector As-Built
Charles Crish
12-26-2023

SHEET NUMBER

1	COVER
2	GENERAL NOTES & PROPOSED LEGEND
3	SURVEY SCHEDULES, NOTES, & EXISTING LEGEND
4	STANDARD DETAILS
5	STANDARD DETAILS
6	EROSION & SEDIMENT CONTROL NOTES
7	EROSION & SEDIMENT CONTROL DETAILS
8	SHEET LAYOUT & FIRE HYDRANT COVERAGE MAP
9	24" WATER MAIN PLAN - PROFILE, STA. 10+00 TO STA. 15+00
10	24" WATER MAIN PLAN - PROFILE, STA. 15+00 TO STA. 20+00
11	24" WATER MAIN PLAN - PROFILE, STA. 20+00 TO STA. 25+00
12	24" WATER MAIN PLAN - PROFILE, STA. 25+00 TO STA. 30+00
13	24" WATER MAIN PLAN - PROFILE, STA. 30+00 TO STA. 35+00
14	24" WATER MAIN PLAN - PROFILE, STA. 35+00 TO STA. 40+00
15	24" WATER MAIN PLAN - PROFILE, STA. 40+00 TO STA. 45+00
16	24" WATER MAIN PLAN - PROFILE, STA. 45+00 TO STA. 49+47
17	24" WATER MAIN PLAN - PROFILE, STA. 50+00 TO STA. 55+00
18	24" WATER MAIN PLAN - PROFILE, STA. 55+00 TO STA. 60+00
19	24" WATER MAIN PLAN - PROFILE, STA. 60+00 TO STA. 65+00
20	24" WATER MAIN PLAN - PROFILE, STA. 65+00 TO STA. 70+00
21	24" WATER MAIN PLAN - PROFILE, STA. 70+00 TO STA. 75+00
22	24" WATER MAIN PLAN - PROFILE, STA. 75+00 TO STA. 80+00
23	24" WATER MAIN PLAN - PROFILE, STA. 80+00 TO STA. 85+00
24	24" WATER MAIN PLAN - PROFILE, STA. 85+00 TO STA. 90+00
25	24" WATER MAIN PLAN - PROFILE, STA. 90+00 TO STA. 95+00
26	24" WATER MAIN PLAN - PROFILE, STA. 95+00 TO STA. 100+00
27	24" WATER MAIN PLAN - PROFILE, STA. 100+00 TO STA. 105+00
28	24" WATER MAIN PLAN - PROFILE, STA. 105+00 TO STA. 110+00
29	24" WATER MAIN PLAN - PROFILE, STA. 110+00 TO STA. 113+50
30	TEMPORARY TRAFFIC CONTROL PLAN NOTES
31	TEMPORARY TRAFFIC CONTROL PLAN NOTES
32	TEMPORARY TRAFFIC CONTROL PLAN FIGURE 1
33	TEMPORARY TRAFFIC CONTROL PLAN FIGURE 2
34	TEMPORARY TRAFFIC CONTROL PLAN FIGURE 3
35	TEMPORARY TRAFFIC CONTROL PLAN FIGURE 4



Western Virginia Water Authority
601 South Jefferson Street, Suite 300
Roanoke, Virginia 24011



Whittman, Requardt & Associates, LLP
Professional Engineer
License No. 60802
State of Virginia

WESTERN VIRGINIA WATER AUTHORITY
601 South Jefferson Street, Suite 300
Roanoke, Virginia 24011

NORTH LOOP WATER MAIN EXTENSION
THOMPSON MEMORIAL DRIVE TO KESSLER MILL ROAD

COVER

DRAWING
C1.01

DESCRIPTION

SHEET

1