


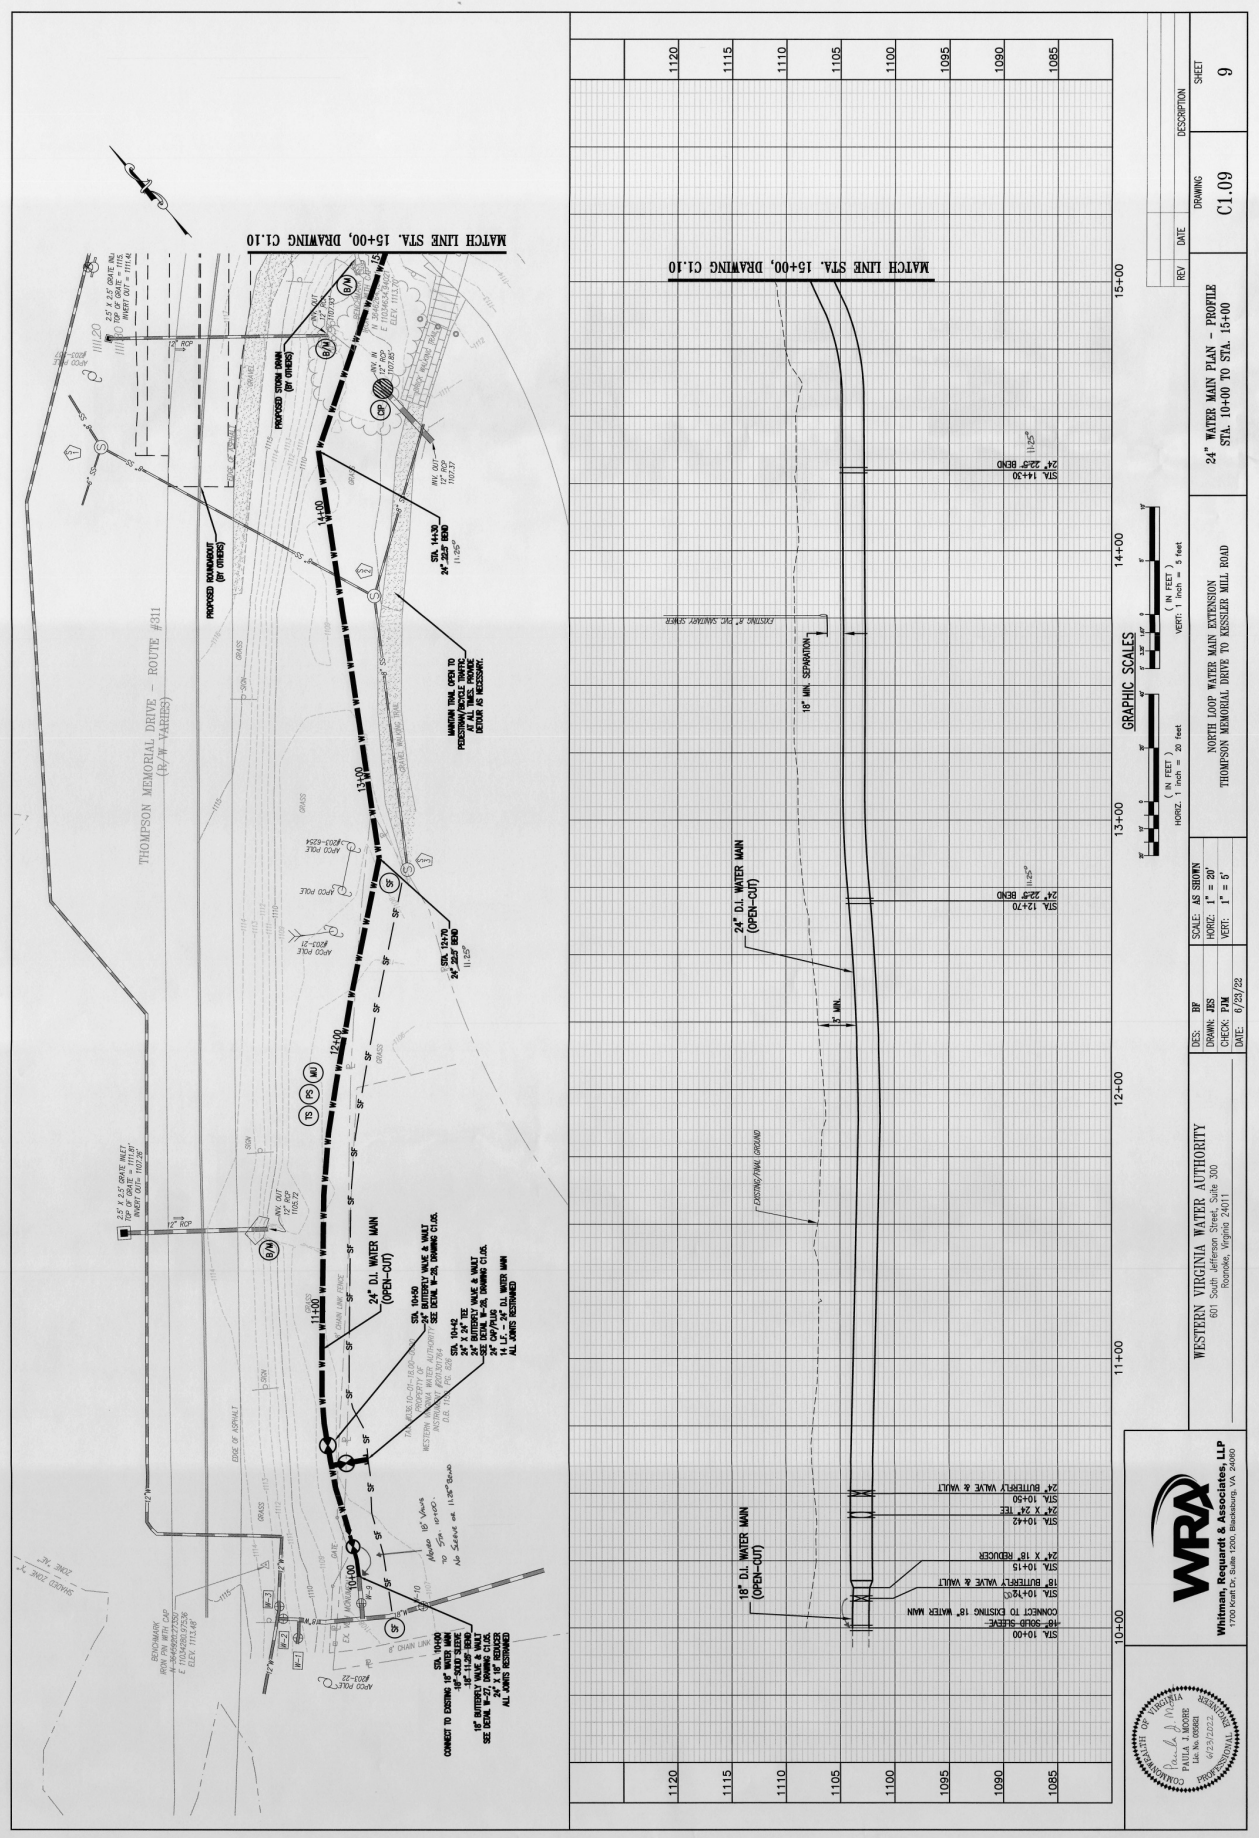


REV	DATE	DESCRIPTION	SHEET
C1.09		24" WATER MAIN PLAN - PROFILE STA. 10+00 TO STA. 15+00	9

DES: JIS	SCALE: AS SHOWN	WESTERN VIRGINIA WATER AUTHORITY 801 South Jefferson Street, Suite 300 Roanoke, Virginia 24011
DRAWN: JIS	HORIZ. 1" = 20'	
CHECK: JIS	VERT. 1" = 5'	
DATE: 07/20/22		

PROJECT INFORMATION	
PROJECT: 24" WATER MAIN EXTENSION	
LOCATION: THOMPSON MEMORIAL DRIVE TO KESSLER MILL ROAD	
DATE: 07/20/22	



WRPA
Western Piedmont Regional Authority
1700 West Dr. Suite 1200, Blacksburg, VA 24060

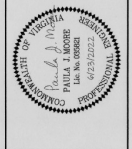

PAUL J. MOORE
07/20/2022
07/20/2022
07/20/2022