



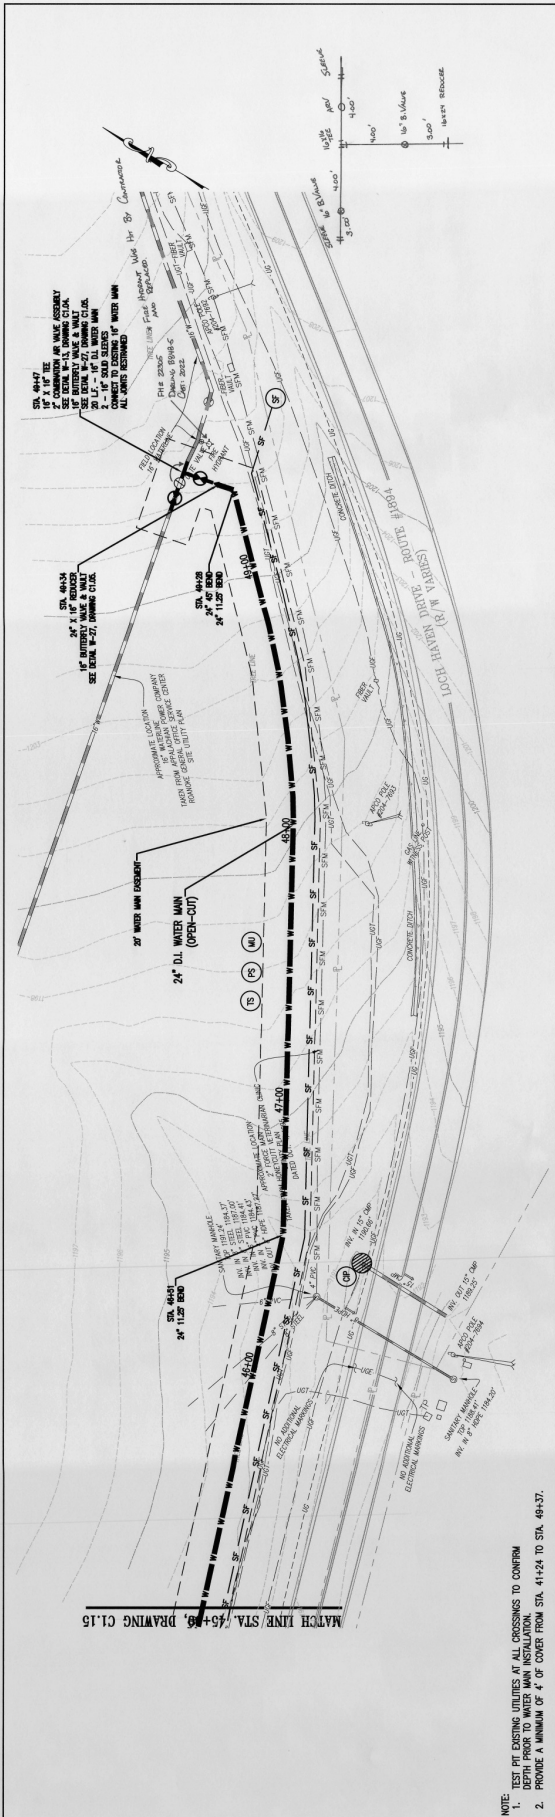

NOTE:
 1. TEST ALL EXISTING UTILITIES AT ALL CROSSINGS TO CONFIRM DEPTH PRIOR TO WATER MAIN INSTALLATION.
 2. PROVIDE A MINIMUM OF 4' OF COVER FROM STA. 41+24 TO STA. 49+37.

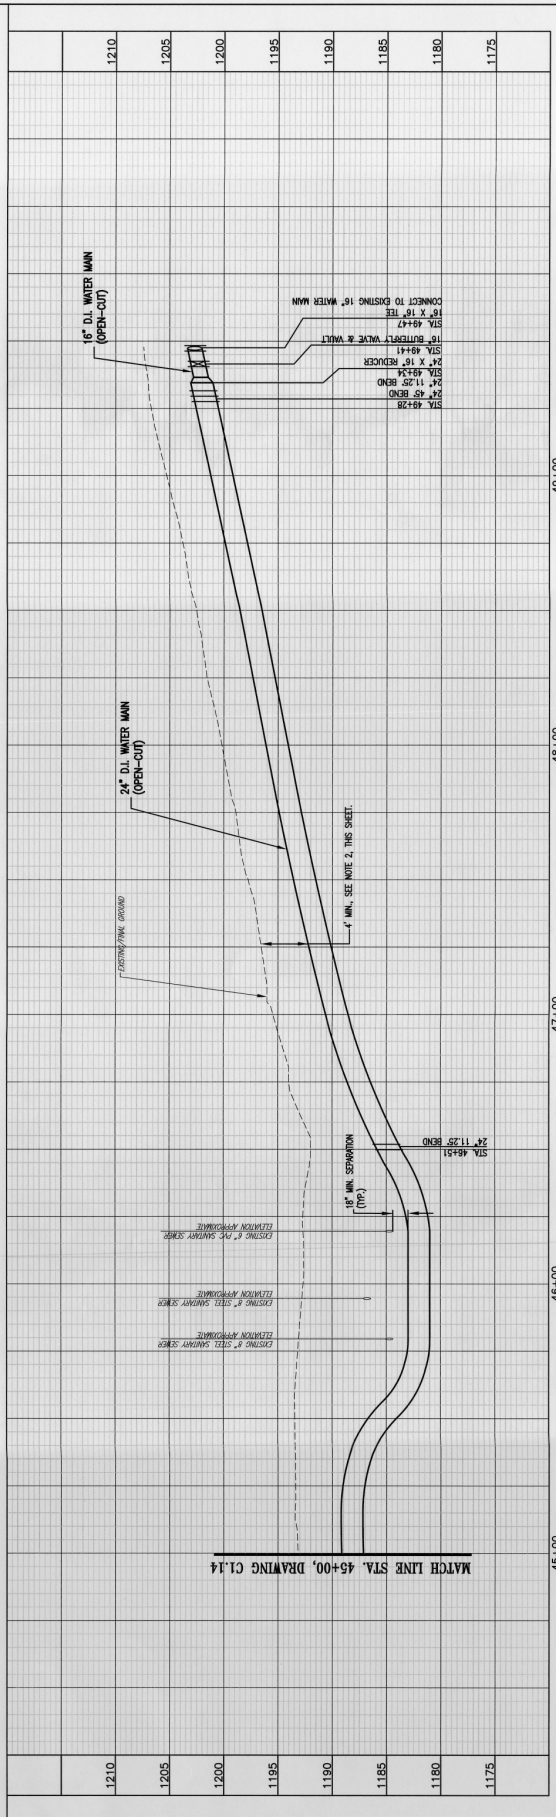

GRAPHIC SCALES

HORIZ. 1" = 20' (IN FEET)

VERT. 1" = 5' (IN FEET)

REV.	DATE	DESCRIPTION	SHEET
			16

WESTERN VIRGINIA WATER AUTHORITY
 601 State Street, Suite 300
 Roanoke, Virginia 24011

24" WATER MAIN PLAN - PROFILE
 STA. 45+00 TO STA. 49+37

WRA
 Whitman, Reardon & Associates, LLP
 1700 Kraft Dr., Suite 1200, Blacksburg, VA 26060

DATE: 6/23/22
CHECK: PAM
DATE: 6/23/22