


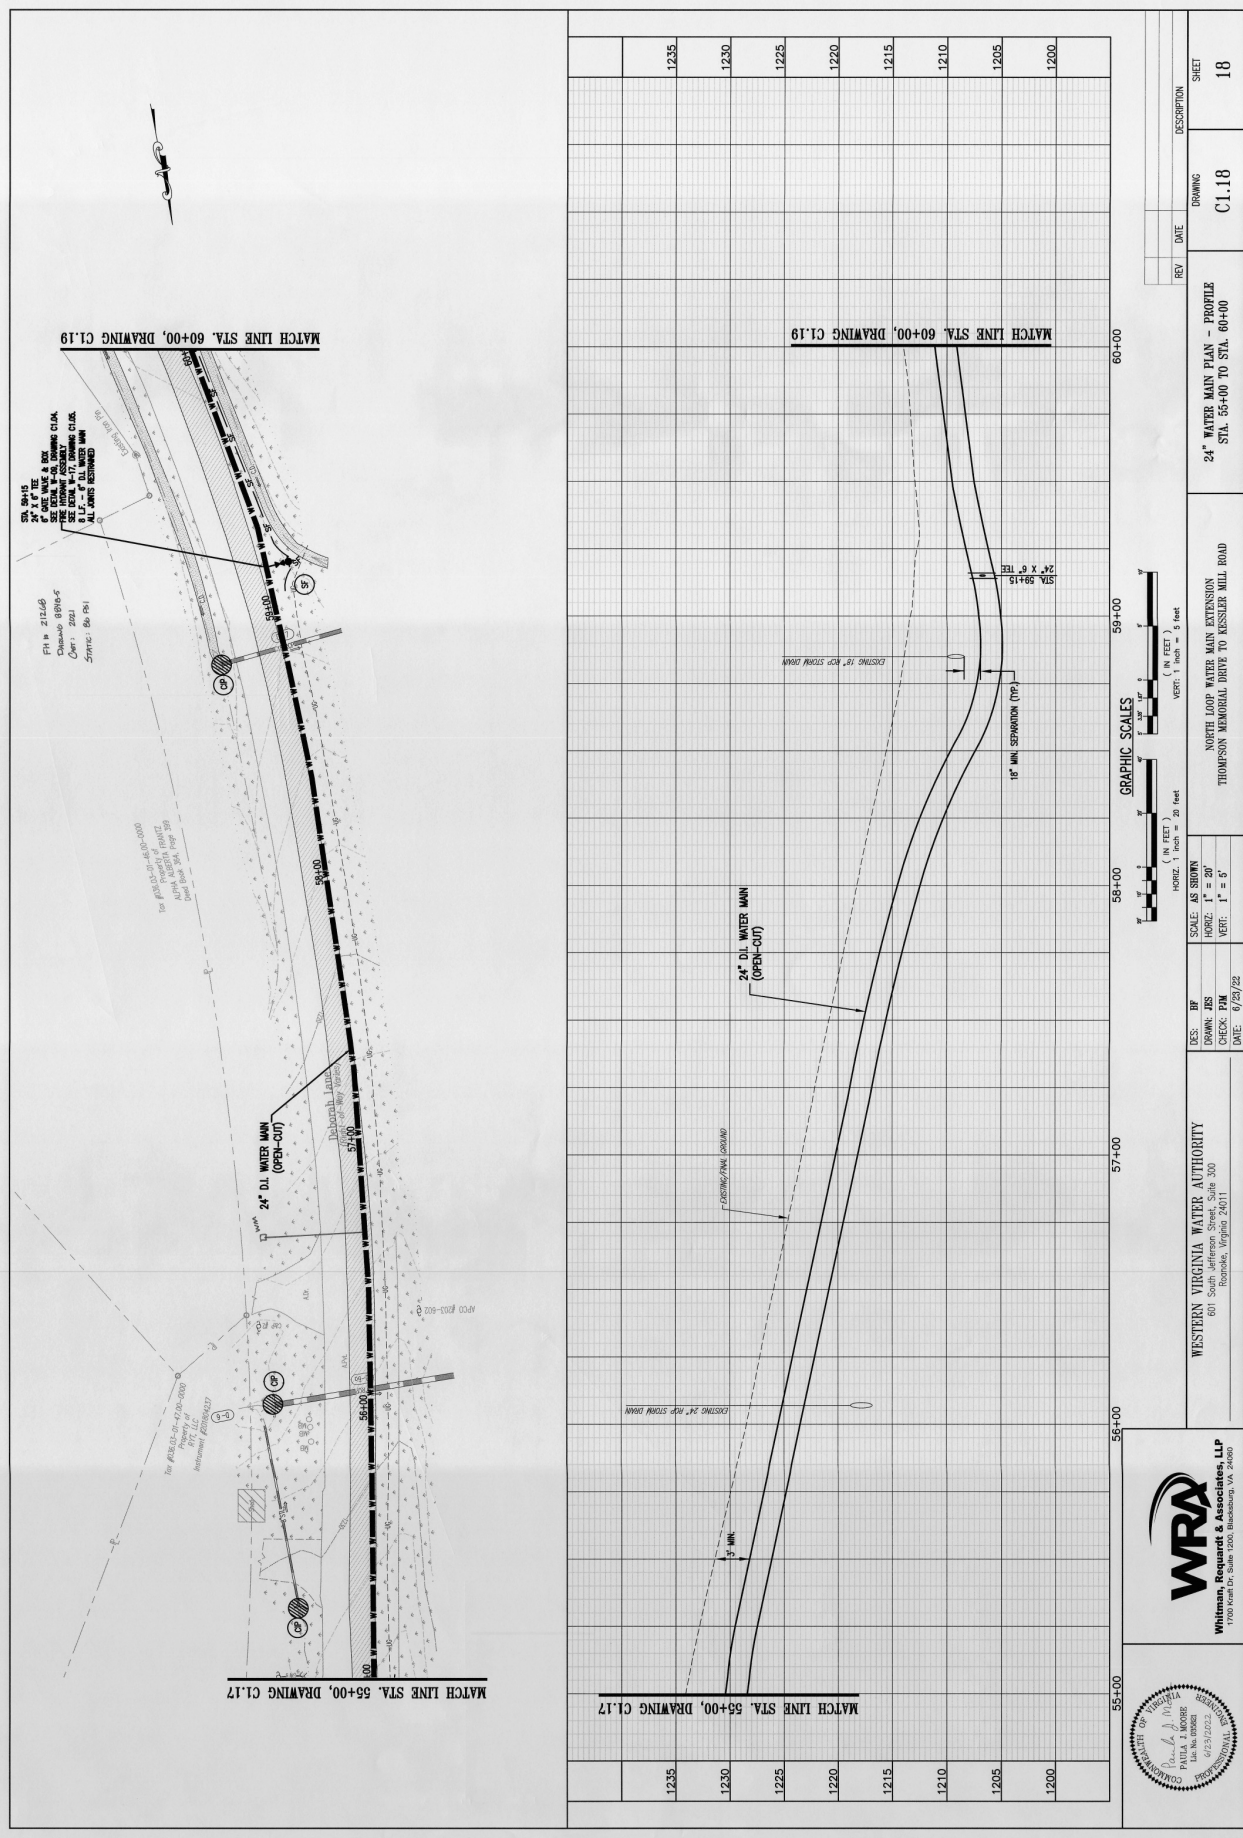

WESTERN VIRGINIA WATER AUTHORITY
601 South Jefferson Street, Suite 300
Roanoke, Virginia 24011

DES: JF
DRAWN: JMS
CHECK: JMS
DATE: 4/23/22

SCALE: AS SHOWN
HORIZ: 1" = 20'
VERT: 1" = 5'



NORTH LOOP WATER MAIN EXTENSION
THOMPSON MEMORIAL DRIVE TO KESSLER MILL ROAD

24" WATER MAIN PLAN - PROFILE
STA. 55+00 TO STA. 60+00

DRAWING
C1.18

SHEET
18