
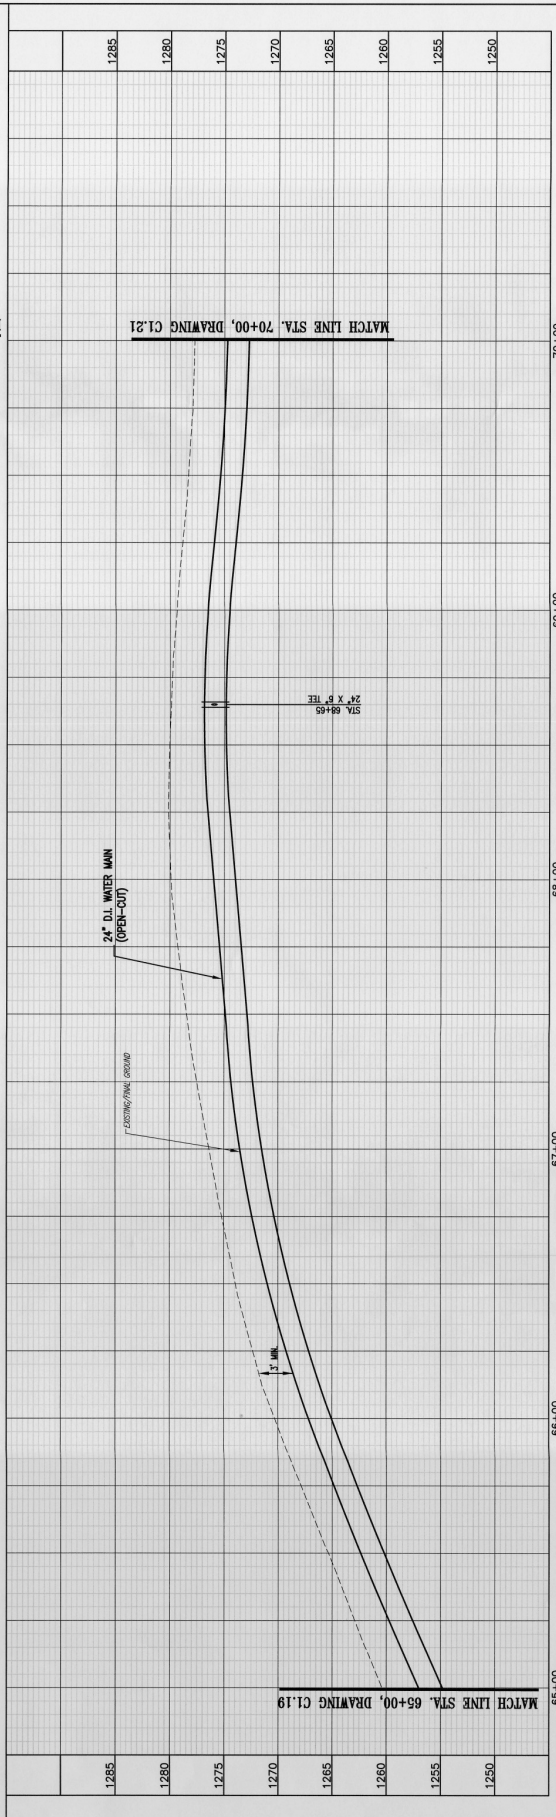


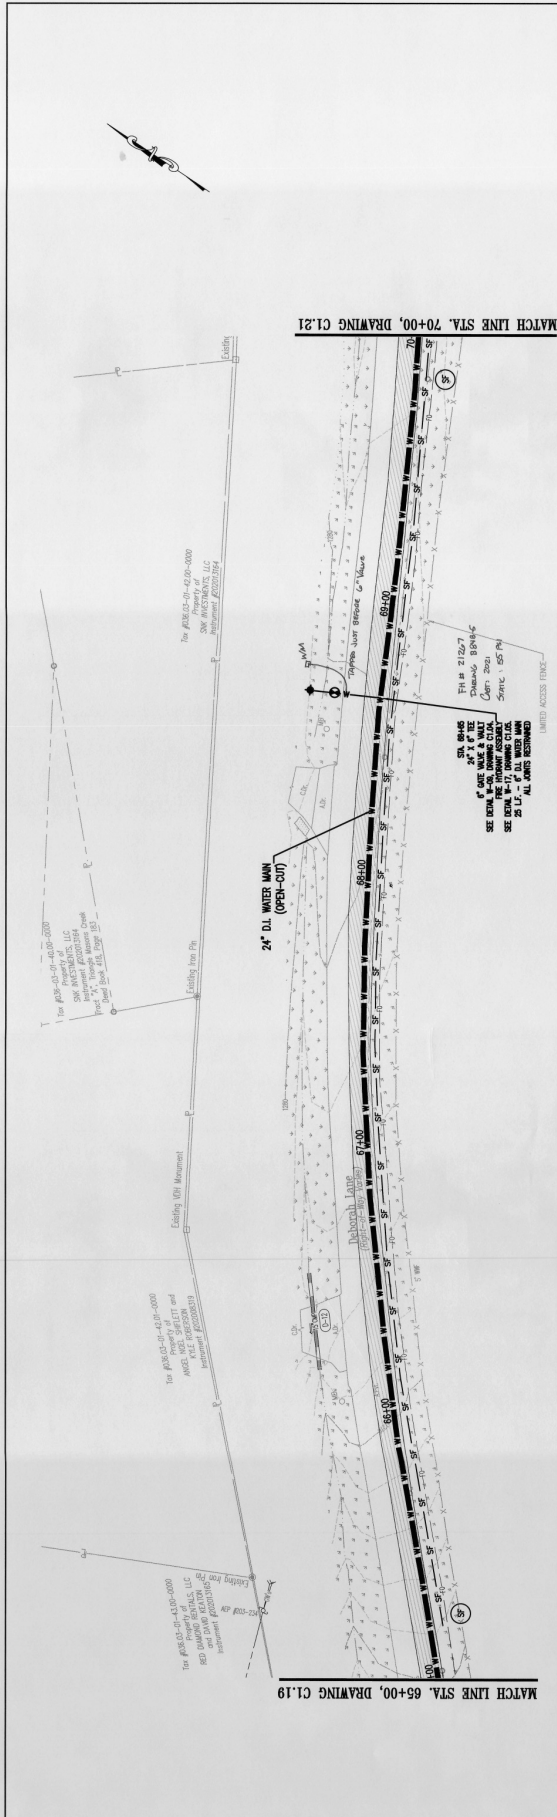

GRAPHIC SCALES

(IN FEET)

(IN FEET)

REV	DATE	DESCRIPTION

WESTERN VIRGINIA WATER AUTHORITY
 601 South Jefferson Street, Suite 300
 Roanoke, Virginia 24011

24" WATER MAIN PLAN - PROFILE
 STA. 65+00 TO STA. 70+00

DES. BY JES
DRAWN BY JES
CHECK BY JES
DATE 6/25/22

SCALE: AS SHOWN
HORIZ. 1" = 20'
VERT. 1" = 5'

WRA
Whitman Research & Associates, LLP
 1728 North Dr. Suite 200, Blacksburg, VA 26040

SHEET 20