
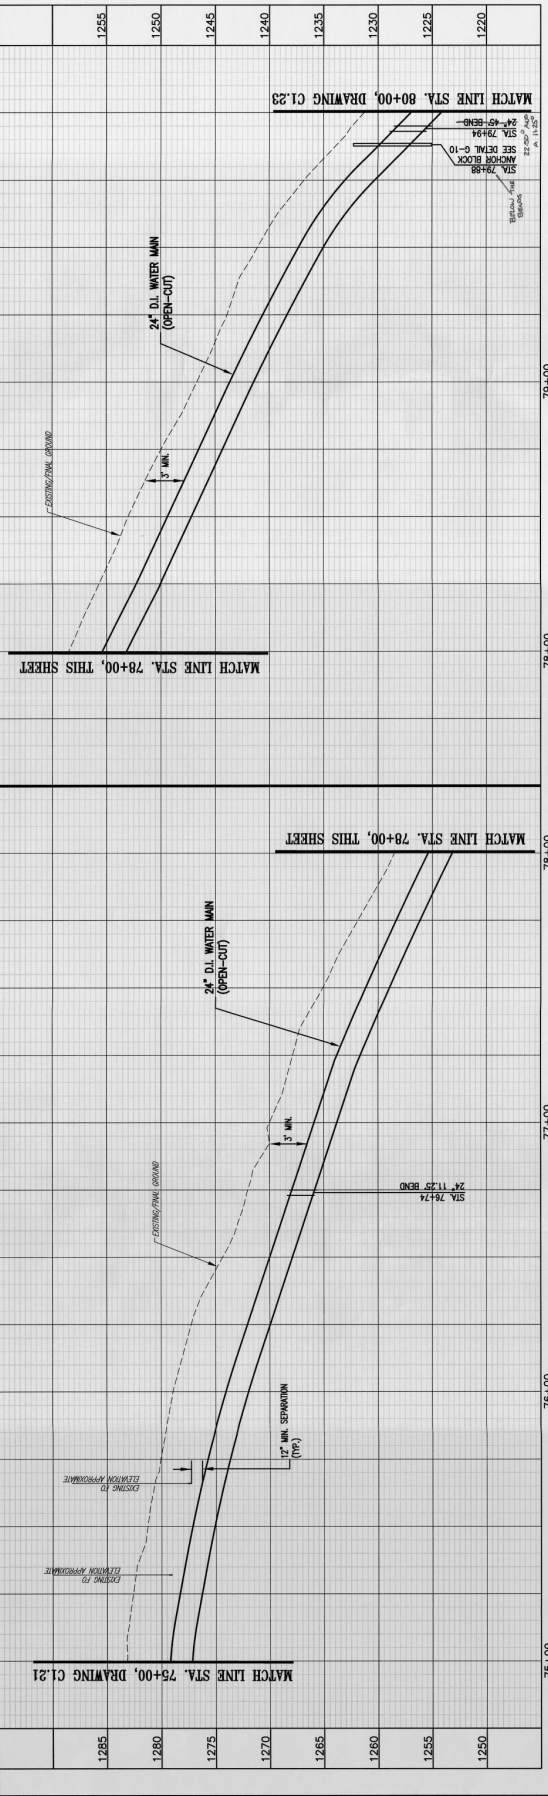


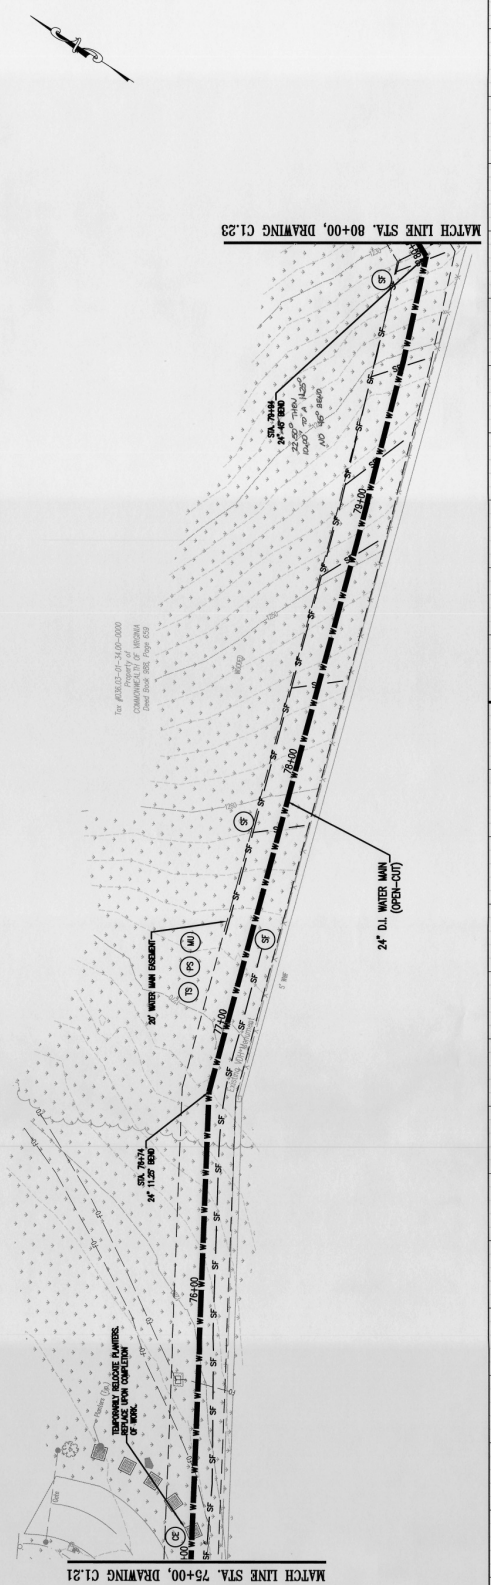

GRAPHIC SCALES

Horizontal Scale: 1 inch = 20 feet

Vertical Scale: 1 inch = 5 feet

WESTERN VIRGINIA WATER AUTHORITY
 601 South Jefferson Street, Suite 300
 Roanoke, Virginia 24011

DESIGN INFORMATION

DES: JPS
 DRAWN: JPS
 CHECK: PJM
 DATE: 6/23/22

24" WATER MAIN PLAN - PROFILE
 STA. 75+00 TO STA. 80+00

DRIVING
 C1.22

REVISIONS

REV	DATE	DESCRIPTION

SHEET
 22

William Research & Associates, LLP
 1700 North Dr. Suite 1000, Roanoke, VA 24012

Professional Engineer Seal

PAUL A. MOORE
 License No. 000026
 State of Virginia
 Expiration Date: 6/23/2023