

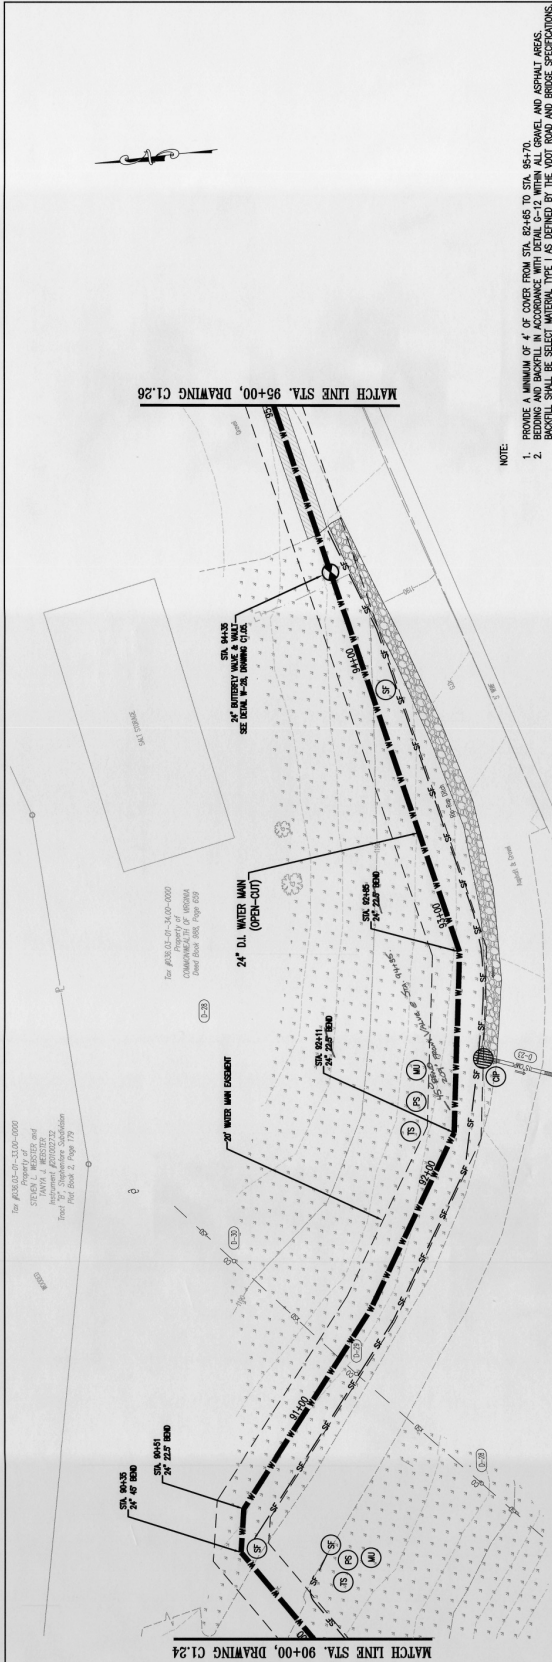 
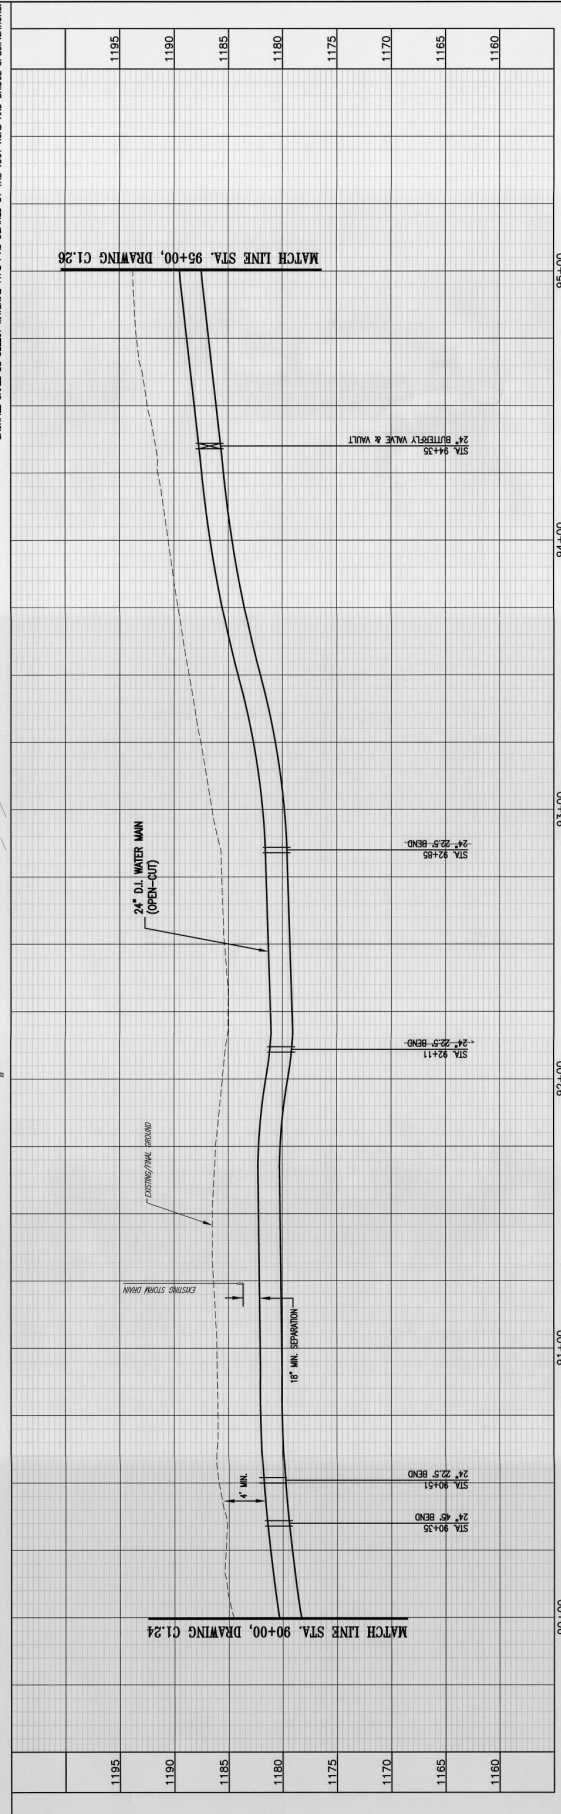 
 
 


THE PROJECT IS THE PROPERTY OF
WESTERN VIRGINIA WATER AUTHORITY
STATIONED 90+00 TO 95+00
DRAWN BY: JES
CHECKED BY: JES
DATE: 07/25/22
PROJECT NO. 2022-0000
SHEET NO. 1 OF 1



- NOTE:
1. PROVIDE A MINIMUM OF 4" OF COVER FROM STA. 90+00 TO STA. 95+00.
 2. BEDDING AND BACKFILL IN ACCORDANCE WITH SECTION C-12 WITHIN ALL GRAVEL AND ASPHALT AREAS.
 3. BACKFILL SHALL BE SELECT MATERIAL TYPE 1 AS DEFINED BY THE ROAD AND BRIDGE SPECIFICATIONS.



 Whitman, Requardt & Associates, LLP 1700 Kent Dr. Suite 1200, Blacksburg, VA 24060			
WESTERN VIRGINIA WATER AUTHORITY 601 South Jefferson Street, Suite 300 Roanoke, Virginia 24011		DES: JES DRAWN: JES CHECK: JES DATE: 6/22/22	
SCALE: AS SHOWN HORIZ: 1" = 20' VERT: 1" = 5'		GRAPHIC SCALES  	
24" WATER MAIN PLAN - PROFILE STA. 90+00 TO STA. 95+00		DRAWING: C1.25 SHEET: 25	
24" WATER MAIN EXTENSION THOMPSON MEMORIAL DRIVE TO KESSLER MILL ROAD		REV: DATE: DESCRIPTION:	