
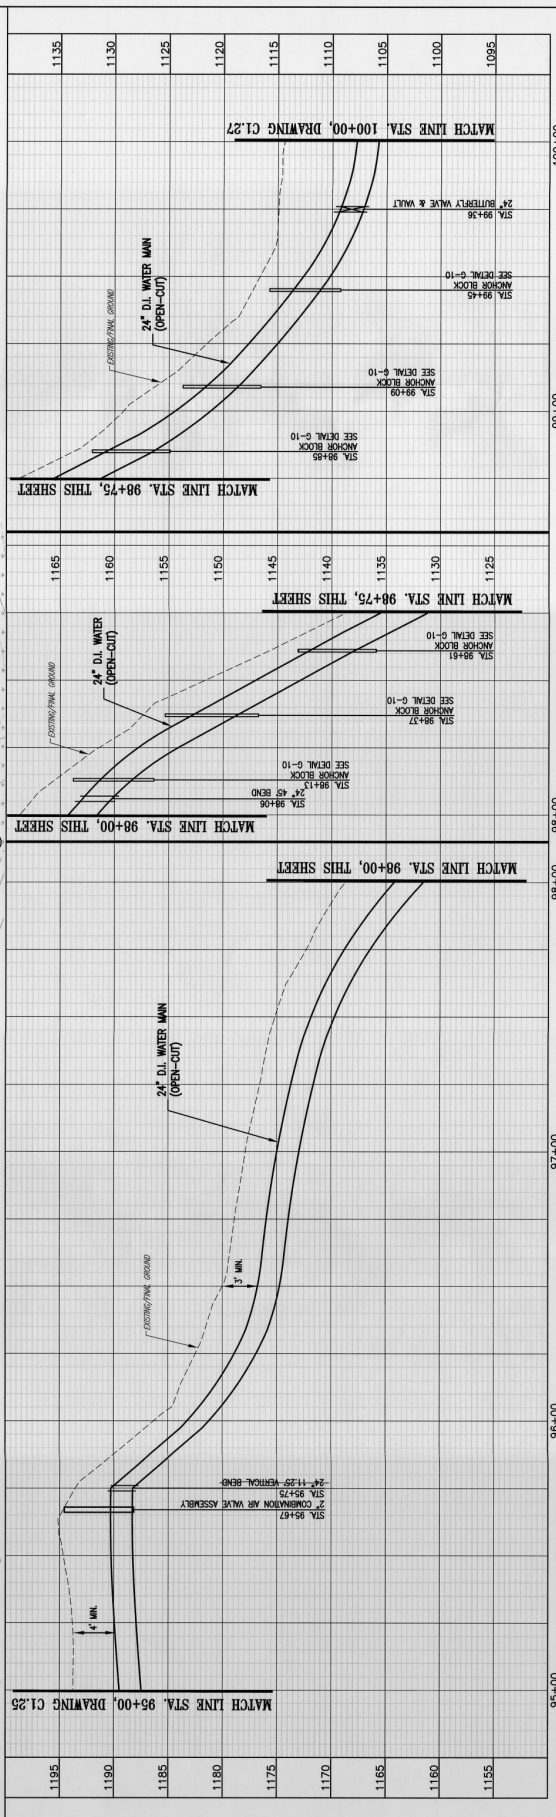


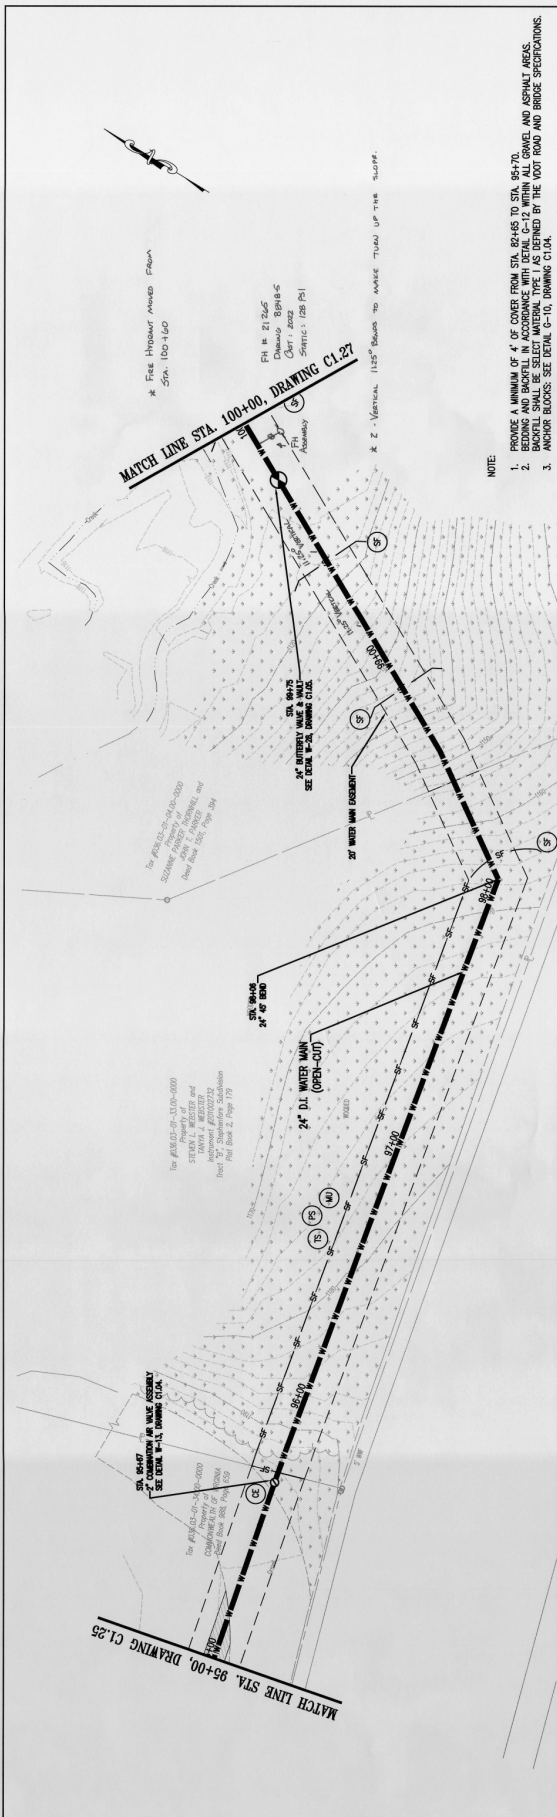

NOTE

1. PROVIDE A MINIMUM OF 4" OF COVER FROM STA. 92+45 TO STA. 95+70.
2. BACKFILL SHALL BE SELECT MATERIAL TYPE I AS DEFINED BY THE ROAD AND BRIDGE SPECIFICATIONS.
3. ANCHOR BLOCKS: SEE DETAIL G-10, DRAWING C1.04.

WESTERN VIRGINIA WATER AUTHORITY
601 South Jefferson Street, Suite 300
Roanoke, Virginia 24011

Whitman, Requardt & Associates, LLP
1700 Kent Dr. Suite 1000, Blacksburg, VA 24060

DES: JES
DRAWN: JES
CHECK: PDM
DATE: 6/23/22

SCALE: AS SHOWN
HORIZ: 1" = 20'
VERT: 1" = 5'

GRAPHIC SCALES

HORIZ. 1 inch = 20 feet

VERT. 1 inch = 5 feet

24" WATER MAIN PLAN - PROFILE
STA. 95+00 TO STA. 100+00

DRAWING: C1.26

SHEET: 26