


AS-BUILT



GRAPHIC SCALE

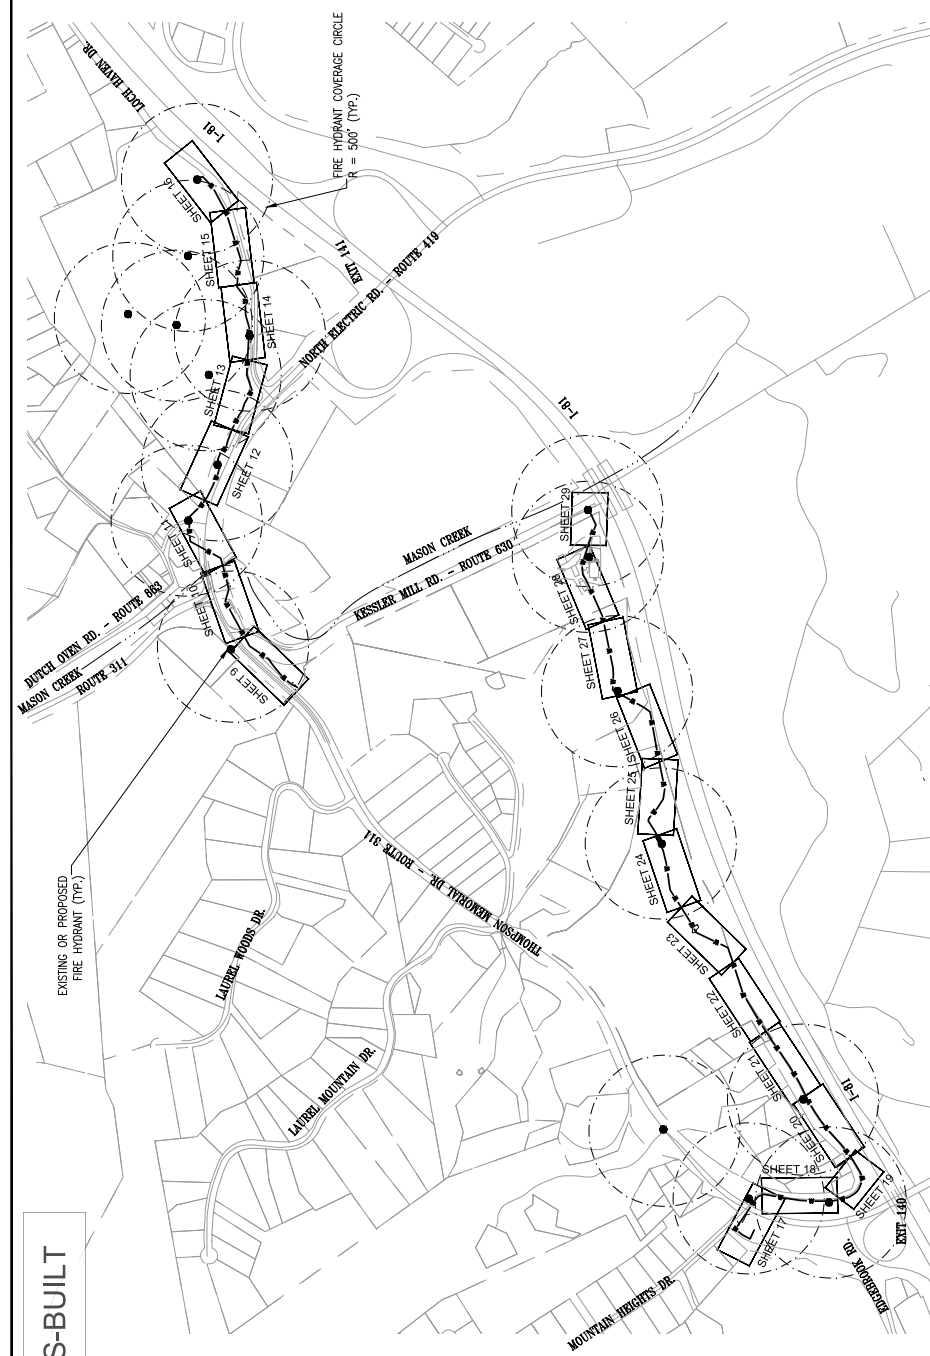

	WESTERN VIRGINIA WATER AUTHORITY 601 South Jefferson Street, Suite 300 Roanoke, Virginia 24011		DES. BY DRAWN BY CHECKED BY DATE	SCALE: AS SHOWN HORIZ. 1" = 300' VERT. 1" = 30'	NORTH LOOP WATER MAIN EXTENSION THOMPSON MEMORIAL DRIVE TO KESSLER MILL ROAD		REV. DATE DESCRIPTION
	SHEET 29 OF 29		DATE: 07/24/23	DATE: 07/24/23	SHEET LAYOUT & FIRE HYDRANT COVERAGE MAP		8