
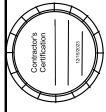
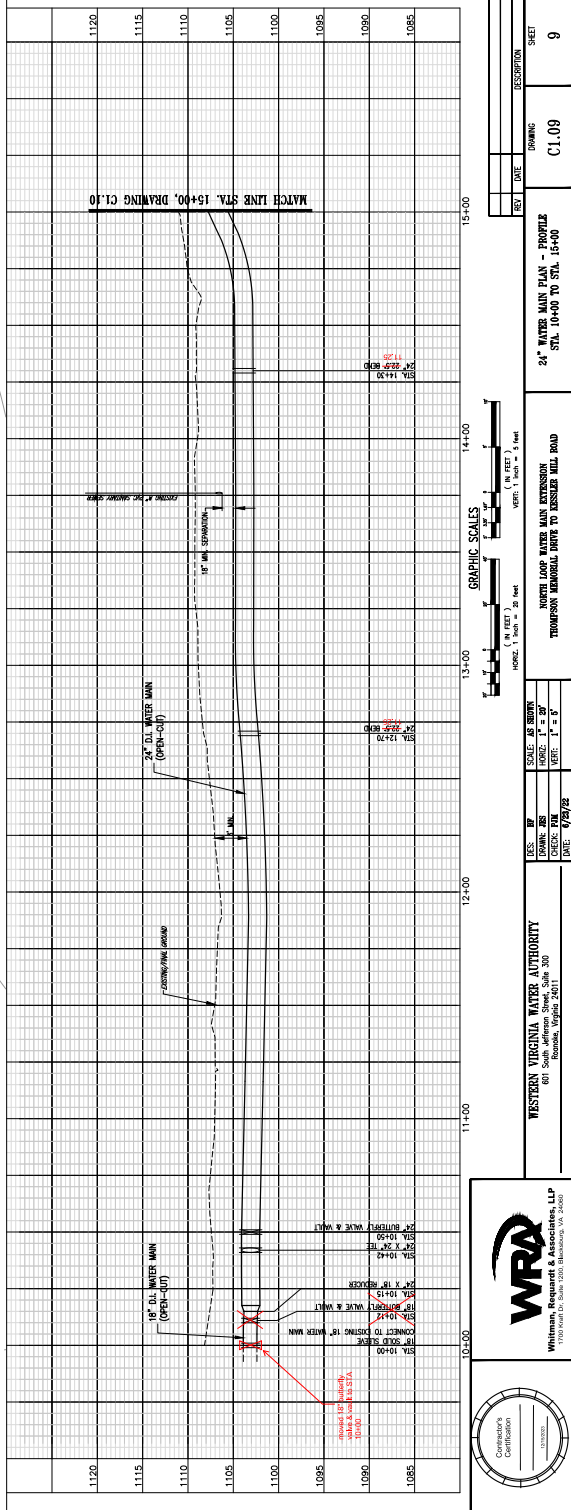


AS-BUILT

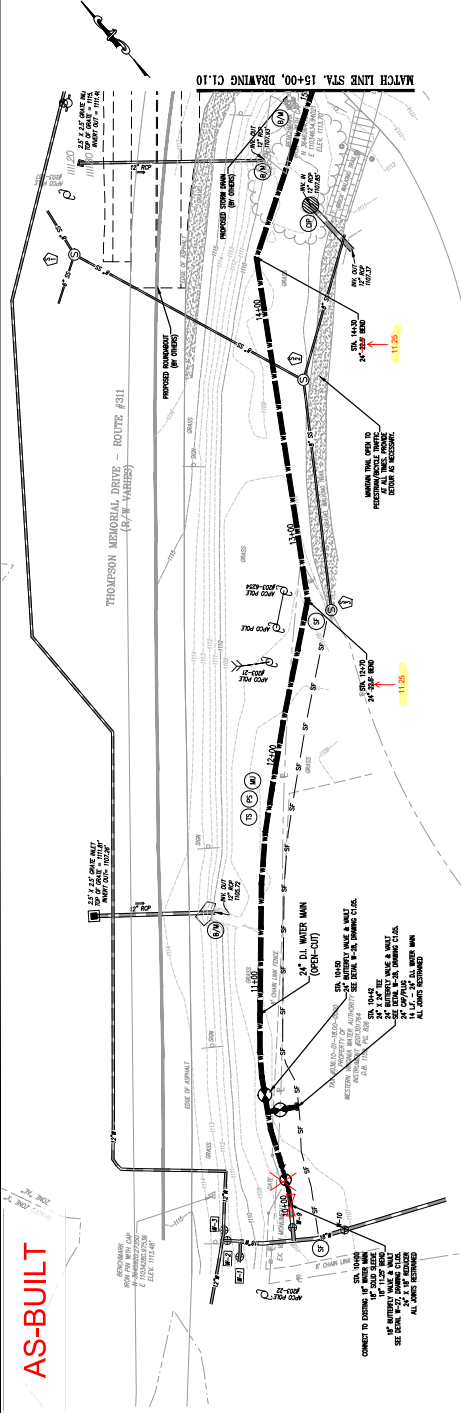

Western Virginia Water Authority
601 South Jefferson Street, Suite 300
Roanoke, Virginia 24011
11000 North Dr. Suite 1000, Blacksburg, VA 24060

DES. BY
DRAWN BY
CHECKED BY
DATE

SCALE: AS SHOWN
HORIZ. 1" = 50'
VERT. 1" = 5'

GRAPHIC SCALES
HORIZ. 1" = 50'
VERT. 1" = 5'

24" WATER MAIN PLAN - PROFILE
STA. 10+00 TO STA. 15+00

C1.09
C1.09
C1.09

9