



AS-BUILT



- NOTES:
1. UNLESS OTHERWISE SHOWN, ALL INSTALLATION SHALL BE IN ACCORDANCE WITH SPECIFICATION SECTION 02200 - JOINTS AND JOINTS.
 2. THE CONTRACTOR SHALL SUBMIT A DETAILED EXCAVATION SHAPING AND JOINTS SECTION DETAIL FOR REVIEW AND APPROVAL BY THE ENGINEER PRIOR TO CONSTRUCTION. THE DETAIL SHALL SHOW THE EXCAVATION SHAPING AND JOINTS SECTION DETAIL FOR REVIEW AND APPROVAL BY THE ENGINEER PRIOR TO CONSTRUCTION. THE DETAIL SHALL SHOW THE EXCAVATION SHAPING AND JOINTS SECTION DETAIL FOR REVIEW AND APPROVAL BY THE ENGINEER PRIOR TO CONSTRUCTION.
 3. TEMPORARY SHORING SHALL BE DESIGNED TO MAINTAIN A MINIMUM DEFLECTION NO GREATER THAN 2.0 INCHES ON 10' OF THE HEIGHT OF THE WALL THROUGHOUT ITS LIFE.

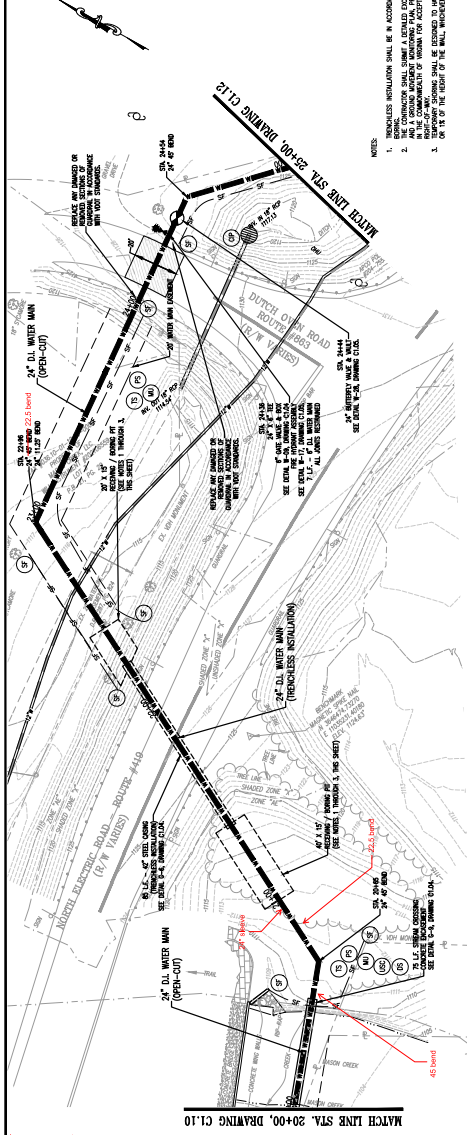

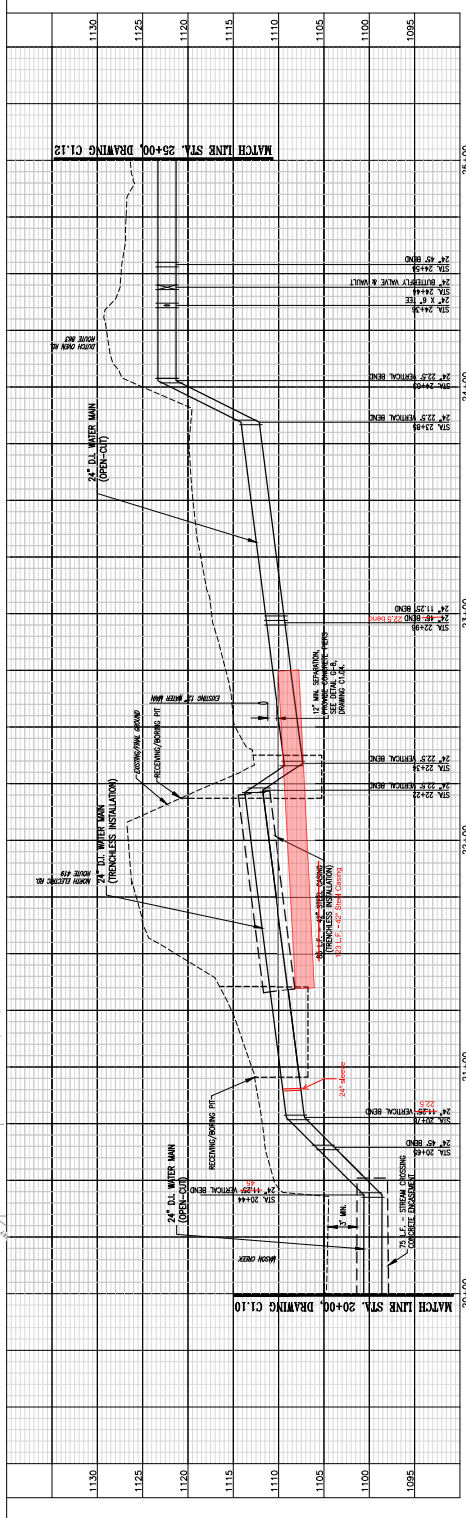

Western Virginia Water Authority
601 South Jefferson Street, Suite 300
Roanoke, Virginia 24011

DES. BY: [Redacted]
DRAWN BY: [Redacted]
CHECKED BY: [Redacted]
DATE: 6/28/23

SCALE: AS SHOWN
HORIZ. 1" = 50'
VERT. 1" = 5'

GRAPHIC SCALES
HORIZ. 1" = 20 feet
VERT. 1" = 5 feet

24" WATER MAIN PLAN - PROFILE
STA. 20+00 TO STA. 25+00

FORMING: C1.11
DATE: [Redacted]
SHEET: 11