
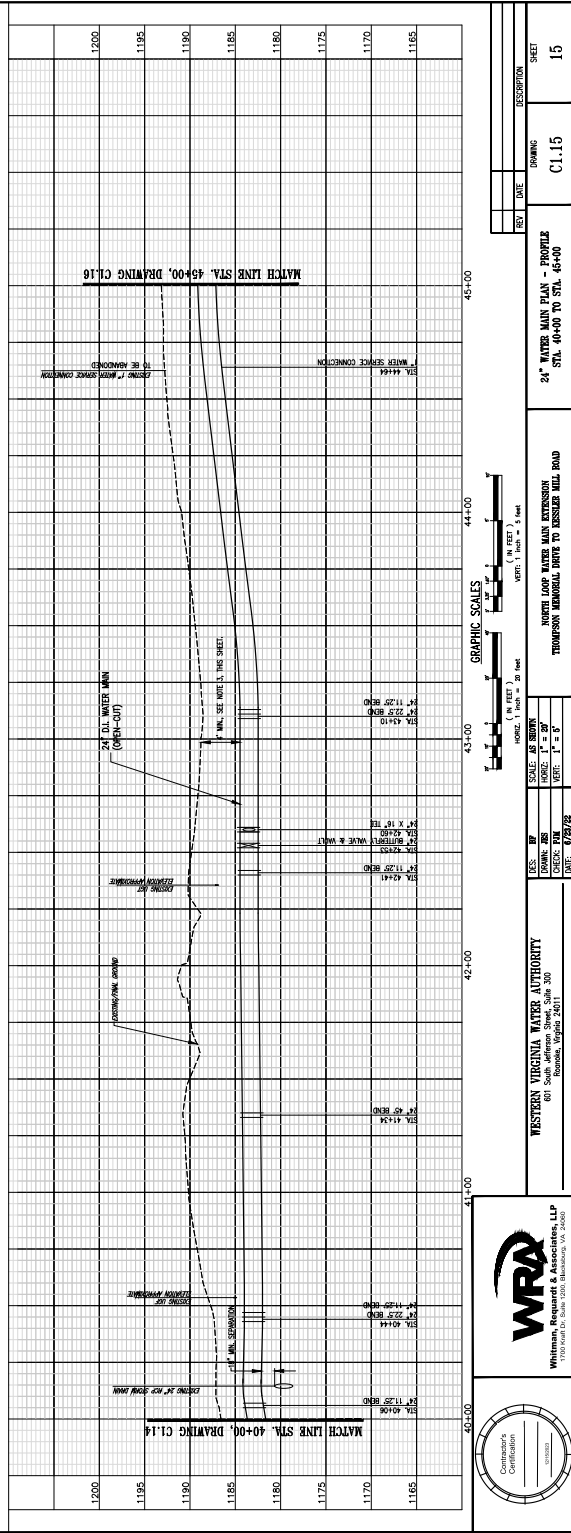


AS-BUILT

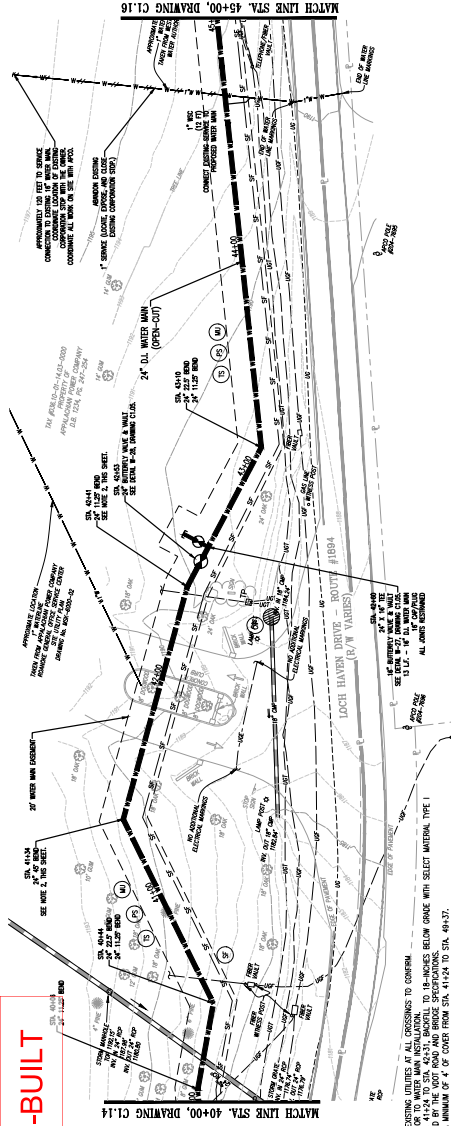

WESTERN VIRGINIA WATER AUTHORITY
601 South Jefferson Street, Suite 300
Roanoke, Virginia 24011
DESIGNED BY: J. BECKWITH
CHECKED BY: J. BECKWITH
DATE: 02/28/23

SCALE: AS SHOWN
HORIZONTAL: 1" = 50'
VERTICAL: 1" = 5'
GRAPHIC SCALES
HORIZONTAL: 1" = 50'
VERTICAL: 1" = 5'

24" WATER MAIN PLAN - PROFILE
STA. 40+00 TO STA. 45+00
DRAWING: C1.15
SHEET: 15