

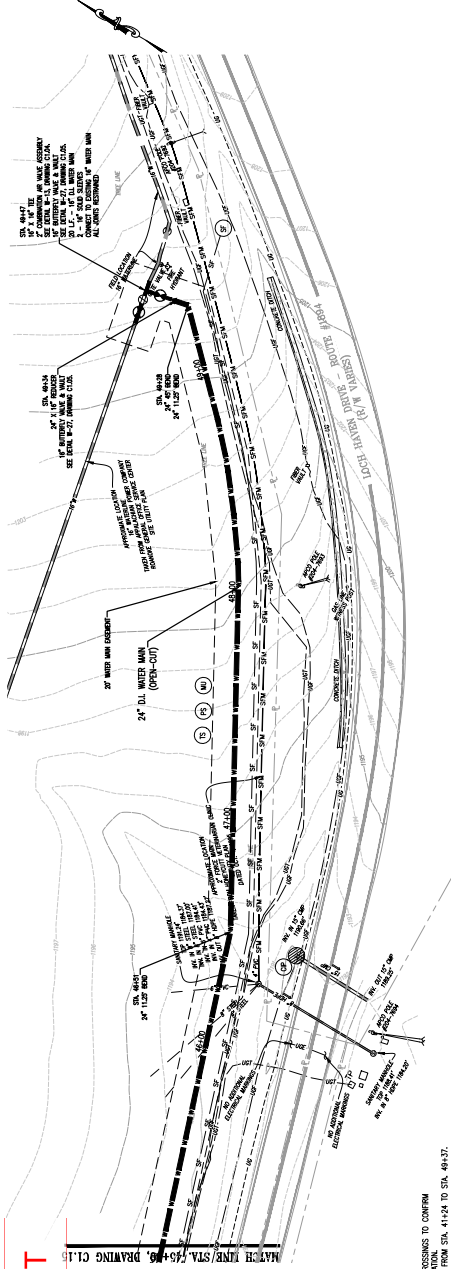


AS-BUILT

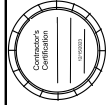

- NOTE:
1. TEST PER EXISTING UTILITIES AT ALL CROSSINGS TO CONFIRM.
 2. PROVIDE A MINIMUM OF 4' OF COVER FROM STA. 41+24 TO STA. 49+37.

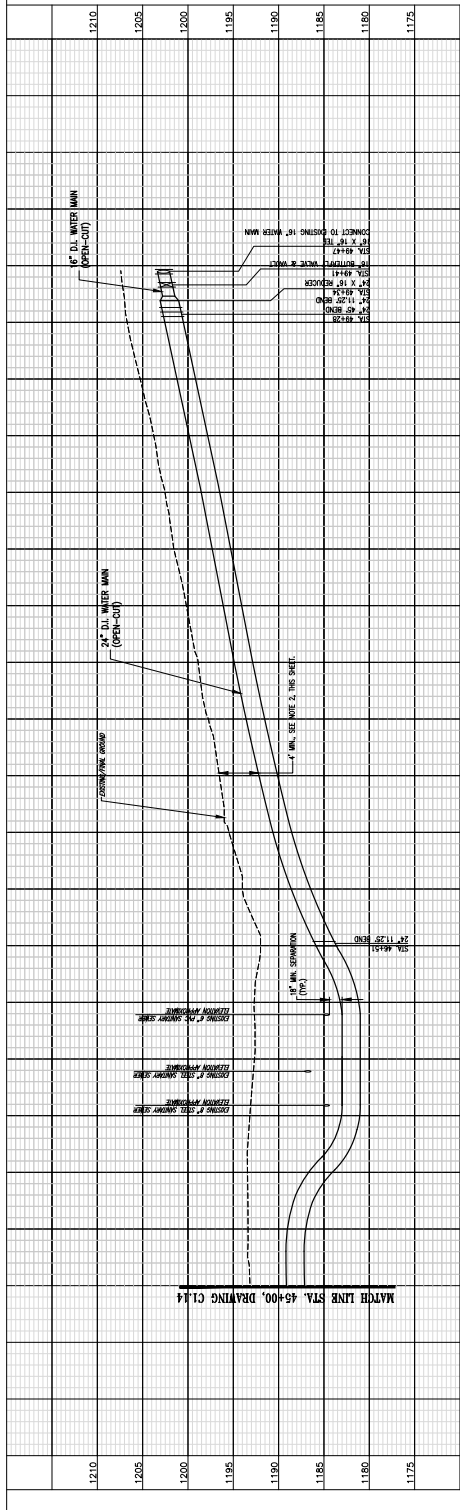

William S. Smith & Associates, LLP
17029 North Dixie Road, Suite 100, Blacksburg, VA 24060

WESTERN VIRGINIA WATER AUTHORITY
601 South Jefferson Street, Suite 300
Roanoke, Virginia 24011

DES. BY
DRAWN BY
CHECKED BY
DATE: 6/26/23

SCALE: AS SHOWN
HORIZ: 1" = 50'
VERT: 1" = 5'

NORTH LOOP WATER MAIN EXTENSION
THOMPSON MEMORIAL DRIVE TO KESSLER HILL ROAD

24" WATER MAIN PLAN - PROFILE
STA. 45+00 TO STA. 49+47

DRAWING
C1.16

SHEET
16