
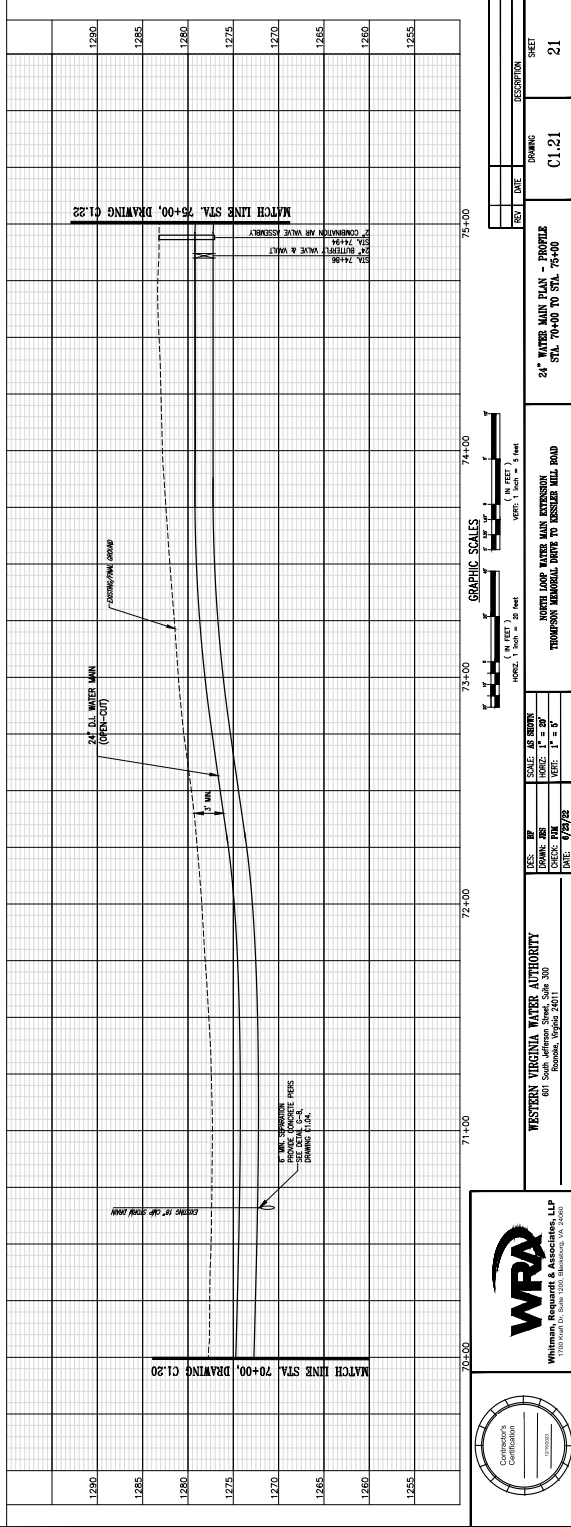


AS-BUILT

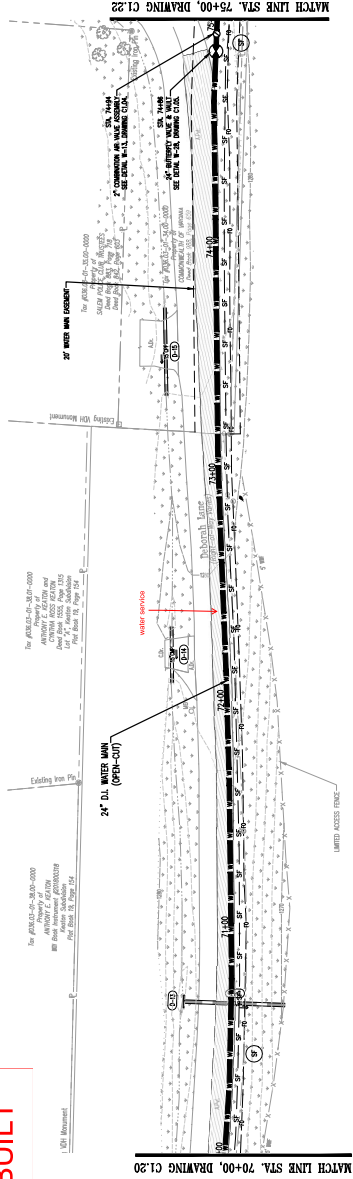

Western Virginia Water Authority
601 South Jefferson Street, Suite 300
Roanoke, Virginia 24011

DES. BY
DRAWN BY
CHECKED BY
DATE

SCALE: AS SHOWN
HORIZ. 1" = 50'
VERT. 1" = 5'

GRAPHIC SCALES
HORIZ. 1" = 50'
VERT. 1" = 5'

24" WATER MAIN PLAN - PROFILE
STA. 70+00 TO STA. 75+00

C1.21

21